IREDELL COUNTY HEALTH DEPARTMENT

STATESVILLE 704-878-5305 MOORESVILLE 704-664-5281

IMPROVEMENT PERMIT / AUTHORIZATION TO CONSTRUCT / OPERATION PERMIT / EXISTING SYSTEM INSPECTION

PERMIT# 125418 PIN# 4709-64-8842 DATE 12/23/04

OWNER OR CONTRACTOR ADVANTAGE ELECTRIC & BLDG, INC PHONE: Business (704) 872-3022 Home

ADDRESS PO BOX 5127 STATESVILLE NC 28687

LOCATION HWY 115 N TL PISGAH TR BOWLES FARM TL HILL FARM TR PISGAH RIDGE DRIVEWAY ON LEFT

SUBDIVISION BLOCK / SECTION LOT LOT AREA 5.527 SITE CLASS. PS DESIGN FLOW 360 L.T.A.R. 0.25 gpd/Ft²

Septic Tank: 1000 Gallons; STB 1012 Date 7-17-04
Pump Tank: Gallons; PT Date
Pump Make: Model Serial No.
Nitrification Field: No Fields 1 Square Feet 1440 Linear Feet 480
No Lines 4 Trench Width 36" Max Trench Bottom Depth 28" Gravel Depth 12"

☑ New System ☐ Repair System Type: I, (II), III, IV, V, VI
System Description: CONVENTIONAL GRAVITY
Repair System Description: CONVENTIONAL GRAVITY
Maintenance Agreement Required: ☐ Yes ☑ No


☑ House/Mod. Home No. Bedrooms 3
☐ Mobile Home No. Bathrooms
☐ Business No. Employees
☐ Other
☐ Slab ☐ Crawl Space ☑ Basement w/plumbing ☐ Basement wo/plumbing

Water Supply: ☑ Individual ☐ Public ☐ Community

Comments/Conditions: ① INSTALL LINES 28" ON CONTOUR ② MAINTAIN SETBACKS ③ GRADE OFF BERMS ABOVE SYSTEM


Comments/Conditions ① TUFF-TITE FILTER ② #5 STONE

INITIAL SITE SKETCH

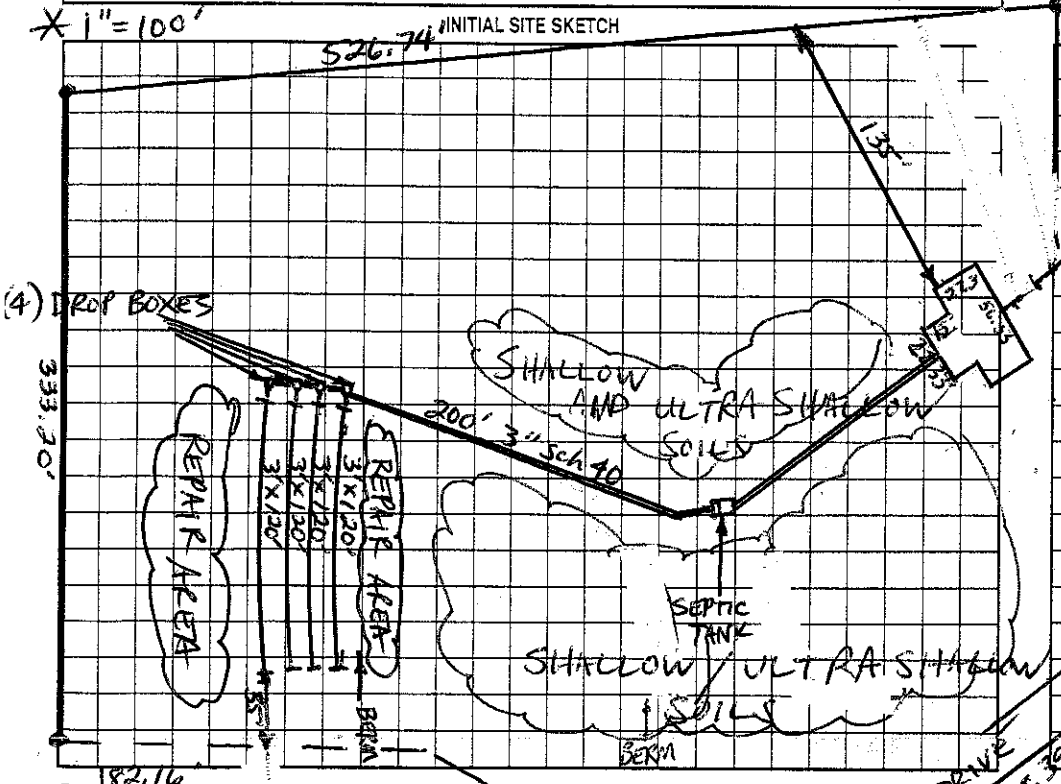

AS BUILT SKETCH

SYSTEM INSTALLED ACCORDING TO SITE SKETCH

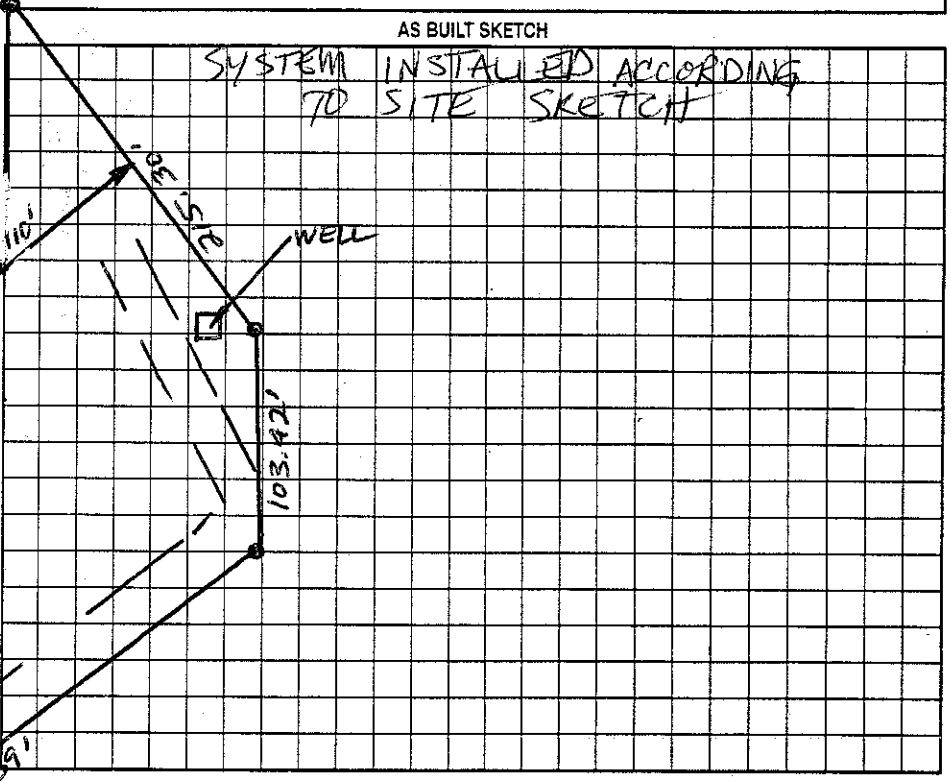

Permit can be suspended or revoked if any false information is supplied toward securing the permit/any unauthorized changes are made to the site/any unauthorized changes are made in the installation of the system. Improvement Permit with plat valid without expiration. Improvement Permit with site plan valid for sixty months. Authorization to Construct is valid for a period equal to that of Improvement Permit – not to exceed sixty months.

Signed: date 12-28-04 Installed by: C & S GRADING

Improvement Permit by: Christopher M. Shell LRS, LSS date 12-23-04 Operation Permit by: Christopher M. Shell LRS, LSS date 1-27-05

Authorization to Construct by: Christopher M. Shell LRS, LSS date 12-28-04 Existing System Inspection by: date

HEALTH DEPT. COPY: WHITE OWNER COPY (FINAL): YELLOW OWNER COPY (INITIAL): PINK