IREDELL COUNTY HEALTH DEPARTMENT

STATESVILLE 704-878-5305 MOORESVILLE 704-664-5281

IMPROVEMENT PERMIT / AUTHORIZATION TO CONSTRUCT / OPERATION PERMIT / EXISTING SYSTEM INSPECTION

PERMIT# Repair PIN# DATE 3-5-98

OWNER OR CONTRACTOR Johnny Brown PHONE: Business Home 876-0633

ADDRESS Box 454 ~~Piggott Ridge Circle Statesville~~ Hill Farm Hiddenite

LOCATION 115N TL Piggott Ch RR TR Hill Farm Rd House at Y in Road

SUBDIVISION BLOCK / SECTION LOT LOT AREA SITE CLASS. P/S DESIGN FLOW 240 L.T.A.R. .03

Septic Tank: 1000 Gallons; STB Date

Pump Tank: Gallons; PT Date

Pump Make: Model Serial No.

Nitrification Field: No Fields 1 Square Feet 800 Linear Feet 270

No Lines 4 Trench Width 36in Max Trench Bottom Depth 36in Gravel Depth 12in

☐ New System ☒ Repair System Type: I (II) III, IV, V, VI

System Description:

Repair System Description: Gravity Conventional

Maintenance Agreement Required: ☐ Yes ☐ No

☒ House/Mod. Home No. Bedrooms 2

☐ Mobile Home No. Bathrooms 1

☐ Business No. Employees

☐ Other


☐ Slab ☐ Crawl Space ☒ Basement w/plumbing ☐ Basement wo/plumbing

Water Supply: ☒ Individual ☐ Public ☐ Community


Comments:/Conditions: Keep Lines on contour, 9ft on center Tie Sinkdrain, washing machine into tank Check Tank and sanitary T replace T if needed, landscape to allow water to run off system

Comments:/Conditions: Washer

INITIAL SITE SKETCH

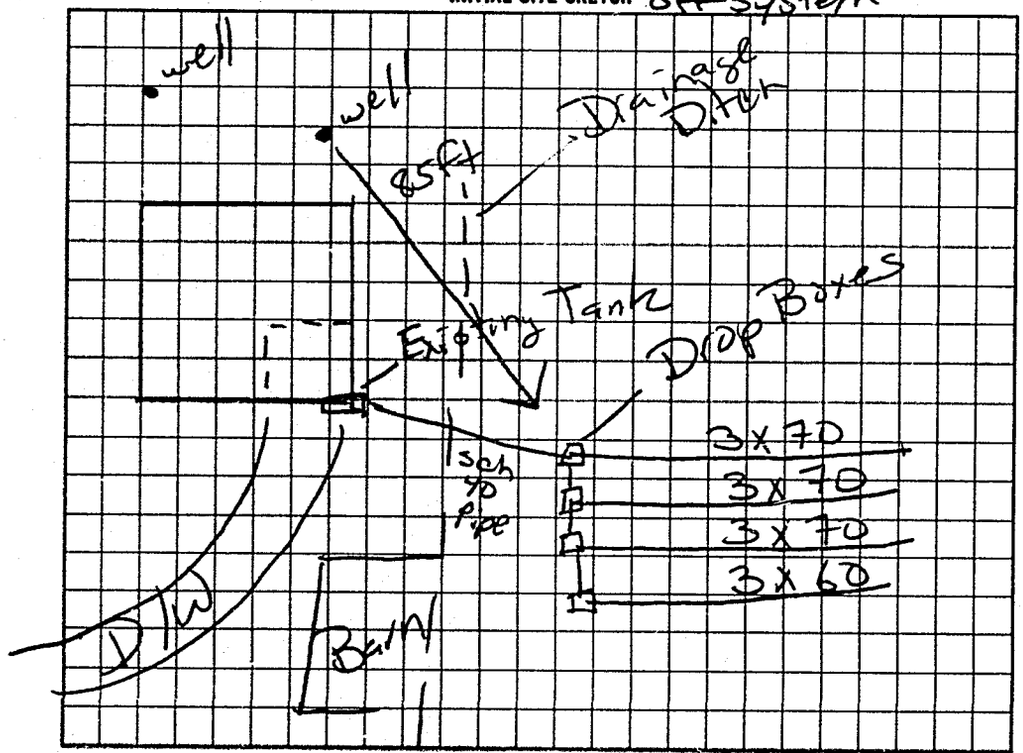

AS BUILT SKETCH

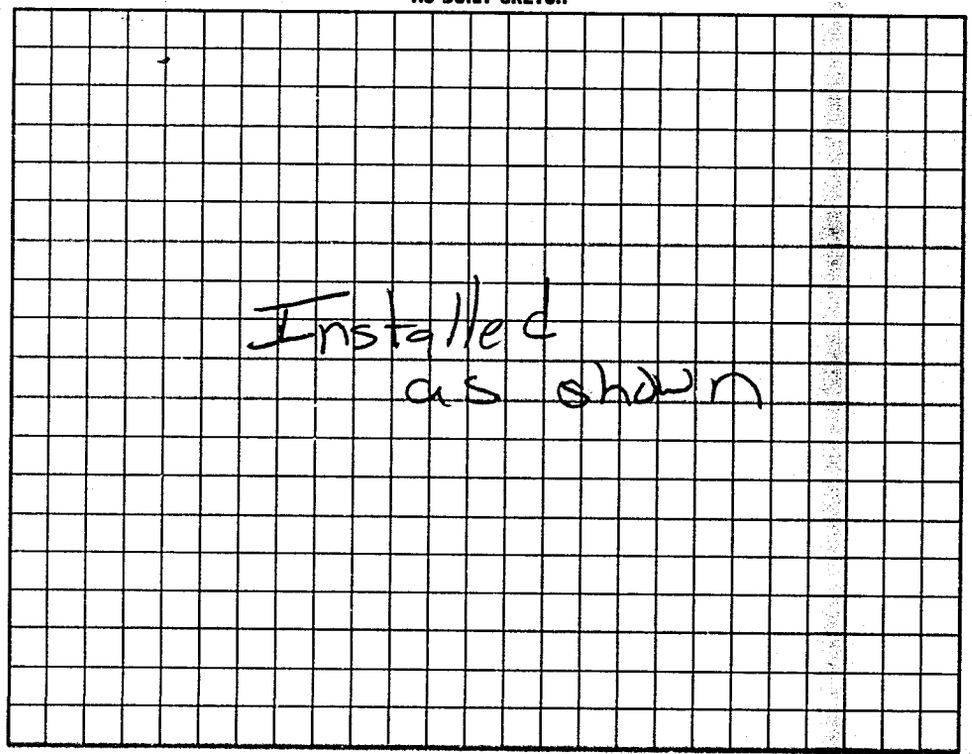

I understand that this permit can be suspended or revoked if any false information is supplied toward securing the permit/any unauthorized changes are made to the site/any unauthorized changes are made in the installation of the system. Improvement Permit with plat valid without expiration. Improvement Permit with site plan valid for sixty months. Authorization to Construct is valid for a period equal to that of Improvement Permit – not to exceed sixty months.

Signed: Johnny Brown date

Improvement Permit by: Mark C Orf RS date 3-5-98

Authorization to Construct by: Mark C Orf RS date 3-5-98

Installed by: Kenny Pearson

Operation Permit by: Mark C Orf RS date 3-26-98

Existing System Inspection by: date

HEALTH DEPT. COPY: WHITE INSPECTION COPY (FINAL): GREEN OWNER COPY (FINAL): YELLOW INSPECTION COPY (INITIAL): PINK OWNER COPY (INITIAL): GOLD