IREDELL COUNTY HEALTH DEPARTMENT

STATESVILLE 704-878-5305 MOORESVILLE 704-664-5281

IMPROVEMENT PERMIT / AUTHORIZATION TO CONSTRUCT / OPERATION PERMIT / EXISTING SYSTEM INSPECTION

PERMIT# 094593 PIN# 4709 800 318 DATE 4/27/01

OWNER OR CONTRACTOR Steven Rhyne PHONE: Business — Home (704) 896-3343

ADDRESS 880 Pisgah Rock Stony Point N.C. 28678

LOCATION 115 N, (L) Pisgah Ch. Rd., 2 4miles, 2nd on (R) after Pleasant Grove Baptist Church

SUBDIVISION — BLOCK / SECTION — LOT — LOT AREA 1.73 SITE CLASS 05 DESIGN FLOW 360 L.T.A.R. .30

Septic Tank: 4000 Gallons: STB 1007 Date 5-21-01

Pump Tank: — Gallons: PT — Date —

Pump Make: — Model — Serial No. —

Nitrification Field: No Fields — Square Feet 4200 Linear Feet 300

No Lines 4@75' Trench Width 36" Max Trench Bottom Depth 36" Gravel Depth —

X New System ☐ Repair System Type: I. II (III) IV. V. VI

System Description: Gravity 25% Reduction

Repair System Description: Gravity, 25% Reduction

Maintenance Agreement Required: ☐ Yes X No

☐ Slab X Crawl Space ☐ Basement w/plumbing ☐ Basement wo/plumbing

☐ House/Mod. Home No. Bedrooms 3

X Mobile Home No. Bathrooms 1½

☐ Business No. Employees —


☐ Other —

Water Supply: X Individual ☐ Public ☐ Community


Comments/Conditions: ① Keep System 100 Ft from well ② Install Riser on Curtain ③ Use 25% Reduction System of Chamber or NOE 5 Sections.

Comments/Conditions: - Filter Installed in Sanitary Tee - Septic Tank Marker Installed

INITIAL SITE SKETCH Not to Scale

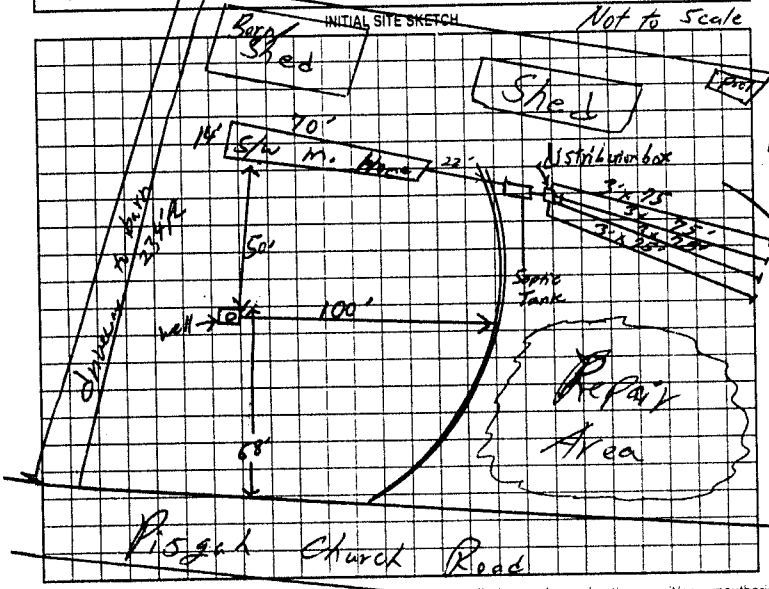

AS BUILT SKETCH

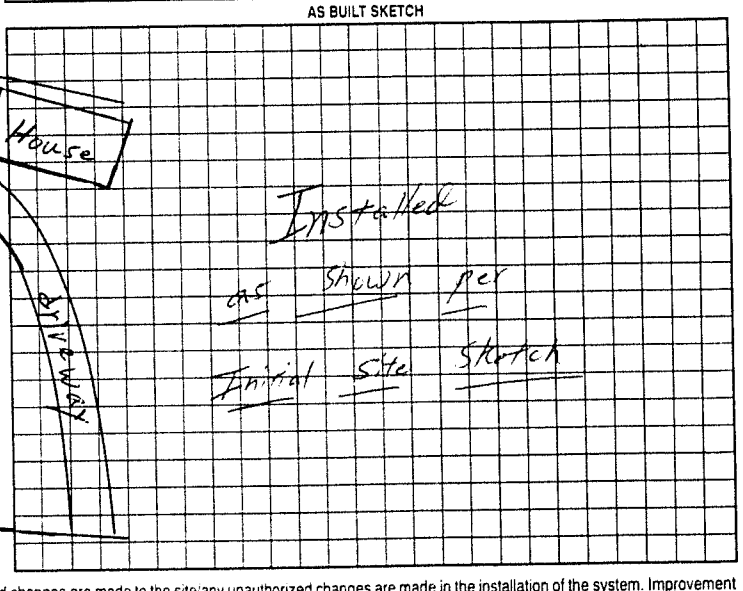

Permit can be suspended or revoked if any false information is supplied toward securing the permit/any unauthorized changes are made to the site/any unauthorized changes are made in the installation of the system. Improvement Permit with plat valid without expiration. Improvement Permit with site plan valid for sixty months. Authorization to Construct is valid for a period equal to that of Improvement Permit – not to exceed sixty months.

Signed: Steven A. Rhyne date 5/9/01

Improvement Permit by: William C. Johnson RSI date 4/27/01

Authorization to Construct by: William C. Johnson RSI date 4/27/01

Installed by: James Hassler

Operation Permit by: William C. Johnson date 7/31/01

Existing System Inspection by: — date —

HEALTH DEPT COPY WHITE OWNER COPY (FINAL) YELLOW OWNER COPY (INITIAL) PINK