IREDELL COUNTY HEALTH DEPARTMENT

STATESVILLE 704-878-5305 MOORESVILLE 704-664-5281

IMPROVEMENT PERMIT / AUTHORIZATION TO CONSTRUCT / OPERATION PERMIT / EXISTING SYSTEM INSPECTION

PERMIT# 082908 PIN# 4709 82 7855 (PT) DATE 7-29-99

OWNER OR CONTRACTOR SHARON PRIVETTE PHONE: Business Home 871-1385

ADDRESS 446 ISLAND FORD ROAD, STATESVILLE NC 28625

LOCATION NC 115 N, TL PISGAH CH. RD, TR HILL FARM ROAD, ON LEFT PAST BOX #380

SUBDIVISION BLOCK / SECTION LOT LOT AREA 1.37 ACRES SITE CLASS PS DESIGN FLOW 360 L.T.A.R. 0.30 GPD/FT²

Septic Tank: 1000 Gallons; STB 1012 Date 10-3-99
Pump Tank: Gallons; PT Date
Pump Make: Model Serial No.
Nitrification Field: No Fields 1 Square Feet EQ. TO 1200 Linear Feet 300+
No Lines FOUR Trench Width 36" Max Trench Bottom Depth 30" Gravel Depth SAND 6"

☑ New System ☐ Repair System Type: I, II, (III), IV, V, VI
System Description: 25% REDUCTION GRAVITY
Repair System Description: CONV. PUMP - FSD
Maintenance Agreement Required: ☐ Yes ☑ No
☐ Slab ☑ Crawl Space ☑ Basement w/plumbing ☐ Basement wo/plumbing


☑ House/Mod. Home No. Bedrooms 3
☐ Mobile Home No. Bathrooms 3
☐ Business No. Employees
☐ Other

Water Supply: ☑ Individual ☐ Public ☐ Community WELL


Comments/Conditions ① KEEP SYSTEM MINIMUM 100 FEET FROM WELL ② INSTALL 25% REDUCTION SYSTEM USING 50 CHAMBERS OR 30 HDS SECTIONS

Comments/Conditions ① SEPTIC TANK W/RISERS INSTALLED USING "POLYLOK" FILTER ② PIPE GUTTER DRAINS AWAY FROM SEPTIC SYSTEM

INITIAL SITE SKETCH

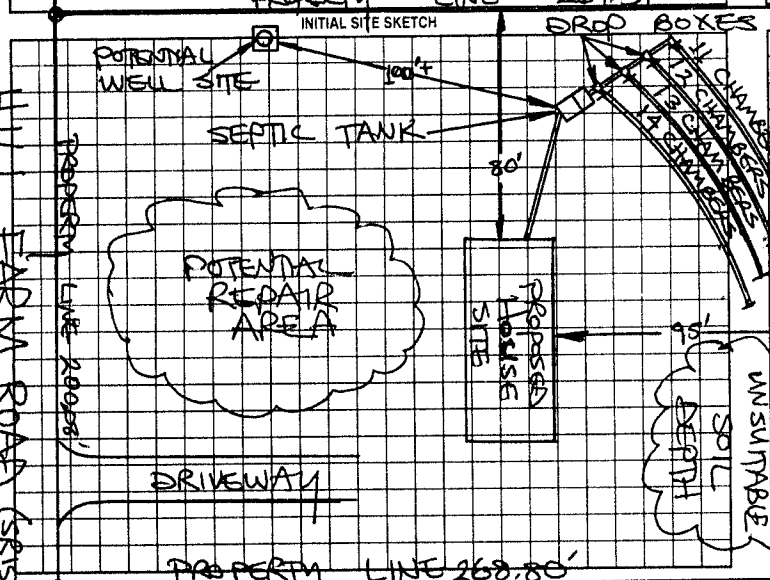

AS BUILT SKETCH

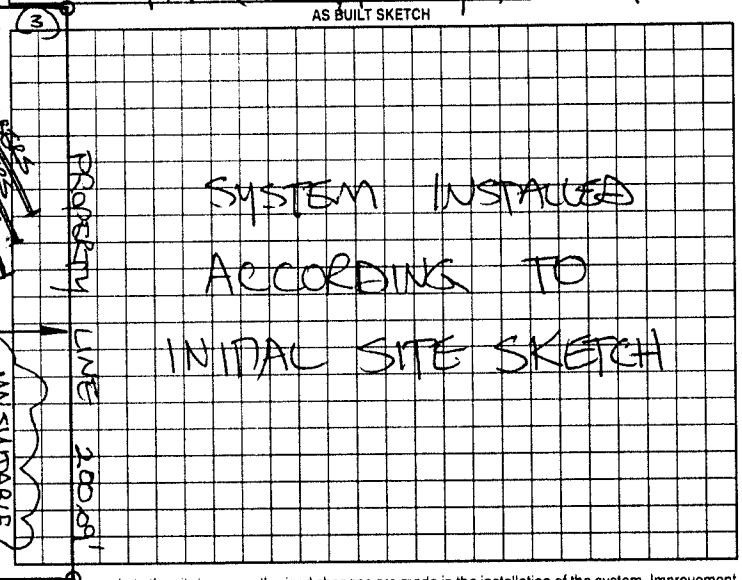

Permit can be suspended or revoked if any false information is supplied toward securing the permit/any unauthorized changes are made to the site/any unauthorized changes are made in the installation of the system. Improvement Permit with plat valid without expiration. Improvement Permit with site plan valid for sixty months. Authorization to Construct is valid for a period equal to that of Improvement Permit – not to exceed sixty months.

Signed: [signature] date 8-3-99 Installed by: STEVE JORDAN

Improvement Permit by: STEVE HEDRICK date 7-29-99 Operation Permit by: STEVE HEDRICK date 1-7-00

Authorization to Construct by: STEVE HEDRICK date 7-29-99 Existing System Inspection by: date

HEALTH DEPT COPY WHITE OWNER COPY (FINAL) YELLOW OWNER COPY (INITIAL) PINK