IREDELL COUNTY HEALTH DEPARTMENT

STATESVILLE 704-878-5305 MOORESVILLE 704-664-5281

IMPROVEMENT PERMIT / CERTIFICATE OF COMPLETION / OPERATION PERMIT / EXISTING SYSTEM INSPECTION

PROPERTY DESCRIPTION NO. 19227 64579 DATE 12-10-96 TAX MAP NO. AE-A-99 (PART OF) Watershed: ☐ Yes ☒ No

OWNER OR CONTRACTOR KENNETH WAYNE WILSON PHONE: Business 872-9571 Home 876-0836

ADDRESS RT. 2, BOX 1871K, HIDDENITE, NC 28636

LOCATION NC115 N, TL PISGAH CH. RD, TR HILL DAIRY RD, TL PISGAH RIDGE CIRCLE BEAR RIGHT, 1ST ON RIGHT

SUBDIVISION _____ BLOCK / SECTION _____ LOT _____ LOT AREA 4.067 ACRE SITE CLASS PS DESIGN FLOW 240 L.T.A.R. 0.30 gpd/ft²

Septic Tank: 1000 Gallons; STB 1012 Date 10.16.98
Pump Tank: _____ Gallons; PT _____ Date _____
Pump Make: _____ Model _____ Serial No. _____
Nitrification Field: No Fields 1 Square Feet 810 Linear Feet 270
No Lines THREE Trench Width 36" Max Trench Bottom Depth 30" Gravel Depth 12"

☒ New System ☐ Repair System Type: I II III IV V VI
System Description: CONV. GRAVITY
Repair System Description: CONV.
Maintenance Agreement Required: ☐ Yes ☒ No
☐ Slab ☒ Crawl Space ☐ Basement w/plumbing ☐ Basement wo/plumbing


☒ House/Mod. Home No. Bedrooms 2
☐ Mobile Home No. Bathrooms 1
☐ Business No. Employees ____
☐ Other _____

Water Supply:
☐ Individual
☐ Community
☒ Public
WELL

Comments: ① KEEP SYSTEM MINIMUM 100' FROM WELL
② INSTALL LINES ON CONTOUR AS FLAGGED, NO DEEPER THAN 30", 9' MINIMUM ON CENTER.

Comments:

INITIAL SITE SKETCH

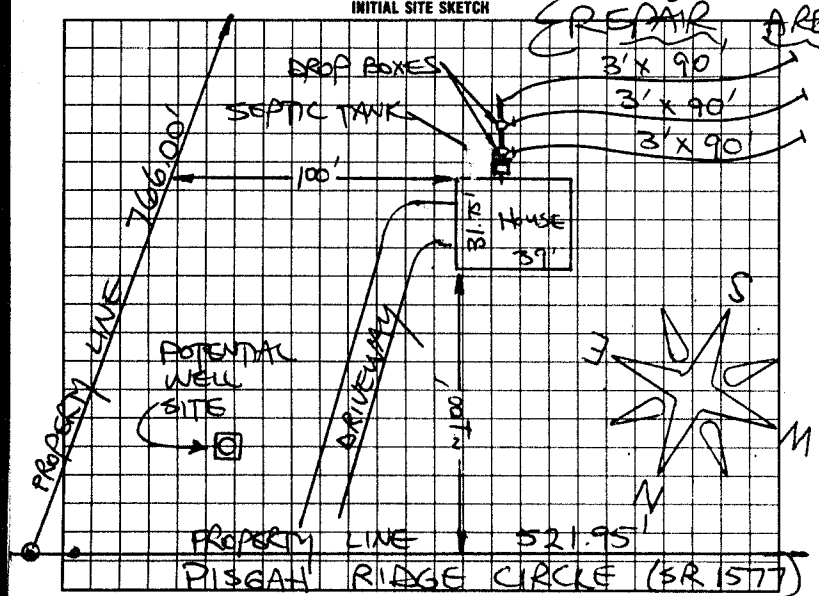

AS BUILT SKETCH

SYSTEM INSTALLED ACCORDING TO INITIAL SITE SKETCH

I understand that this permit can be suspended or revoked if any false information is supplied toward securing the permit/any unauthorized changes are made to the site/any unauthorized changes are made in the installation of the system. Improvement Permit is valid for 60 months from date of issuance. AUTH. TO CONST. IS VALID FOR 60 MONTHS.

Signed: Kenneth Wayne Wilson

Improvement Permit by: STEVE HEDRICK date 12-10-96

AUTH. TO CONST. ~~Existing System Inspection~~ by: STEVE HEDRICK date 12-10-96

Installed by: KENNY PEARSON

Certificate of Completion by: STEVE HEDRICK date 1-12-99

Operation Permit by: _____ date _____

HEALTH DEPT. COPY: WHITE INSPECTION COPY (FINAL): GREEN OWNER COPY (FINAL): YELLOW INSPECTION COPY (INITIAL): PINK OWNER COPY (INITIAL): GOLD