IREDELL COUNTY HEALTH DEPARTMENT

STATESVILLE 704-878-5305 MOORESVILLE 704-664-5281

64476

IMPROVEMENT PERMIT / CERTIFICATE OF COMPLETION / OPERATION PERMIT / EXISTING SYSTEM INSPECTION

PROPERTY DESCRIPTION NO. 24980 DATE 9-20-96 TAX MAP NO. 14E-A-13 Watershed: ☐ Yes ☑ No

OWNER OR CONTRACTOR MARK & ANGELA CHILDERS PHONE: Business _____ Home 876-3937

ADDRESS 716 PISGAH RIDGE CIRCLE HIDDENITE NC 28636

LOCATION NC 115 N, TL PISGAH, TR HILL FARM, TL PISGAH RIDGE CIR, BEAR RIGHT, LOT ON RIGHT ~ 300 FEET

SUBDIVISION _____ BLOCK / SECTION _____ LOT _____ LOT AREA 1.2 ACRES SITE CLASS. PS DESIGN FLOW 360 L.T.A.R. 0.30 GPD/FT²

Septic Tank: 1000 Gallons; STB 1007 Date 11-15-95

Pump Tank: _____ Gallons; PT _____ Date _____

Pump Make: _____ Model _____ Serial No. _____

Nitrification Field: No Fields 1 Square Feet 1200 Linear Feet 400

No Lines FOUR Trench Width 36" Max Trench Bottom Depth 30 Gravel Depth 12"

☑ New System ☐ Repair System Type: I, II, III, IV, V, VI

System Description: CONV. GRAVITY

Repair System Description: CONV. PUMP

Maintenance Agreement Required: ☐ Yes ☑ No

☐ House/Mod. Home No. Bedrooms 3

☑ Mobile Home No. Bathrooms 2

☐ Business No. Employees _____

☐ Other _____


☐ Slab ☑ Crawl Space ☐ Basement w/plumbing ☐ Basement wo/plumbing

Water Supply: ☑ Individual ☐ Community ☐ Public WELL


Comments: KEEP SYSTEM MINIMUM 100' FROM WELL

Comments:

INITIAL SITE SKETCH

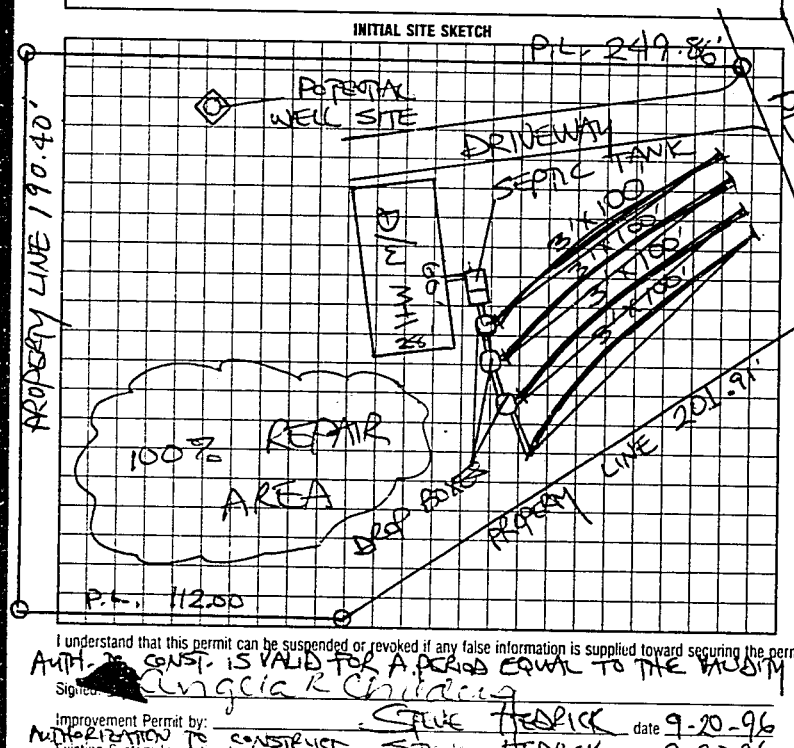

AS BUILT SKETCH

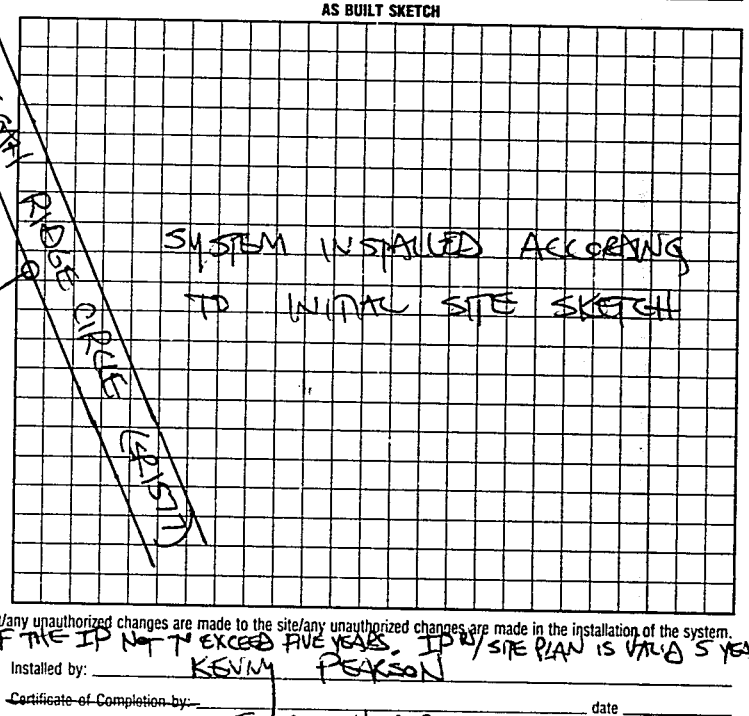

I understand that this permit can be suspended or revoked if any false information is supplied toward securing the permit/any unauthorized changes are made to the site/any unauthorized changes are made in the installation of the system.

AUTH. TO CONST. IS VALID FOR A PERIOD EQUAL TO THE VALIDITY OF THE IP NOT TO EXCEED FIVE YEARS. IP W/ SITE PLAN IS VALID 5 YEARS.

Signed: Angela R Childers

Improvement Permit by: STEVE HEDRICK date 9-20-96

AUTHORIZATION TO CONSTRUCT

Existing System Inspection by: STEVE HEDRICK date 9-20-96

Installed by: KENNY PEARSON

Certificate of Completion by: _____ date _____

Operation Permit by: STEVE HEDRICK date 1-21-97

HEALTH DEPT. COPY: WHITE INSPECTION COPY (FINAL): GREEN OWNER COPY (FINAL): YELLOW INSPECTION COPY (INITIAL): PINK OWNER COPY (INITIAL): GOLD