IREDELL COUNTY HEALTH DEPARTMENT

STATESVILLE 704-878-5305 MOORESVILLE 704-664-5281

IMPROVEMENT PERMIT / AUTHORIZATION TO CONSTRUCT / OPERATION PERMIT / EXISTING SYSTEM INSPECTION

(C)

PERMIT# 106220 PIN# 4709-89-3149 DATE 5-16-02

OWNER OR CONTRACTOR TONY & SUSAN KEY PHONE Business Home 770-565-4622

ADDRESS 4838 HAMPTON LAKE DR., MARIETTA, GA 30068

LOCATION NC 115 N, TL DAMASCUS CH. RD, TL LAUREL CREEK RD, ON RIGHT AT BOX # 227

SUBDIVISION BLOCK / SECTION LOT LOT AREA 29.021 ACRES SITE CLASS PS DESIGN FLOW 600 L.T.A.R. 0.30 GPD/FT²

NEW

Septic Tank: 1000 Gallons; STB 1012 Date 4-8-02 | ☑ New System ☐ Repair System Type: I II III IV V VI | ☐ House/Mod. Home No. Bedrooms 5 | Water Supply: ☑ Individual ☐ Public ☐ Community

Pump Tank: Gallons; PT Date | System Description: CONVENTIONAL GRAVITY | ☐ Mobile Home No. Bathrooms

Pump Make: Model EQ. T Serial No 100 | Repair System Description: CONV. GRAVITY | ☐ Business No. Employees


Nitrification Field: No Fields 1 Square Feet 400 Linear Feet ~~133~~ | Maintenance Agreement Required: ☐ Yes ☑ No | ☐ Other

No Lines ONE Trench Width 36" Max Trench Bottom Depth 36" Gravel Depth 12" | ☐ Slab ☑ Crawl Space ☐ Basement w/plumbing ☐ Basement wo/plumbing | WELL


Comments/Conditions: ① INSTALL NEW 1000 GALLON SEPTIC TANK IN SERIES WITH EXISTING TANK AS SHOWN, ② REPLACE EXISTING DISTRIBUTION BOX IF NECESSARY

Comments/Conditions: SEPTIC TANK WITH RISERS & MARKER INSTALLED USING "THETTE" FILTER

INITIAL SITE SKETCH

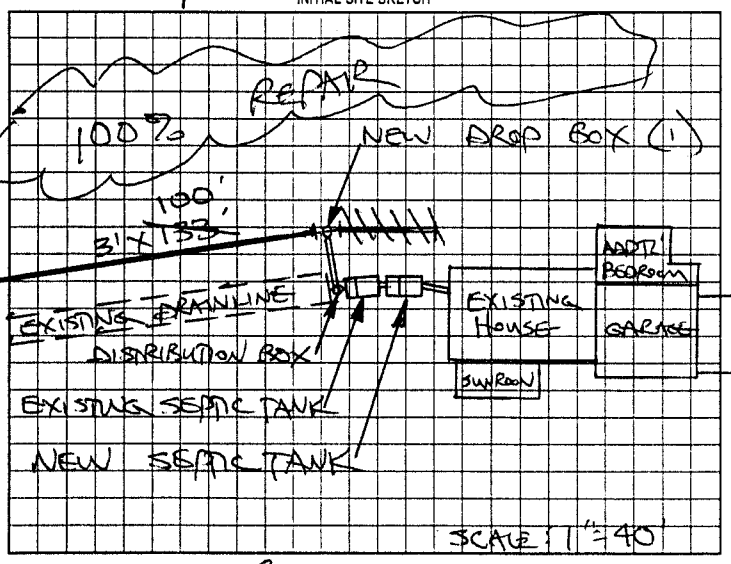

AS BUILT SKETCH

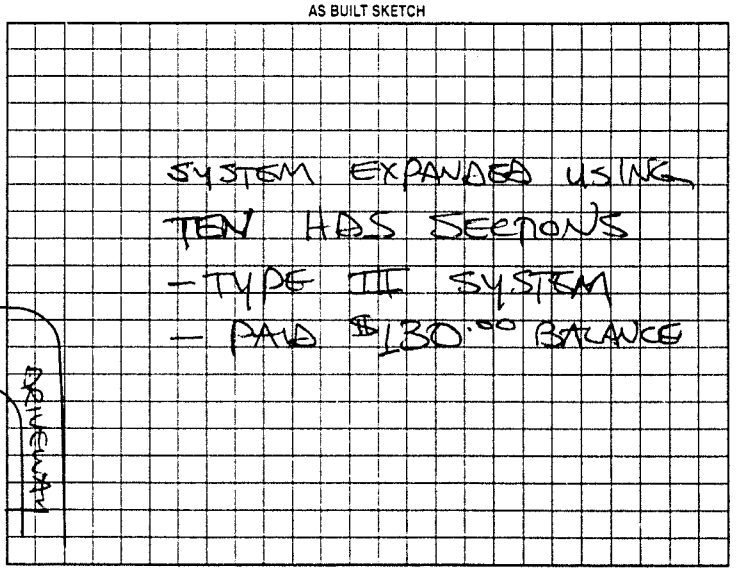

Permit can be suspended or revoked if any false information is supplied toward securing the permit/any unauthorized changes are made to the site/ any unauthorized changes are made in the installation of the system. Improvement Permit with plat valid without expiration. Improvement Permit with site plan valid for sixty months. Authorization to Construct is valid for a period equal to that of Improvement Permit - not to exceed sixty months

Signed: _____ date 5/16/02 Installed by TOMMY FRYE

Improvement Permit by: STEVE HENDRICK date 5-16-02 Operation Permit by STEVE HENDRICK date 10-1-02

Authorization to Construct by: STEVE HENDRICK date 5-16-02 Existing System Inspection by: _____ date _____

HEALTH DEPT COPY: WHITE OWNER COPY (FINAL): YELLOW OWNER COPY (INITIAL): PINK