IREDELL COUNTY HEALTH DEPARTMENT

STATESVILLE 704-878-5305 (C1) MOORESVILLE 704-664-5281

IMPROVEMENT PERMIT / AUTHORIZATION TO CONSTRUCT / OPERATION PERMIT / EXISTING SYSTEM INSPECTION

(C) PERMIT# 112109 PIN# 4709-99-3481 898644 DATE 5-19-03

OWNER OR CONTRACTOR LISA WILLIAMS PHONE: Business Home 704-528-5285

ADDRESS 373 HEMLOCK ROAD, CLEVELAND, NC 27013

LOCATION NC 115 NORTH TL DAMASCUS CHURCH ROAD, TL LAUREL CREEK RD, 0.5 MILE ON LEFT

SUBDIVISION BLOCK / SECTION LOT LOT AREA ~3 ACRES 3.413 ACRES SITE CLASS. PS DESIGN FLOW 360 L.T.A.R. 0.4 GPD/FT²

Septic Tank: 1000 Gallons; STB Date

Pump Tank: Gallons; PT Date

Pump Make: Model Serial No. 225

Nitrification Field No Fields 1 Square Feet 900 Linear Feet ~~300~~

No Lines ~~FIVE~~ FOUR Trench Width 36" Max Trench Bottom Depth 36" Gravel Depth 12"

☑ New System ☐ Repair System Type: I II III IV V

System Description: CONVENTIONAL, GRAVITY

Repair System Description: CONVENTIONAL, GRAVITY

Maintenance Agreement Required: ☐ Yes ☑ No

☐ Reduction ☐ House/Mod. Home No. Bedrooms 3

☐ Mobile Home No. Bathrooms 2

☐ Business No. Employees

☐ Other


☐ Slab ☐ Crawl Space ☐ Basement w/plumbing ☐ Basement wo/plumbing

Water Supply: ☑ Individual ☐ Public ☐ Community WELL


Comments:/Conditions: KEEP SYSTEM MINIMUM 100 FEET FROM WELL.

(C) Comments:/Conditions: AN ACCEPTED SYSTEM WAS INSTALLED (C) SEPTIC TANK WITH MARKED INSTALLED IN LINE "TUFFITE" FILTER

INITIAL SITE SKETCH ~SCALE: 1" = 40'

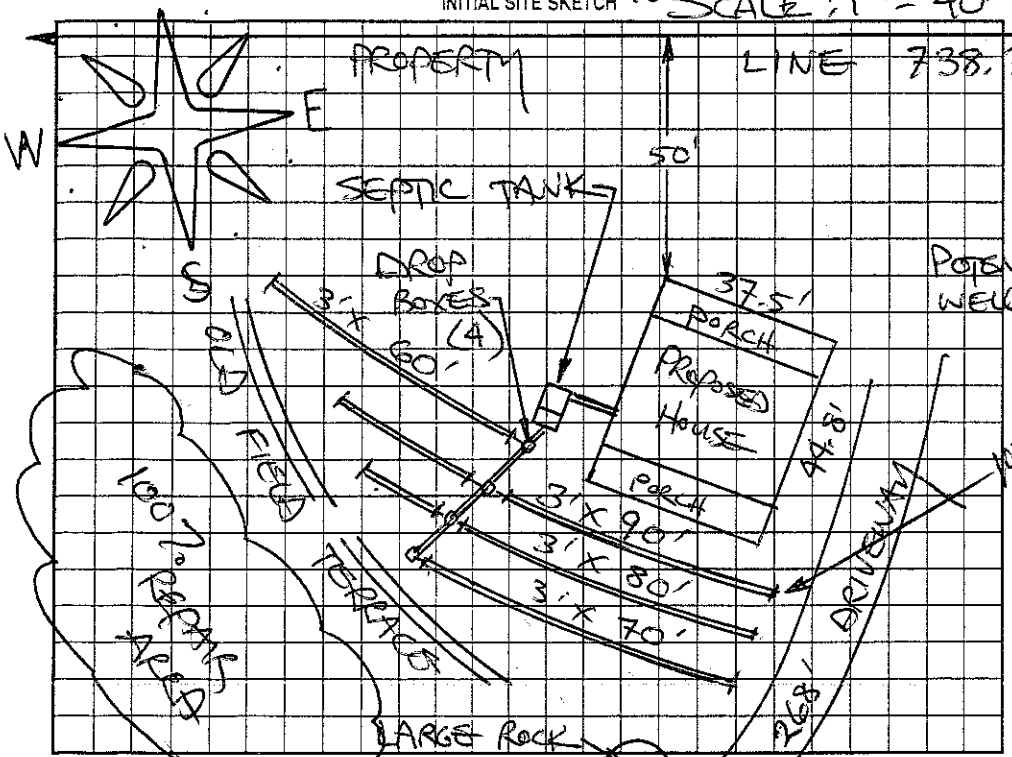

AS BUILT SKETCH

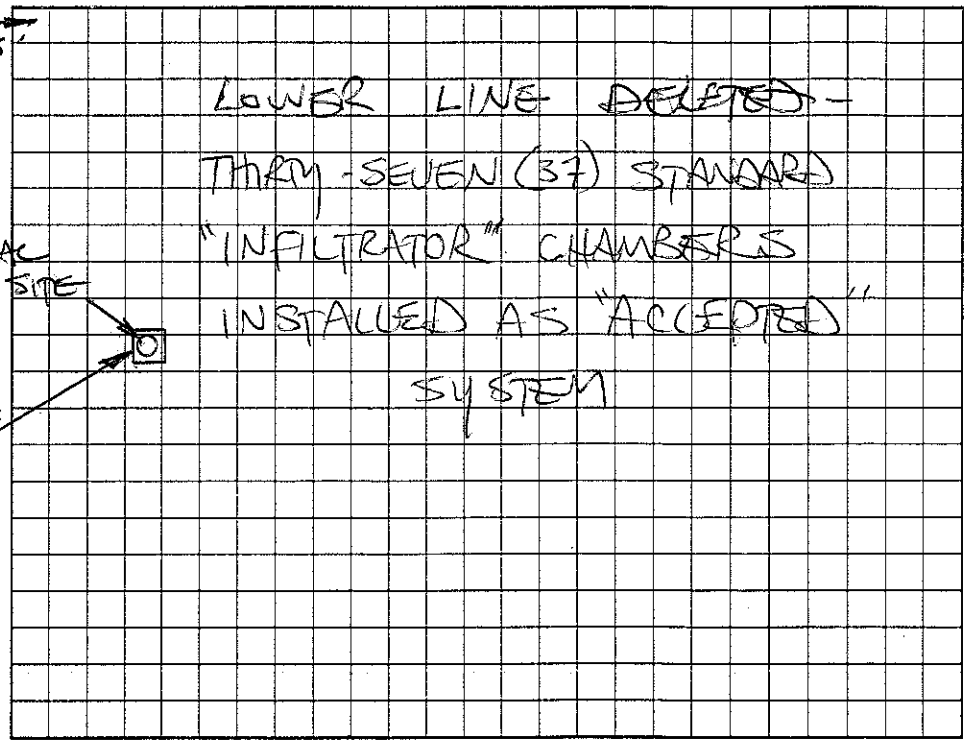

Permit can be suspended or revoked if any false information is supplied toward securing the permit/any unauthorized changes are made to the site/any unauthorized changes are made in the installation of the system. Improvement Permit with plat valid without expiration. Improvement Permit with site plan valid for sixty months. Authorization to Construct is valid for a period equal to that of Improvement Permit – not to exceed sixty months.

Signed: X [signature] date 5-19-03 Installed by: TOMMY FRYE

Improvement Permit by: STEVE HEDRICK date 5-19-03 Operation Permit by: STEVE HEDRICK date 5-9-05

Authorization to Construct by: STEVE HEDRICK date 5-19-03 Existing System Inspection by: date

HEALTH DEPT. COPY: WHITE OWNER COPY (FINAL): YELLOW OWNER COPY (INITIAL): PINK