IREDELL COUNTY HEALTH DEPARTMENT

STATESVILLE 704-878-5305 MOORESVILLE 704-664-5281

IMPROVEMENT PERMIT / AUTHORIZATION TO CONSTRUCT / OPERATION PERMIT / EXISTING SYSTEM INSPECTION

PERMIT# 152962 PIN# 4709-94-5609 DATE 24 October 08

OWNER OR APPLICANT Kevin & Rachel Privette PHONE: Business 704-902-0645 Home

ADDRESS 745 Pisgah Ridge Circle Statesville, N.C.

LOCATION 115N TL Pisgah Rd. TR Bowles Farm TL Hills Farm Rd. TR Pisgah Ridge Rd. TR Pisgah Ridge Circle 1st Lot on Rt.

SUBDIVISION BLOCK / SECTION LOT LOT AREA 1.66 SITE CLASS. PS DESIGN FLOW 360 L.T.A.R. 3/14/07

Septic Tank: 1000 Gallons; STB 1012 Date 4-22-08

Pump Tank: Gallons; PT Date

Pump Make: Model Serial No.

Nitrification Field: No Fields 1 Square Feet ≈ 1200 Linear Feet 300

No Lines 4 Trench Width 36" Max Trench Bottom Depth 36" Gravel Depth

☑ New System ☐ Repair ☐ Expansion System Type: I II (III) IV V VI

System Description: 25% Reduction

Repair System Description: 25% Reduction

Maintenance Agreement Required: ☐ Yes ☑ No

☑ House/Mod. Home ☐ Mobile Home ☐ Business ☐ Other

No. Bedrooms 3 No. Persons No. Employees

Water Supply: ☑ Individual ☐ Public ☐ Community

☑ Gravity ☐ Pressure ☐ Slab ☐ Crawl Space ☑ Basement w/plumbing ☐ Basement wo/plumbing

Comments:/Conditions: Follow contours / Keep trench bottoms at 36" / Keep well 100' from system and repair areas /

Comments:/Conditions: Poly Loc filter installed 5T has marker 7 1/2 40 5T from well.

INITIAL SITE SKETCH

Please see Attached Site Sketch

AS BUILT SKETCH

Install same as drawn.

Permit can be suspended or revoked if any false information is supplied toward securing the permit/any unauthorized changes are made to the site/any unauthorized changes are made in the installation of the system. Improvement Permit with plat valid without expiration ☐ Improvement Permit with site plan valid for sixty months ☑ Authorization to Construct is valid for a period equal to that of Improvement Permit – not to exceed sixty months.

Signed: Kenneth Myers date 10-27-08

Improvement Permit by: R.S. date 24 Oct 08

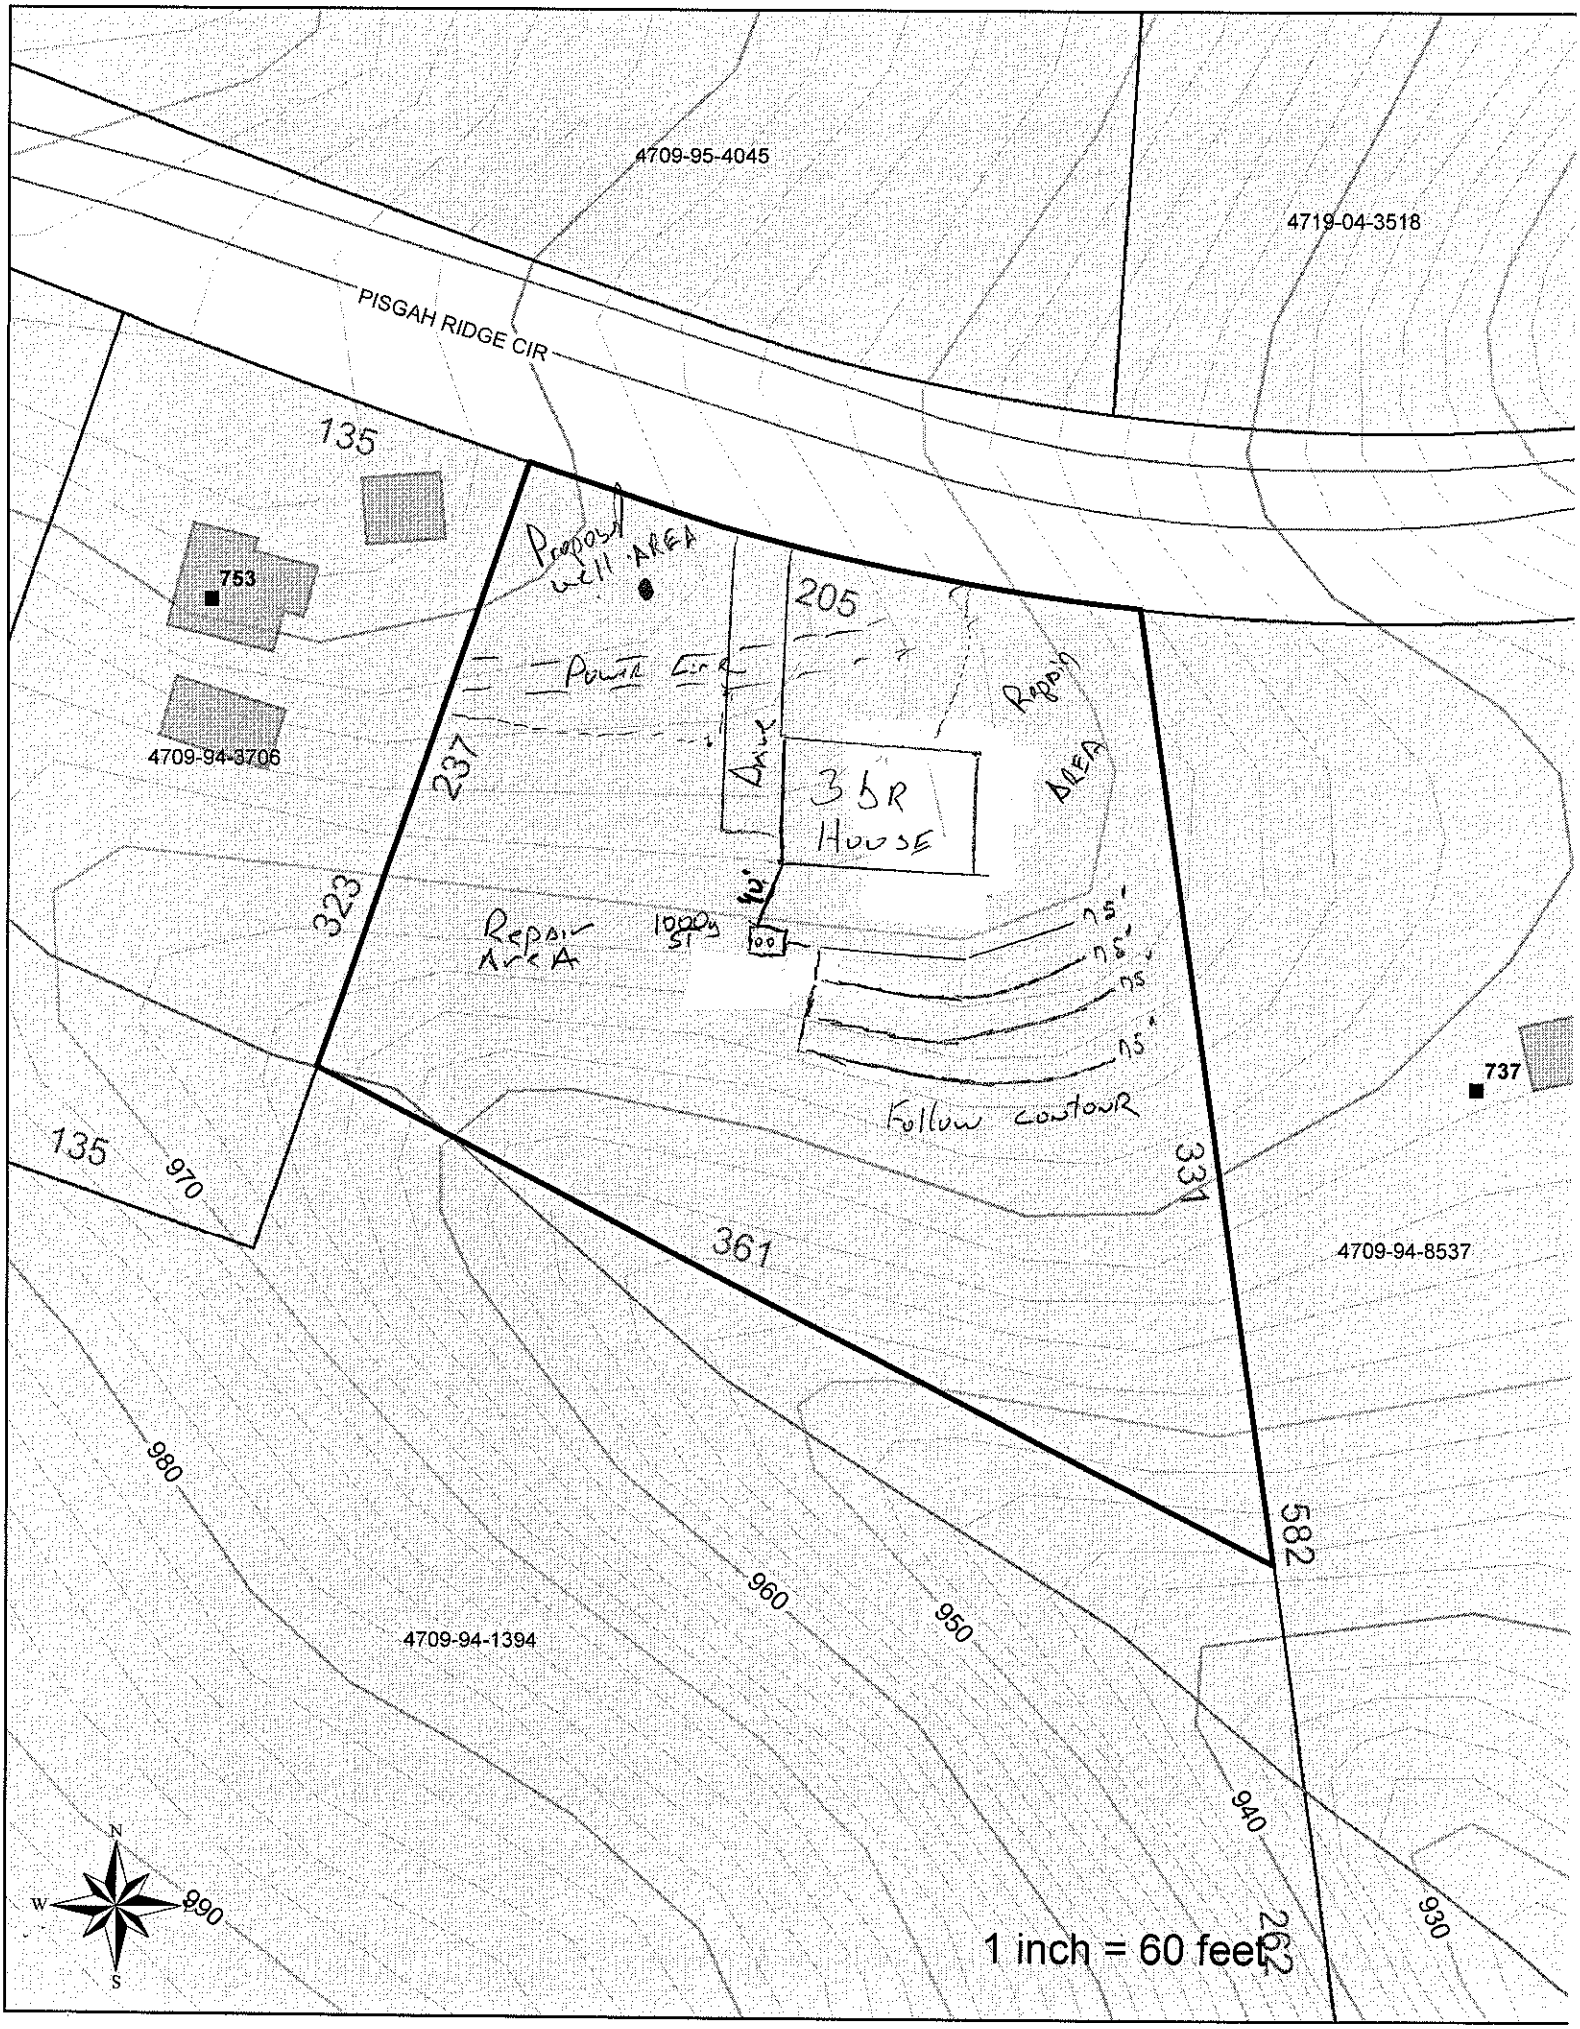
Authorization to Construct by: R.S. date 24 Oct 08

Installed by: Steve Jordan

Operation Permit by: R.S. date 17 August

Existing System Inspection by: date

HEALTH DEPT. COPY: WHITE OWNER COPY (FINAL): YELLOW OWNER COPY (INITIAL): PINK


4709-95-4045
4719-04-3518
PISGAH RIDGE CIR
135
753
4709-94-3706
Proposed well AREA
205
Power Line
237
Drive
3BR House
Repair AREA
1000 sq
323
Repair AREA
75'
75'
75'
75'
Follow contour
737
135
970
361
334
4709-94-8537
980
960
950
582
4709-94-1394
940
930
990
262
1 inch = 60 feet