IREDELL COUNTY HEALTH DEPARTMENT

STATESVILLE 704-878-5305 MOORESVILLE 704-664-5281

IMPROVEMENT PERMIT / AUTHORIZATION TO CONSTRUCT / OPERATION PERMIT / EXISTING SYSTEM INSPECTION

PERMIT# 89452 PIN# 4709944367 DATE 6-1-00

OWNER OR CONTRACTOR John Childers PHONE: Business Home 876 1535

ADDRESS 745 Pisgah Ridge Cr. Hiddenite

LOCATION 115N TL Pisgah Church TR Bowles Fm TL Hill Fm TR Pisgah Ridge 4th HSE Past Fork

SUBDIVISION BLOCK / SECTION LOT LOT AREA 5 acres SITE CLASS RS DESIGN FLOW 360 L.T.A.R. .3 gpd/sq ft Hay

Septic Tank: 1000 Gallons; STB 312 Date 7-17-00
Pump Tank: Gallons; PT Date
Pump Make: Model Serial No.
Nitrification Field: No Fields 1 Square Feet 1200 Linear Feet 400
No Lines 3 Trench Width 36" Max Trench Bottom Depth 34" Gravel Depth 12"

☑ New System ☐ Repair System Type: I, II, III, IV, V, VI
System Description: Conv. Gravity
Repair System Description:
Maintenance Agreement Required. ☐ Yes ☑ No
☐ Slab ☑ Crawl Space ☐ Basement w/plumbing ☐ Basement wo/plumbing


☑ House/Mod. Home No. Bedrooms 3
☐ Mobile Home No. Bathrooms 2
☐ Business No. Employees
☐ Other

Water Supply: ☐ Individual ☐ Public ☐ Community


Comments/Conditions:
Shallow

Comments/Conditions:
556' Note Hit rock throughout lines 2nd line deep 3/4 out due to terrace

INITIAL SITE SKETCH

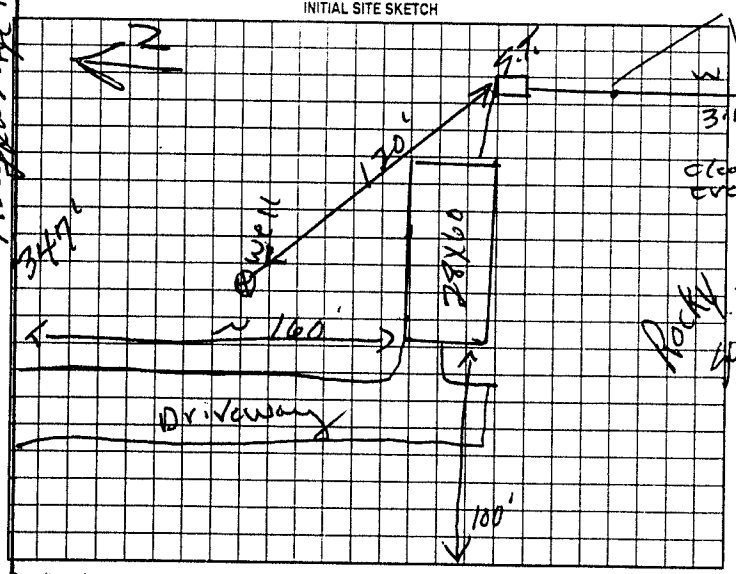

AS BUILT SKETCH

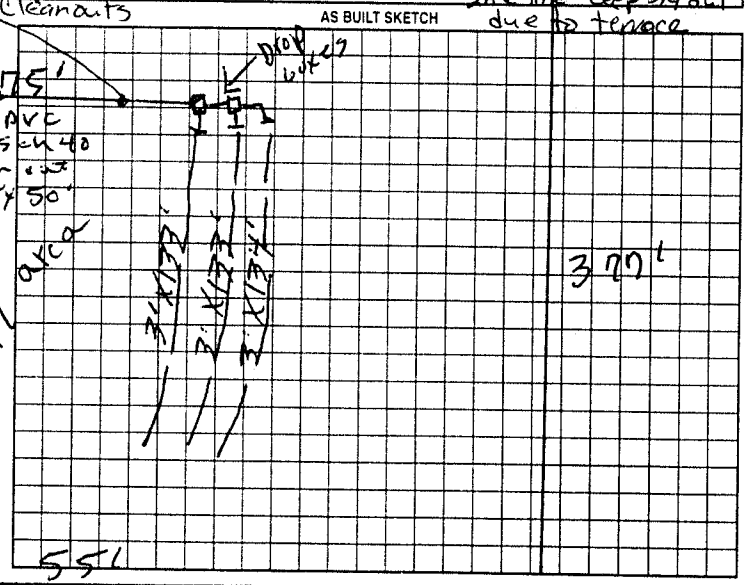

Permit can be suspended or revoked if any false information is supplied toward securing the permit/any unauthorized changes are made to the site/any unauthorized changes are made in the installation of the system. Improvement Permit with plat valid without expiration. Improvement Permit with site plan valid for sixty months. Authorization to Construct is valid for a period equal to that of Improvement Permit – not to exceed sixty months.

Signed: John E. Childers date

Improvement Permit by: P.C. Moore date 6-1-00

Authorization to Construct by: P.C. Moore date 6-1-00

Installed by: Kenny Pearson

Operation Permit by: Mary C. Ott RS date 8-29-00

Existing System Inspection by: date

HEALTH DEPT COPY WHITE OWNER COPY (FINAL) YELLOW OWNER COPY (INITIAL) PINK