IREDELL COUNTY HEALTH DEPARTMENT

STATESVILLE 704-878-5305 MOORESVILLE 704-664-5281

IMPROVEMENT PERMIT / AUTHORIZATION TO CONSTRUCT / OPERATION PERMIT / EXISTING SYSTEM INSPECTION

PERMIT# REPAIR PIN# DATE 4-30

OWNER OR CONTRACTOR JAMES P. COLLINS PHONE: Business Home (704) 528-5594

ADDRESS 261 3, HARBOR WATCH DRIVE STATESVILLE, NC 28677

LOCATION BUFFALO SHOALS ROAD, TL LAUREL COVE RD, TR 3, HARBOR WATCH DR, AT END ON LEFT

SUBDIVISION HARBOR WATCH BLOCK / SECTION I LOT 25/25-1 LOT AREA 0.654 ± AC SITE CLASS P5 DESIGN FLOW 360 L.T.A.R. 0.30 GPD/FT²

Septic Tank: EXISTING Gallons: STB Date

Pump Tank: EXISTING Gallons: PT Date

Pump Make: Model Serial No.

Nitrification Field: No Fields 1 Square Feet Linear Feet EXISTING

No Lines Trench Width Max Trench Bottom Depth Gravel Depth

☐ New System ☑ Repair System Type: I. II. III. IV. V. VI

System Description: PPBPS PUMP-FED

Repair System Description PPBPS PUMP-FED

Maintenance Agreement Required: ☐ Yes ☑ No

☐ Slab ☐ Crawl Space ☑ Basement w/plumbing ☐ Basement wo/plumbing

☑ House/Mod. Home No. Bedrooms 3

☐ Mobile Home No. Bathrooms 3

☐ Business No. Employees


☐ Other

Water Supply: ☑ Individual ☐ Public ☐ Community

Comments/Conditions: REPLACE EXISTING SUPPLY LINE (BROKEN) CAUSING EROSION UNDER DRIVEWAY WITH NEW 3" x 190' SCH 80 PVC USING AS FEW JOINTS & ELBOWS AS POSSIBLE

Comments/Conditions SYSTEM MUST BE REPAIRED BY MAY 30, 2001 TO PREVENT FURTHER EROSION UNDER DRIVEWAY & DAMAGE TO DRIVEWAY, AND TO PREVENT FURTHER DISCHARGE TO GROUND SURFACE THROUGH RETAINING WALL

INITIAL SITE SKETCH

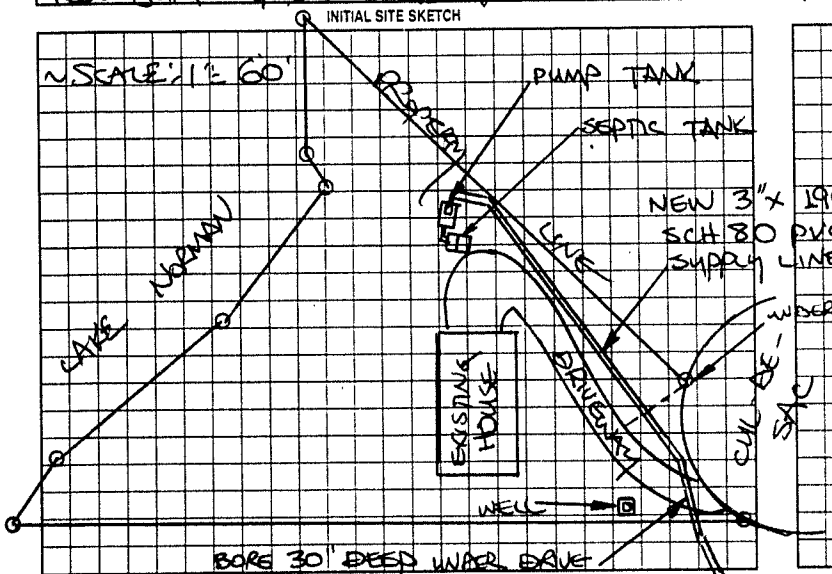

AS BUILT SKETCH

SYSTEM REPAIRED ACCORDING TO INITIAL SITE SKETCH

Permit can be suspended or revoked if any false information is supplied toward securing the permit/any unauthorized changes are made to the site/any unauthorized changes are made in the installation of the system. Improvement Permit with plat valid without expiration. Improvement Permit with site plan valid for sixty months. Authorization to Construct is valid for a period equal to that of Improvement Permit – not to exceed sixty months.

Signed: James P Collins date 4-30-01 Installed by: C & W GRADING

Improvement Permit by: STEVE HEDRICK date 4-30-01 Operation Permit by: STEVE HEDRICK date 6-6-01

Authorization to Construct by: STEVE HEDRICK date 4-30-01 Existing System Inspection by: date

HEALTH DEPT COPY: WHITE OWNER COPY (FINAL) YELLOW OWNER COPY (INITIAL) PINK