HERBERT L. CAMPBELL

THIS PERMIT VOIDS PREVIOUS ISSUED 4-5-97

IREDELL COUNTY HEALTH DEPARTMENT

STATESVILLE 704-878-5305 MOORESVILLE 704-664-5281

IMPROVEMENT PERMIT / AUTHORIZATION TO CONSTRUCT / OPERATION PERMIT / EXISTING SYSTEM INSPECTION

PERMIT# 25797 PIN# 4711 32 8600 (PT) DATE 5-9-98

OWNER OR CONTRACTOR LAKE NORMAN PROPERTIES, INC PHONE: Business 895-5877 Home

ADDRESS P.O. BOX 1979, MATHEWS, NC 28106

LOCATION BUFFALO SHOALS ROAD, TL LAUREL COVE RD, TR HARBOR POINTE DRIVE, AT END ON LEFT (DRAINFIELD 850' ON L BEFORE END)

SUBDIVISION HARBOR WATCH BLOCK / SECTION I LOT 25/25-1 LOT AREA 0.654 & 0.236 AC SITE CLASS PS DESIGN FLOW 480 L.T.A.R. 0.30 SQ FT

Septic Tank: 1000 Gallons; STB 1012 Date 4-27-99
Pump Tank: 1000 Gallons; PT 17 Date 4-11-99
Pump Make: _____ Model _____ Serial No. _____
Nitrification Field: No Fields 1 Square Feet EQ TO 1600 Linear Feet ~280
No Lines EIGHT Trench Width 24" Max Trench Bottom Depth 36"

[X] New System [ ] Repair System Type: I, II, (III), IV, V, VI
System Description: PPBPS, PUMP-FED
Repair System Description: PPBPS, PUMP-FED
Maintenance Agreement Required: [ ] Yes [X] No

[X] House/Mod. Home No. Bedrooms 4
[ ] Mobile Home No. Bathrooms 3
[ ] Business No. Employees
[ ] Other


Gravel Depth SAND 6" [ ] Slab [ ] Crawl Space [X] Basement w/plumbing [ ] Basement wo/plumbing

Water Supply: [X] Individual [ ] Public [ ] Community WELL


Comments:/Conditions: (1) CONTACT HEALTH DEPT PRIOR TO INSTALLATION TO FLAG DRAINLINES (2) INSTALL SIXTY-FOUR (64) PPBPS PANELS IN EIGHT EQUAL LENGTH LINES AS SHOWN (3) USE 3" x 1150 SCH 80 PVC SUPPLY LINE FROM LOT 25 TO LOT 25-1 (4) SEE ATTACHED SHEETS FOR PUMP & PRESSURE MANIFOLD REQUIREMENTS.

Comments:/Conditions: (1) DRAINLINES INSTALLED DURING PERIOD OF WET WEATHER (2) SEPTIC TANK AND PUMP TANK INSTALLED IN BACKFILL AT OWNERS REQUEST TO PROTECT INTEGRITY OF WALL

INITIAL SITE SKETCH

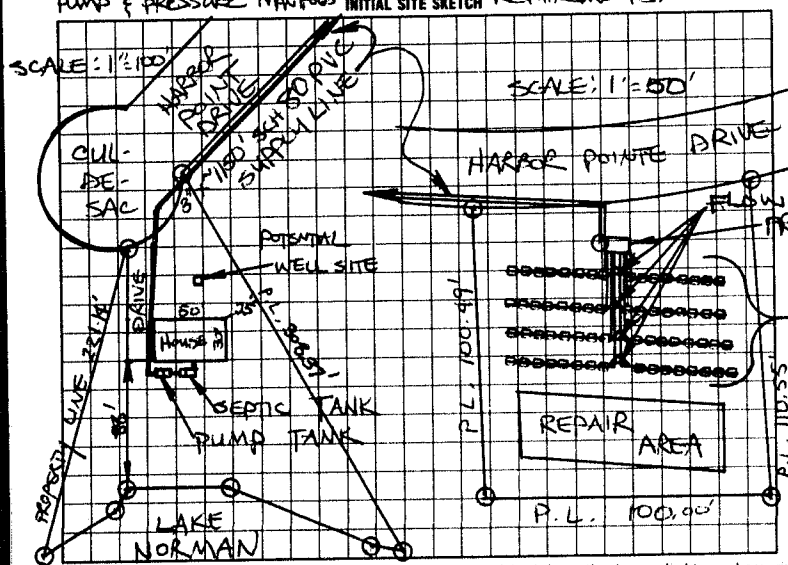

AS BUILT SKETCH

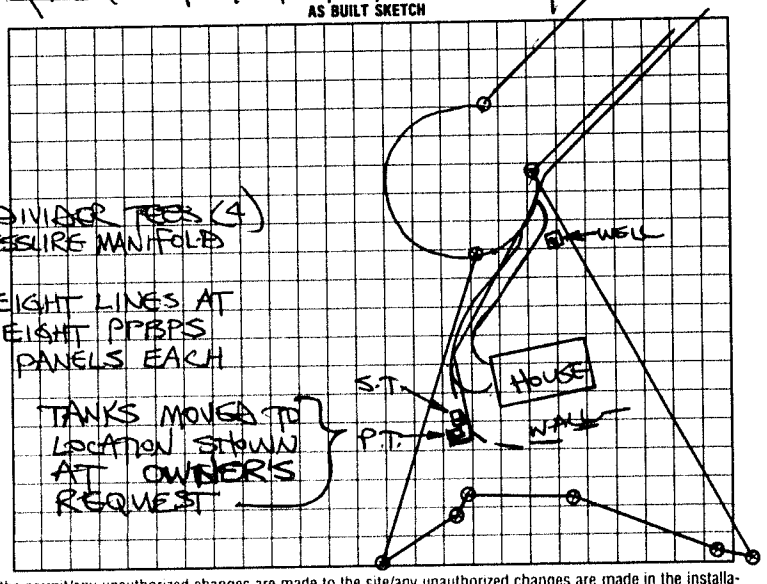

I understand that this permit can be suspended or revoked if any false information is supplied toward securing the permit/any unauthorized changes are made to the site/any unauthorized changes are made in the installation of the system. Improvement Permit with plat valid without expiration. Improvement Permit with site plan valid for sixty months. Authorization to Construct is valid for a period equal to that of Improvement Permit – not to exceed sixty months.

Signed: H L Campbell date 5-11-98

Improvement Permit by: STEVE HEDRICK date 5-9-98

Authorization to Construct by: STEVE HEDRICK date 5-9-98

Installed by: C & W GRADING

Operation Permit by: Mat C Obj 125 date 7-19-99

Existing System Inspection by: _____ date _____

HEALTH DEPT. COPY: WHITE INSPECTION COPY (FINAL): GREEN OWNER COPY (FINAL): YELLOW INSPECTION COPY (INITIAL): PINK OWNER COPY (INITIAL): GOLD