IREDELL COUNTY HEALTH DEPARTMENT

THIS PERMIT VOIDS PREVIOUS ISSUED 4-12-97

STATESVILLE 704-878-5305 MOORESVILLE 704-664-5281

IMPROVEMENT PERMIT / AUTHORIZATION TO CONSTRUCT / OPERATION PERMIT / EXISTING SYSTEM INSPECTION

PERMIT# 025793 83518 PIN# 4710 29 7811 DATE 2-18-00

OWNER OR CONTRACTOR TOM & VIRGINIA EVANS PHONE: Business 528-3999 Home

ADDRESS c/o PRESTIGE BUILDING CO, P.O. BOX 749, TROUTMAN, NC 28166

LOCATION BUFFALO SHOALS RD, TL LAUREL COVE, TR HARBOR GATE, TL HARBOR POINT, TL HIGH LAKE, 4TH LOT ON LEFT BEFORE END

SUBDIVISION HARBOR WATCH BLOCK / SECTION I LOT 21 LOT AREA 1.250 SITE CLASS PS DESIGN FLOW 600 L.T.A.R. 0.30 GPD/FT²

Septic Tank: 1500 Gallons; STB 1014 Date 9-11-99

Pump Tank: 1500 Gallons; PT 46 Date

Pump Make: Model Serial No.

Nitrification Field: No Fields 1 Square Feet EQ. TO 2000 Linear Feet ~348

No Lines SIX Trench Width 24" Max Trench Bottom Depth 36" Gravel Depth SAND 6"

☑ New System ☐ Repair System Type: I, II, III, (IV), V, VI

System Description: LOW PRESSURE PPBPS

Repair System Description: LOW PRESSURE PPBPS

Maintenance Agreement Required: ☑ Yes ☐ No

☑ House/Mod. Home No. Bedrooms 5

☐ Mobile Home No. Bathrooms 3

☐ Business No. Employees

☐ Other

☐ Slab ☐ Crawl Space ☑ Basement w/plumbing ☐ Basement wo/plumbing

Water Supply: ☑ Individual ☐ Public ☐ Community WELL

Comments:/Conditions:

Comments:/Conditions: APR. 15 - TOP TWO LINES INSPECTED. M.H.'S SILTING REMOVED

APR. 16 - PRESSURE HEAD SET ON ALL LINES SCP.

INITIAL SITE SKETCH

(1) INSTALL 50% REDUCTION SYSTEM USING SEVENTY-EIGHT (78) PPBPS PANELS IN SIX EQUAL LENGTH LINES ON CONTOUR AS SHOWN ON ATTACHED PLAN.

(2) INSTALL LINES IN ACCORDANCE WITH GUIDELINES SET FORTH IN RULE .1956(5) - STEEP SLOPES

(3) CERTIFIED MANAGEMENT ENTITY SHALL BE CONTRACTED WITH PRIOR TO ISSUANCE OF OPERATION PERMIT

(4) SYSTEM TO BE INSTALLED AS SPECIFIED IN ATTACHED SITE PLAN DATED FEB. 10 2000 PREPARED BY B.K. BARRINGER

AS BUILT SKETCH

SYSTEM INSTALLED ACCORDING TO INITIAL SITE SKETCH

Permit can be suspended or revoked if any false information is supplied toward securing the permit/any unauthorized changes are made to the site/any unauthorized changes are made in the installation of the system. Improvement Permit with plat valid without expiration. Improvement Permit with site plan valid for sixty months. Authorization to Construct is valid for a period equal to that of Improvement Permit – not to exceed sixty months.

Signed: date 2-21-00 Installed by: C & W GRADING


Improvement Permit by: STEVE HEDRICK date 2-18-00 Operation Permit by: STEVE HEDRICK date 4-13-00

Authorization to Construct by: STEVE HEDRICK date 2-18-00 Existing System Inspection by: date


HEALTH DEPT. COPY: WHITE OWNER COPY (FINAL): YELLOW OWNER COPY (INITIAL): PINK

HARBOR WATCH SECTION I LOT #21

INSTALL LINES IN ACCORDANCE WITH .1956 (5) STEEP SLOPES

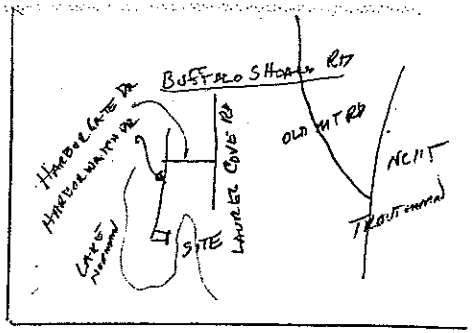

VICINITY MAP

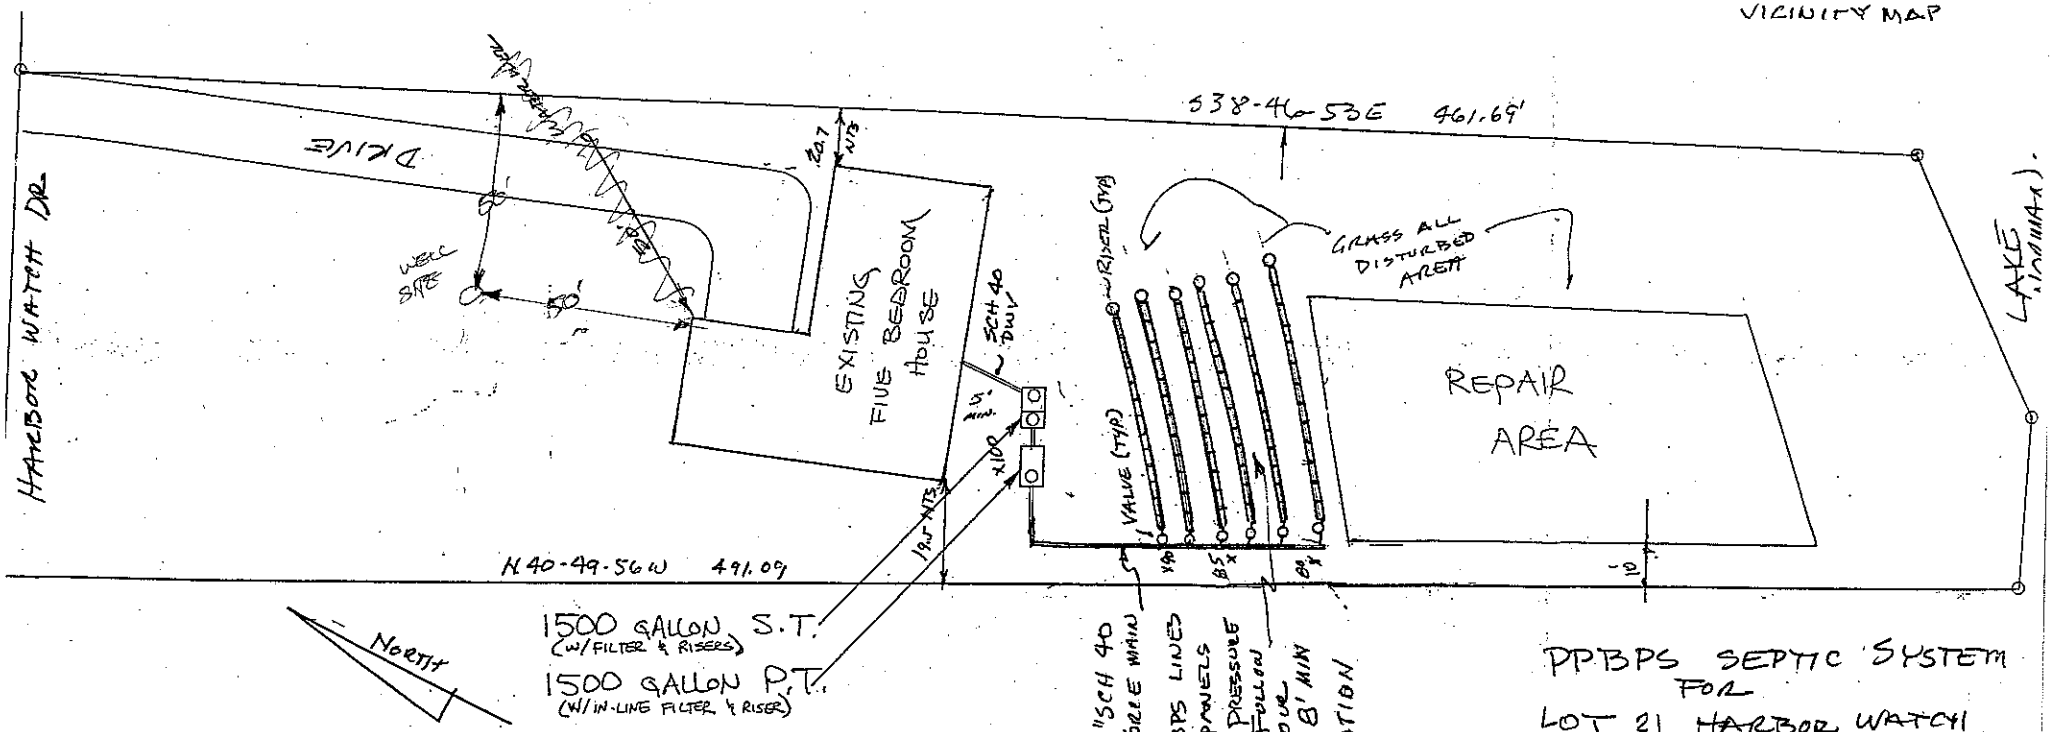

PPBPS SEPTIC SYSTEM
FOR
LOT 21 HARBOR WATCH
FALLSTOWN TWN IREDELL CO
N.C.
SCALE: 1" = 30' DATE: 2-10-06
DRAWN BY BKB

NORTH CAROLINA PROFESSIONAL SEAL 3370 ENGINEER B. K. BARRINGER, JR.

2-10-06