THIS PERMIT REPLACES EXPIRED PERMIT # 25789

IREDELL COUNTY HEALTH DEPARTMENT

STATESVILLE 704-878-5305 MOORESVILLE 704-664-5281

IMPROVEMENT PERMIT / AUTHORIZATION TO CONSTRUCT / OPERATION PERMIT / EXISTING SYSTEM INSPECTION

PERMIT# 1360060 PIN# 4710-39-2825 DATE 6-13-06

OWNER OR APPLICANT CHERYL CAMPBELL PHONE: Business 704-235-1496 Home 704-507-2568

ADDRESS c/o 514 WILLIAMSON ROAD, MOORESVILLE, NC 28117

LOCATION BUFFALO SHOALS ROAD to LAUREL COVE ROAD,

SUBDIVISION HARBOR WATCH BLOCK / SECTION I LOT 17 LOT AREA 1.29 ACRES SITE CLASS. PS DESIGN FLOW 360 L.T.A.R. 0.30 GPD/FT2

Septic Tank: EXISTING 1000 Gallons; STB 825 Date 3-4-99

Pump Tank: EXISTING 1000 Gallons; PT 17 Date 4-5-99

Pump Make EX. HYDROMATIC Model SIMS 100 M2 Serial No. 518710007

Nitrification Field: No Fields 1 Square Feet 60 TO 1200 Linear Feet 200+

No Lines SIX EXISTING Trench Width 24" Max Trench Bottom Depth 36

Gravel Depth SAND

☑ New System ☐ Repair ☐ Expansion System Type: I II (III) V V VI

System Description: 50% REDUCTION PUMP

Repair System Description: 50% REDUCTION, LOW-PRESS USE

Maintenance Agreement Required: ☐ Yes ☑ No


☑ House/Mod. Home ☐ Mobile Home ☐ Business ☐ Other

No. Bedrooms 3 No. Persons ___ No. Employees ___

Water Supply: ☑ Individual ☐ Public ☐ Community WELL

☐ Gravity ☑ Pressure ☐ Slab ☐ Crawl Space ☐ Basement w/plumbing ☐ Basement wo/plumbing

Comments:/Conditions: ~ SCALE: 1" = 60'

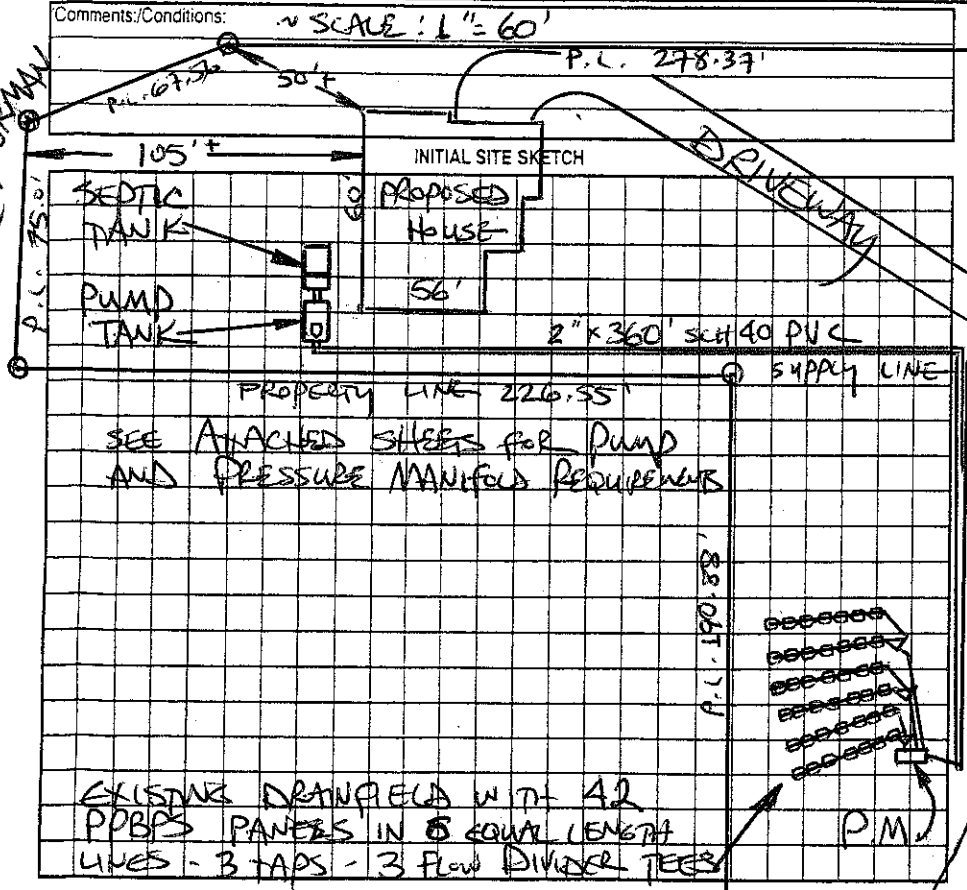


Comments:/Conditions: LINES & TANKS PREVIOUSLY INSPECTED.

NEED: ① ELECTRICAL CONTROL PANEL

② SEPTIC ALARM

③ PRESSURE CHECK (AGAIN)

AS BUILT SKETCH

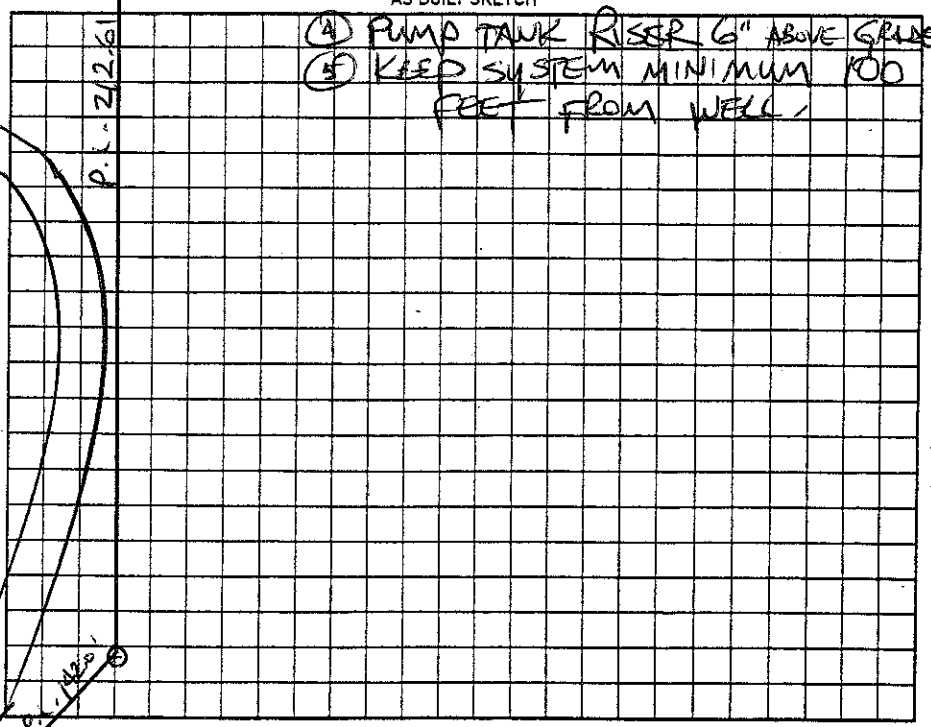

④ PUMP TANK RISER 6" ABOVE GRADE

⑤ KEEP SYSTEM MINIMUM 100 FEET FROM WELL.

Permit can be suspended or revoked if any false information is supplied toward securing the permit/any unauthorized changes are made to the site/any unauthorized changes are made in the installation of the system. Improvement Permit with plat valid without expiration ☐ Improvement Permit with site plan valid for sixty months ☑ Authorization to Construct is valid for a period equal to that of Improvement Permit – not to exceed sixty months.

Signed: C. Campbell date 6-13-06 Installed by: C+W

Improvement Permit by: STEVE HEDRICK date 6-13-06 Operation Permit by: [signature] date 4-23-08

Authorization to Construct by: STEVE HEDRICK date 6-13-06 Existing System Inspection by: ___ date ___

HEALTH DEPT. COPY: WHITE OWNER COPY (FINAL): YELLOW OWNER COPY (INITIAL): PINK

CUL-DE-SAC