IREDELL COUNTY HEALTH DEPARTMENT

STATESVILLE 704-878-5305 MOORESVILLE 704-664-5281

IMPROVEMENT PERMIT / AUTHORIZATION TO CONSTRUCT / OPERATION PERMIT / EXISTING SYSTEM INSPECTION

PERMIT# 133331 PIN# 4710-34-6369 DATE 2-22-06

OWNER OR APPLICANT MICHAEL MCKINNEY PHONE: Business Home 336-601-3393

ADDRESS 604 LEALWOOD DR GREENSBORO NC

LOCATION BUFFALO SHOALS WEST (L) LAUREL LOVE (R) HAZELWOOD (L) HAZELWOOD DR (L) HIGH LAKE LOT #9 ON LEFT

SUBDIVISION HAZELWOOD BLOCK / SECTION I LOT 9 LOT AREA 1.597AC SITE CLASS. PS DESIGN FLOW 360 L.T.A.R. .25

Septic Tank: 1000 Gallons; STB 312 Date 5-2-06

Pump Tank: Gallons; PT Date

Pump Make: Model Serial No.

Nitrification Field: No Fields 1 Square Feet EQ=1440 Linear Feet 240'

No Lines 6x40' Trench Width 24" Max Trench Bottom Depth 36"

[X] New System [ ] Repair [ ] Expansion System Type: I II (III) IV V VI

System Description: 6 LOW 50% REDUCT

Repair System Description: LP 50% REDUCT

Maintenance Agreement Required: [ ] Yes [X] No

Gravel Depth N/A [X] Gravity [ ] Pressure

[X] House/Mod. Home No. Bedrooms 3

[ ] Mobile Home No. Persons 6

[ ] Business No. Employees

[ ] Other


Water Supply: [X] Individual [ ] Public [ ] Community

[ ] Slab [ ] Crawl Space [X] Basement w/plumbing [ ] Basement wo/plumbing


Comments/Conditions: (1) INSTALL 6 LINES 40' LOW PSI W/ A FLOW DIVIDER TEE & 2 EFFLUENT SPLITTERS SOLD AS ZOELLER TOW FLOW SPLITTER, (2) INSTALL LINES ON CONTOURS & MAINTAIN SETBACKS (3) LINES & HOUSE BALL

Comments/Conditions: LINE IS completely FLAGGED OUT

INITIAL SITE SKETCH

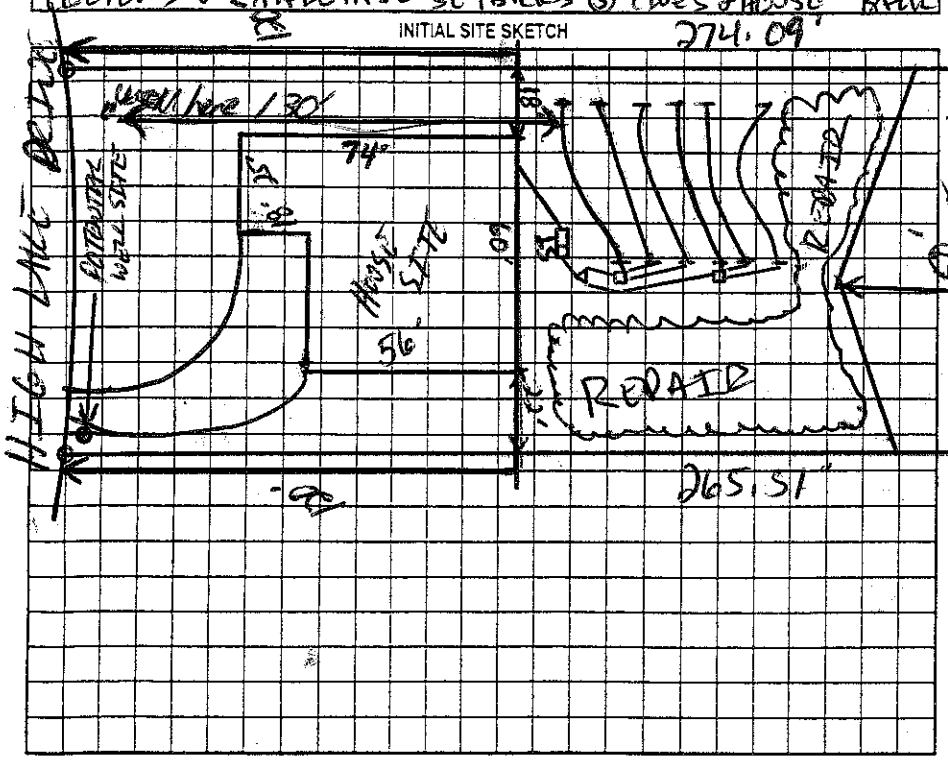

AS BUILT SKETCH

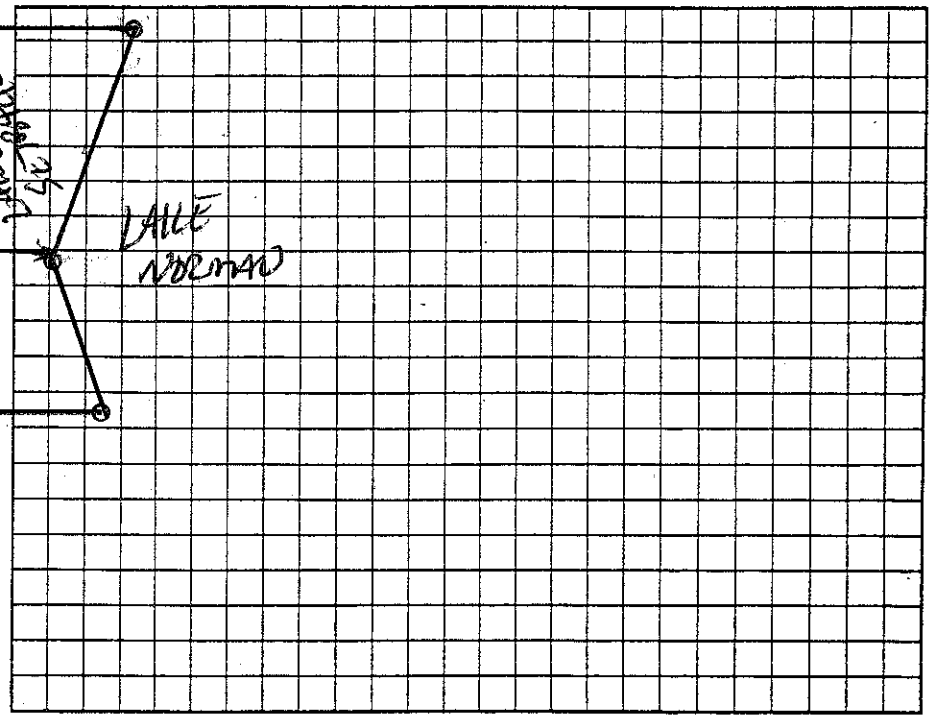

Permit can be suspended or revoked if any false information is supplied toward securing the permit/any unauthorized changes are made to the site/any unauthorized changes are made in the installation of the system. Improvement Permit with plat valid without expiration [ ] Improvement Permit with site plan valid for sixty months [X] Authorization to Construct is valid for a period equal to that of Improvement Permit – not to exceed sixty months.

Signed: date 2-23-06 Installed by: CURT DUNNING

Improvement Permit by: RS date 2-23-06 Operation Permit by: RS date 1-19-07

Authorization to Construct by: date 2-22-06 Existing System Inspection by: date

HEALTH DEPT. COPY: WHITE OWNER COPY (FINAL): YELLOW OWNER COPY (INITIAL): PINK