IREDELL COUNTY HEALTH DEPARTMENT

THIS PERMIT REPLACES EXPIRED PERMIT #25800

STATESVILLE 704-878-5305 MOORESVILLE 704-664-5281

IMPROVEMENT PERMIT / AUTHORIZATION TO CONSTRUCT / OPERATION PERMIT / EXISTING SYSTEM INSPECTION

PERMIT# 107116 PIN# 4710-39-6697 DATE 6-5-02

OWNER OR CONTRACTOR PRESTIGE PREMIER HOME BUILDERS PHONE: Business 704-528-3999 Home 704-363-4846

ADDRESS P.O. Box 749 TROUTMAN NC 28166

LOCATION BUFFALO SHOALS RD, TL LAUREL COVE RD, TR HARBOR GATE, TL HARBOR POINT, TL HIGH LAKE, ON RIGHT PAST CURVE

SUBDIVISION HARBOR WATCH BLOCK / SECTION I LOT 43 LOT AREA 0.819 ACRES SITE CLASS. PS DESIGN FLOW 360 L.T.A.R. 0.30 GPD/FT²

Septic Tank: 1000 Gallons; STB 312 Date 5-21-02
Pump Tank: 1000 Gallons; PT 27 Date 6-16-02
Pump Make: MYERS Model ME50 Serial No.
Nitrification Field: No Fields 1 Square Feet EQ. TO 1200 Linear Feet 200
No Lines FIVE Trench Width 24" Max Trench Bottom Depth 36"

☑ New System ☐ Repair System Type: I, II, III, IV, V, VI
System Description: 50% REDUCTION, PUMP
Repair System Description: 50% REDUCTION, LOW-PRESSURE
Maintenance Agreement Required: ☐ Yes ☑ No
Gravel Depth SAND 6"


☑ House/Mod. Home No. Bedrooms 3
☐ Mobile Home No. Bathrooms 3
☐ Business No. Employees
☐ Other
☐ Slab ☐ Crawl Space ☑ Basement w/plumbing ☐ Basement wo/plumbing

Water Supply: ☑ Individual ☐ Public ☐ Community
WELL


Comments/Conditions: ① INSTALL 50% REDUCTION SYSTEM USING 45 PPBPS PANELS AS SHOWN ② KEEP SYSTEM 25' FROM BASEMENT; MAXIMUM FEASIBLE DISTANCE FROM WELL (70') ③ SEE ATTACHED SHEETS FOR PUMP & PRESSURE MANIFOLD REQUIREMENTS.

Comments/Conditions:

INITIAL SITE SKETCH ~SCALE: 1"=40'

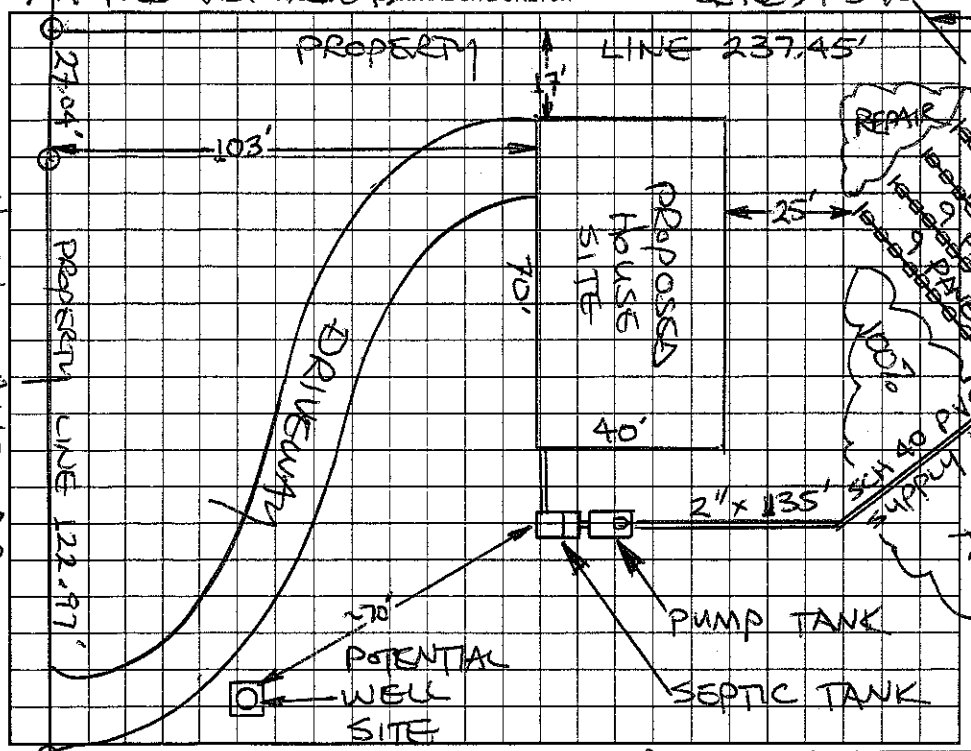

AS BUILT SKETCH

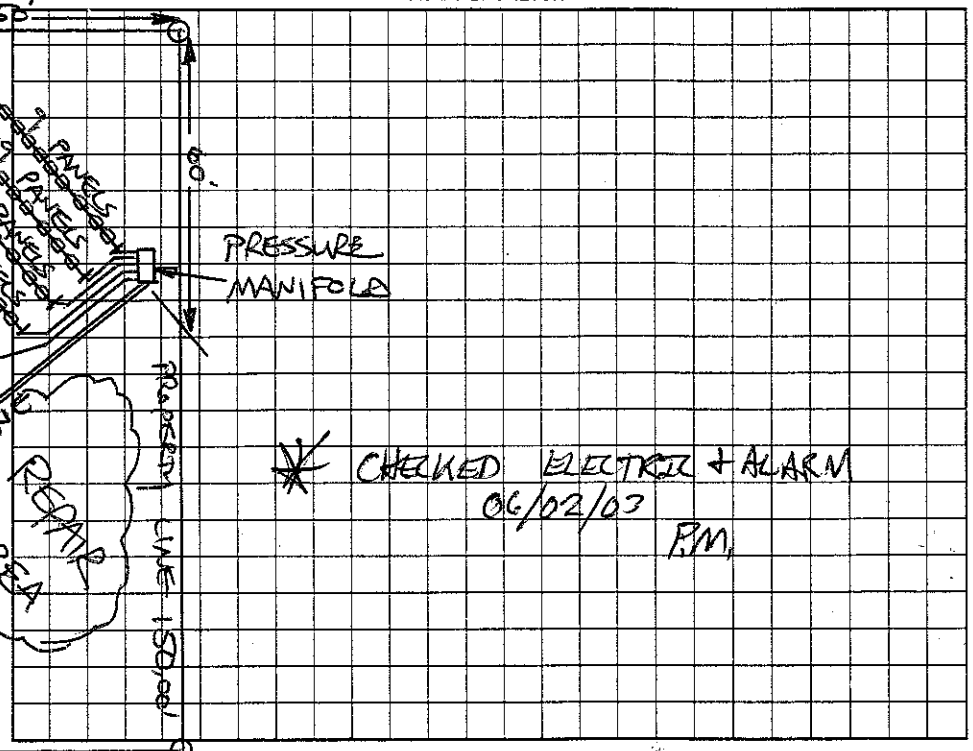

Permit can be suspended or revoked if any false information is supplied toward securing the permit, any unauthorized changes are made to the site, any unauthorized changes are made in the installation of the system. Improvement Permit with plat valid without expiration. Improvement Permit with site plan valid for sixty months. Authorization to Construct is valid for a period equal to that of Improvement Permit – not to exceed sixty months.

Signed: [signature] date 6-13-02 Installed by: ? Sammy Shumaker ? SAMMY SHUMAKER

Improvement Permit by: STEVE HEDRICK date 6-5-02 Operation Permit by: Patricia Mitchell date 06/02/03

Authorization to Construct by: STEVE HEDRICK date 6-5-02 Existing System Inspection by: date

HEALTH DEPT. COPY: WHITE OWNER COPY (FINAL): YELLOW OWNER COPY (INITIAL): PINK