IREDELL COUNTY HEALTH DEPARTMENT

663-5870 STATESVILLE 704-878-5305 (Office) MOORESVILLE 704-664-5201

IMPROVEMENT PERMIT / AUTHORIZATION TO CONSTRUCT / OPERATION PERMIT / EXISTING SYSTEM INSPECTION

PERMIT# REPAIR PIN# REPAIR 4710-59-7319 DATE 7/23/02

OWNER OR CONTRACTOR JAMES & DORIS WILSON PHONE: Business Home

ADDRESS 183 HIGH LAKE DR. STATESVILLE NC 28677

LOCATION BUFFALO SHOALS - TL LAUREL COVE - TR HARBOR WATCH TL HIGH LAKE DR. 8th ON LT

SUBDIVISION HARBOR WATCH BLOCK / SECTION 1 LOT 8 LOT AREA .708AC SITE CLASS. PS DESIGN FLOW 360GPD L.T.A.R. .3 gal/SF

Septic Tank: EXISTING Gallons; STB Date

Pump Tank: EXISTING Gallons; PT Date

Pump Make: Model Serial No.

Nitrification Field: No Fields 1 Square Feet 900 Linear Feet 300

No Lines 6 Trench Width 36" Max Trench Bottom Depth 24" Gravel Depth N/A

☐ New System ☑ Repair System Type: I, II, III, (IV), V, VI

System Description:

Repair System Description: LPP EZ Flow

Maintenance Agreement Required: ☑ Yes ☐ No

☑ House/Mod. Home No. Bedrooms 3

☐ Mobile Home No. Bathrooms 3

☐ Business No. Employees

☐ Other


☐ Slab ☐ Crawl Space ☑ Basement w/plumbing ☐ Basement wo/plumbing

Water Supply: ☑ Individual ☐ Public ☐ Community


Comments/Conditions:

Comments/Conditions: 1) UPPER LINE CUT OFF DUE TO IT BEING TO CLOSE TO FRENCH DRAIN GIVING A TOTAL OF 277 LINEAR FEET.

INITIAL SITE SKETCH

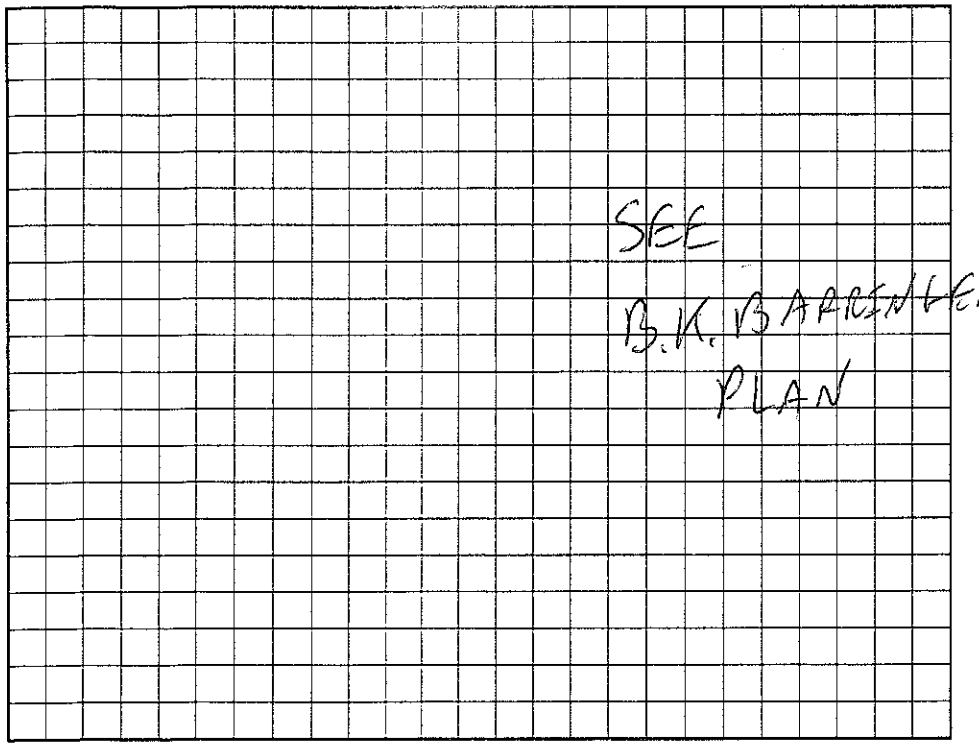

AS BUILT SKETCH

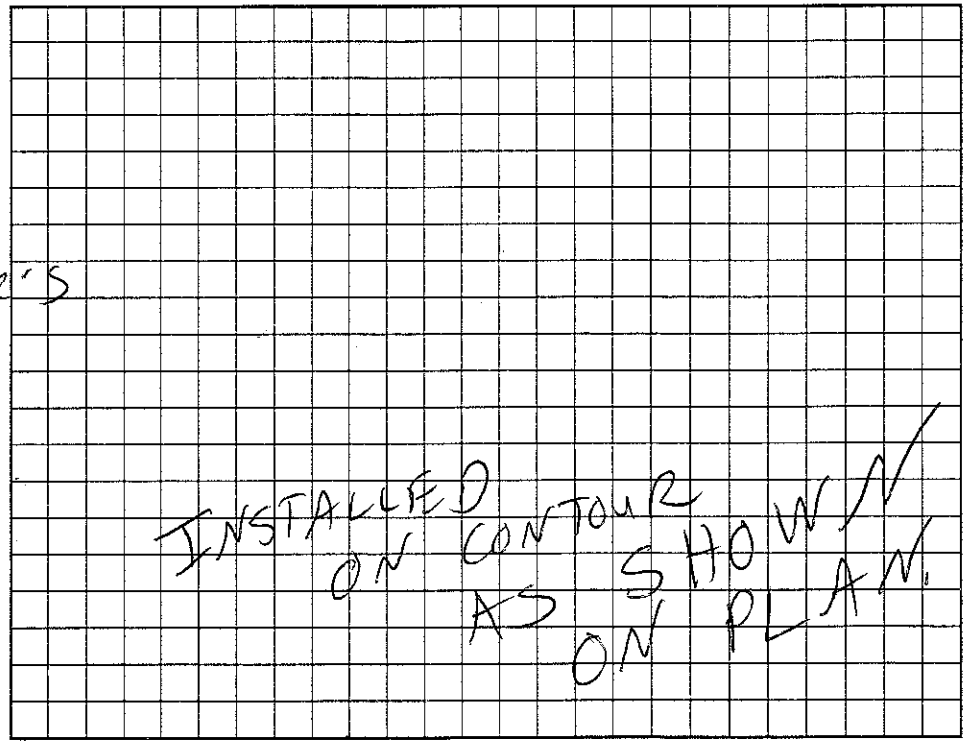


Permit can be suspended or revoked if any false information is supplied toward securing the permit/any unauthorized changes are made to the site/any unauthorized changes are made in the installation of the system. Improvement Permit with plat valid without expiration. Improvement Permit with site plan valid for sixty months. Authorization to Construct is valid for a period equal to that of Improvement Permit – not to exceed sixty months.

Signed: James P. Wilson date 7/23/02 Installed by: FJ ERVIN

Improvement Permit by: C. [illegible] HS date 7/23/02 Operation Permit by: C. [illegible] HS date 8/1/02

Authorization to Construct by: C. [illegible] HS date 7/23/02 Existing System Inspection by: date

HEALTH DEPT. COPY: WHITE OWNER COPY (FINAL): YELLOW OWNER COPY (INITIAL): PINK

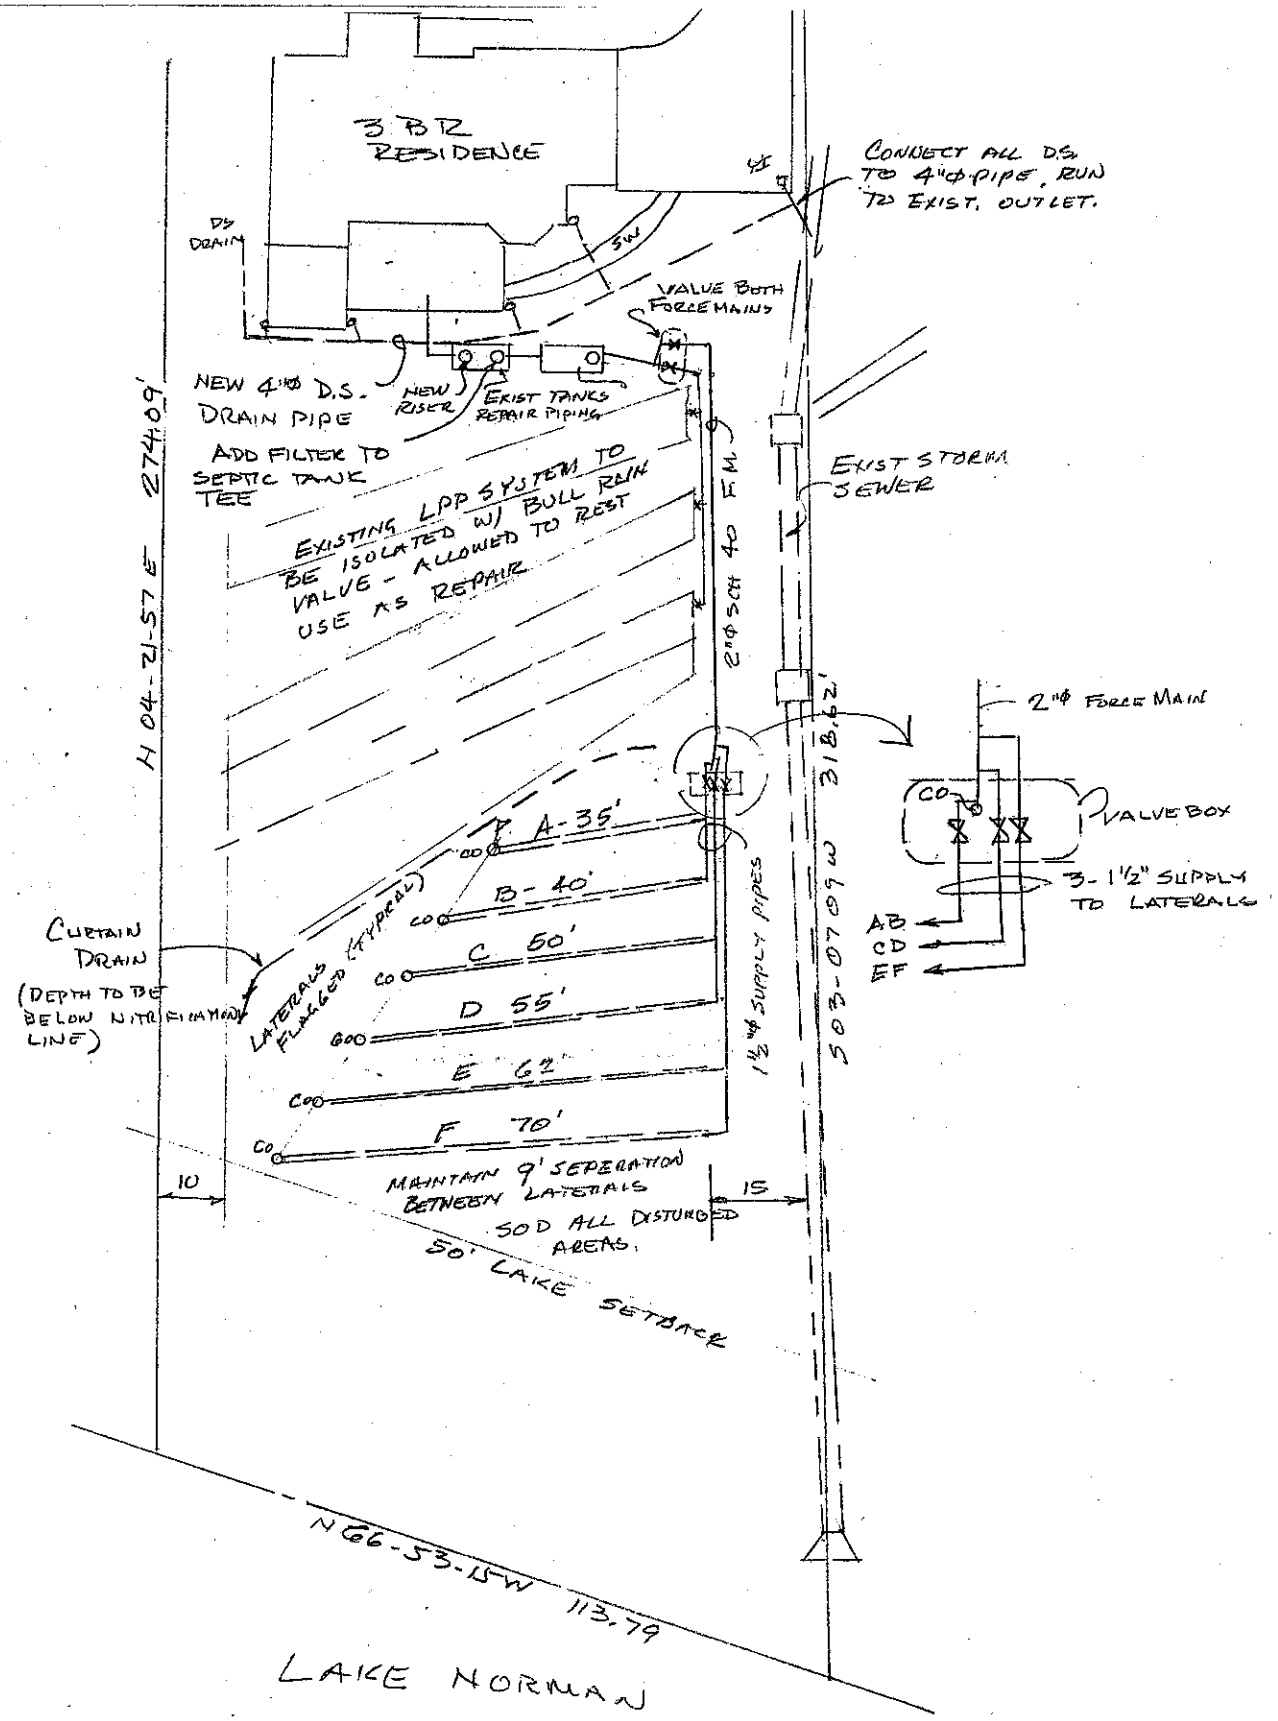

SEPTIC SYSTEM REPAIR
JIM WILSON RESIDENCE
183 HIGH LAKE DR
TROUTMAN, IREDELL CO NC
MAY 14 02 SCALE 1"=20', BKB

5-14-02

NORTH CAROLINA PROFESSIONAL SEAL 3370 ENGINEER B. K. BARRINGER, JR.

PIEDMONT DESIGN ASSOCIATES, P.A.
SUITE 104 WESTFIELD CENTER
125 EAST PLAZA DRIVE
MOORESVILLE, NC 28115