IREDELL COUNTY HEALTH DEPARTMENT

STATESVILLE 704-878-5305 MOORESVILLE 704-664-5281

IMPROVEMENT PERMIT / AUTHORIZATION TO CONSTRUCT / OPERATION PERMIT / EXISTING SYSTEM INSPECTION

PERMIT# 25030/8744 PIN# 4710-39-8326 DATE 1-8-99

OWNER OR CONTRACTOR JIM & SUE BULLARD PHONE: Business (630) 545-0079 Home (630) 469-9232

ADDRESS 178 CRANSTON COURT, GLEN ELLYN, IL 60137

LOCATION BUFFALO SHOALS RD, TL LAUREL COVE, TL HARBOR POINTE, TL HIGH LAKE DRIVE, 7th LAKE FRONT LOT ON LEFT

SUBDIVISION HARBOR WATCH BLOCK / SECTION I LOT 7/7A LOT AREA 1.361 ACRES SITE CLASS PS DESIGN FLOW 300 L.T.A.R. C.30 GAD/FT

Septic Tank: 1000 Gallons; STB 825 Date 4-8-20

Pump Tank: 1000 Gallons; PT 302 Date 4/7/00

Pump Make: ZOELLER Model E/91A Serial No.

Nitrification Field: No Fields 1 Square Feet 600 TO 1200 Linear Feet 200

No Lines FOUR Trench Width 24" Max Trench Bottom Depth 36"

[X] New System [ ] Repair System Type: I, II, (III), IV, V, VI

System Description: PPBPS, PUMP-FED

Repair System Description: PPBPS, PUMP FED

Maintenance Agreement Required: [ ] Yes [X] No

Gravel Depth SAND 6"

[X] House/Mod. Home [ ] Mobile Home [ ] Business [ ] Other

No. Bedrooms 3 No. Bathrooms 2.5 No. Employees

[ ] Slab [X] Crawl Space [ ] Basement w/plumbing [ ] Basement wo/plumbing


Water Supply: [X] Individual [ ] Public [ ] Community WELL

Comments/Conditions: (1) INSTALL FORM-FOUR (44) PPBPS PANELS IN FOUR EQUAL LENGTH LINES (2) USE DUCTILE IRON SUPPLY LINE BENEATH AREAS SUBJECT TO VEHICULAR TRAFFIC (3) SEE ATTACHED SHEETS FOR PUMP & PRES. MANIFOLD REQUIREMENTS


Comments/Conditions: May 16 2000 Lines installed as shown.
May 31-2000 Tanks set & Manifold box installed
June 1 2000 Pressure Set

SCALE: 1" = 50'

INITIAL SITE SKETCH

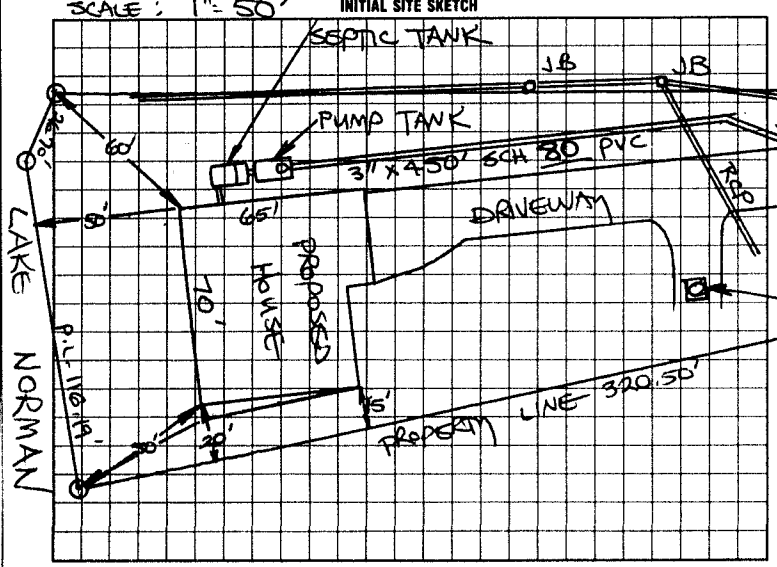

AS BUILT SKETCH

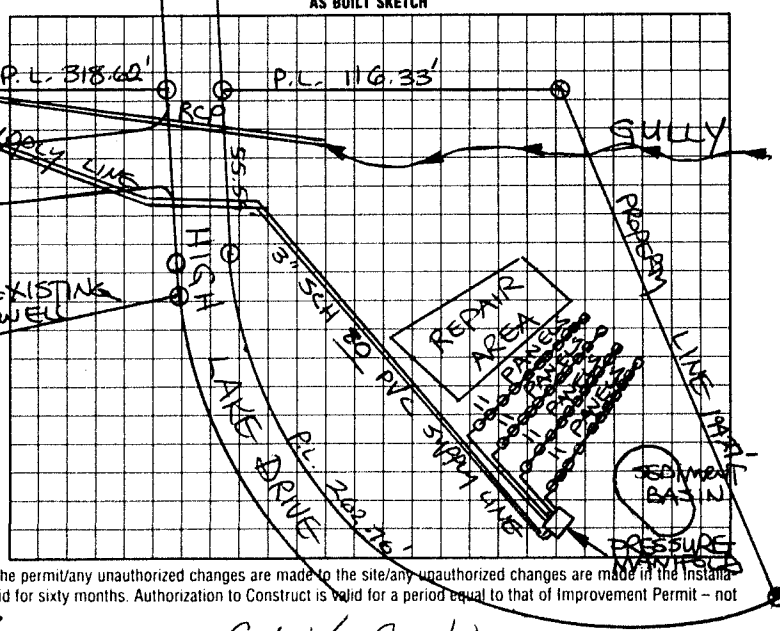

I understand that this permit can be suspended or revoked if any false information is supplied toward securing the permit/any unauthorized changes are made to the site/any unauthorized changes are made in the installation of the system. Improvement Permit with plat valid without expiration. Improvement Permit with site plan valid for sixty months. Authorization to Construct is valid for a period equal to that of Improvement Permit – not to exceed sixty months.

Signed: Simon McCormack, Jr. date 1-14-99 Installed by: C & W Grading

Improvement Permit by: STEVE HEDRICK date 1-8-99 Operation Permit by: STEVE HEDRICK date 7-21-2000

Authorization to Construct by: STEVE HEDRICK date 1-8-99 Existing System Inspection by: date

HEALTH DEPT. COPY: WHITE INSPECTION COPY (FINAL) GREEN OWNER COPY (FINAL) YELLOW INSPECTION COPY (INITIAL) PINK OWNER COPY (INITIAL) GOLD