IREDELL COUNTY HEALTH DEPARTMENT

STATESVILLE 704-878-5305 (C) MOORESVILLE 704-664-5281

IMPROVEMENT PERMIT / AUTHORIZATION TO CONSTRUCT / OPERATION PERMIT / EXISTING SYSTEM INSPECTION

(J)

PERMIT# 103812 PIN# 4710-47-9898 DATE 4-23-02

OWNER OR CONTRACTOR TILLEY, WILLIAM D. & ROBINETTE C. PHONE: Business 704-902-0881 Home 704-876-2601

ADDRESS 156 AIRPORT ROAD, STATESVILLE, NC 28677

LOCATION BUFFALO SHOALS ROAD, TL LAUREL COVE ROAD, AT END OF CUL-DE-SAC

SUBDIVISION LAUREL COVE BLOCK / SECTION ____ LOT 23 LOT AREA LIMITED SITE CLASS PS DESIGN FLOW 240 L.T.A.R. 0.30 GPD/FT²

Septic Tank: 1000 Gallons: STB 1000 Date 3-19-02
Pump Tank: ____ Gallons: PT ____ Date ____
Pump Make: ____ Model ____ Serial No. ____
Nitrification Field: No Fields 1 Square Feet 810 Linear Feet 270
No Lines TWO Trench Width 36" Max Trench Bottom Depth 36" Gravel Depth 12"

☑ New System ☐ Repair System Type: I (II) III IV V VI
System Description: CONVENTIONAL, GRAVITY
Repair System Description: 25% REDUCTION, GRAVITY
Maintenance Agreement Required: ☐ Yes ☑ No
☑ Slab ☐ Crawl Space ☑ Basement w/plumbing ☐ Basement wo/plumbing


☑ House/Mod Home No. Bedrooms 2
☐ Mobile Home No. Bathrooms ____
☐ Business No. Employees ____
☐ Other ____

Water Supply: ☑ Individual ☐ Public ☐ Community
WELL


Comments/Conditions: (1) EXISTING WELL (SHOWN) TO BE ABANDONED ACCORDING TO TITLE 15A NCAC, CHAPTER 2C (ATTACHED)
(2) KEEP SYSTEM MINIMUM 50' FROM 760' CONTOUR LINE.

Comments/Conditions: SEPTIC TANK WITH RISER INSTALLED USING "POLYLOK" FILTER

INITIAL SITE SKETCH

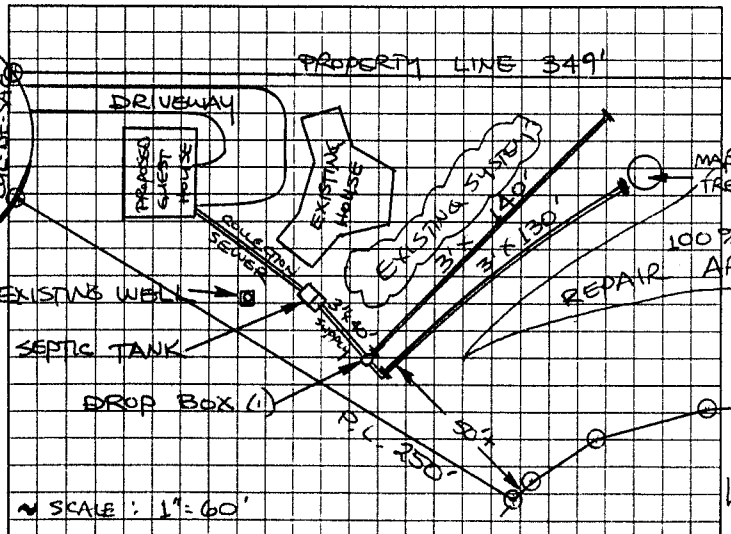

AS BUILT SKETCH

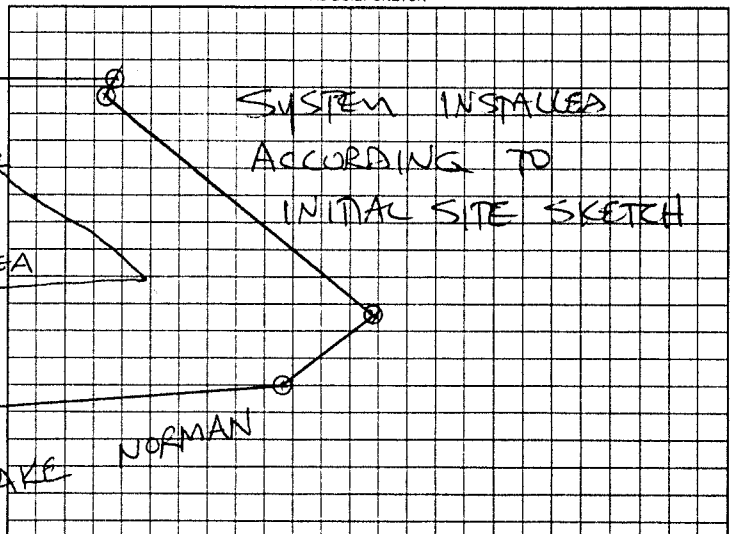

Permit can be suspended or revoked if any false information is supplied toward securing the permit/any unauthorized changes are made to the site/any unauthorized changes are made in the installation of the system. Improvement Permit with plat valid without expiration. Improvement Permit with site plan valid for sixty months. Authorization to Construct is valid for a period equal to that of Improvement Permit – not to exceed sixty months.

Signed: [signature] date 4-24-02 Installed by: C & W GRADING

Improvement Permit by: STEVE HEDRICK date 4-23-02 Operation Permit by: STEVE HEDRICK date 5-3-02

Authorization to Construct by: STEVE HEDRICK date 4-23-02 Existing System Inspection by: ____ date ____

HEALTH DEPT. COPY: WHITE OWNER COPY (FINAL) YELLOW OWNER COPY (INITIAL) PINK