IREDELL COUNTY HEALTH DEPARTMENT

STATESVILLE 704-878-5305 MOORESVILLE 704-664-5281

IMPROVEMENT PERMIT / AUTHORIZATION TO CONSTRUCT / OPERATION PERMIT / EXISTING SYSTEM INSPECTION

PERMIT# 25924 PIN# 4710 48 4801 DATE 7-23-98

OWNER OR CONTRACTOR Curtis Wuellner PHONE: Business Home 528 0808

ADDRESS 120 moonglow Ln Troutman

LOCATION Buffalo Shoals TL Laurel Cove 1.2 mi Rt.

SUBDIVISION Laurel Cove BLOCK / SECTION LOT 137 1/2 1/2 LOT AREA 1 acre SITE CLASS PS DESIGN FLOW 360 L.T.A.R. 1.3

Septic Tank: 1000 Gallons; STB 1012 Date 8-29-00
Pump Tank: Gallons; PT Date
Pump Make: Model Serial No.
Nitrification Field: No Fields 1 Square Feet 1200 Linear Feet 400
No Lines 4 Trench Width 36" Max Trench Bottom Depth 36" Gravel Depth 12"

☑ New System ☐ Repair System Type: I II III IV V VI
System Description: Conv Gravity Jun
Repair System Description: Gravity Pipe Stack
Maintenance Agreement Required: ☐ Yes ☐ No


☐ House/Mod. Home No. Bedrooms 3
☐ Mobile Home No. Bathrooms 2.5
☐ Business No. Employees
☐ Other
☐ Slab ☐ Crawl Space ☑ Basement w/plumbing ☐ Basement wo/plumbing

Water Supply: ☑ Individual ☐ Public ☐ Community


Comments:/Conditions: Replaces Permit Issued 7-11-97
Added 1/2 lot + moved Home back Taunt Road 288' Lake

Comments:/Conditions: * Note Hi-Tech rock middle lines Installed as shown

INITIAL SITE SKETCH

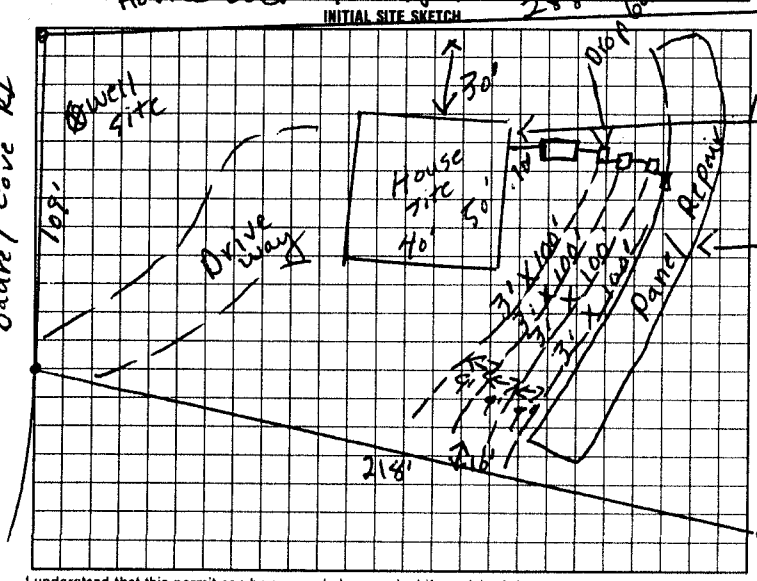

AS BUILT SKETCH

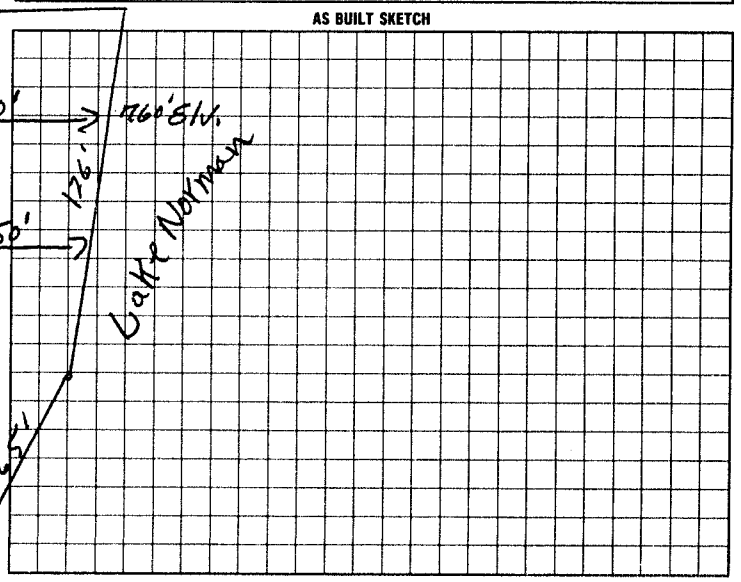

Laurel Cove Rd

I understand that this permit can be suspended or revoked if any false information is supplied toward securing the permit/any unauthorized changes are made to the site/any unauthorized changes are made in the installation of the system. Improvement Permit with plat valid without expiration. Improvement Permit with site plan valid for sixty months. Authorization to Construct is valid for a period equal to that of Improvement Permit – not to exceed sixty months.

Signed: X Curtis A. Wuellner date 7/23/98 Installed by: David Yountz

Improvement Permit by: R. C. Moore date 7-23-98 Operation Permit by: [illegible] date 9-29-00

Authorization to Construct by: R. C. Moore date 7-23-98 Existing System Inspection by: date

HEALTH DEPT. COPY: WHITE INSPECTION COPY (FINAL): GREEN OWNER COPY (FINAL): YELLOW INSPECTION COPY (INITIAL): PINK OWNER COPY (INITIAL): GOLD