4710.48.3880

The proposed House addition does not appear to impact the existing septic system.
**NOTE: 3 BDR Septic has 3 BDR House PlANS

[signature] R.S.
Date: 11-14-08
ICHD-Environmental Health Division

Adding 2nd floor to existing home.

IREDELL COUNTY HEALTH DEPARTMENT

STATESVILLE 704-878-5305 Paid 175.00 MOORESVILLE 704-664-5281

IMPROVEMENT PERMIT / AUTHORIZATION TO CONSTRUCT / OPERATION PERMIT / EXISTING SYSTEM INSPECTION

PERMIT# 25924/91246 PIN# ~~4710 48 4301~~
OWNER OR CONTRACTOR Curtis Wuellner
ADDRESS 124 Meadowview Ln Troutman N.C. PHONE: Business 645 5042 DATE 10-2-00 Home 528-0808
LOCATION Buffalo Shoals TL Laurel Cove 1.2 mi Rt
SUBDIVISION Laurel Cove BLOCK / SECTION ____ LOT B+L212 LOT AREA 1 acres SITE CLASS PS DESIGN FLOW 360 LTAR .3

Septic Tank: 1000 Gallons; STB 1012 Date 8-29-00
Pump Tank: ____ Gallons; PT ____ Date ____
Pump Make: ____ Model ____ Serial No. ____
Nitrification Field: No Fields 1 Square Feet 1200 Linear Feet 400
No Lines 4 Trench Width 36" Max Trench Bottom Depth 36" Gravel Depth 12"

✓ New System [ ] Repair System Type: I (II) III IV V VI
System Description: Conv. Gravity
Repair System Description: Gravity 50% Reduction
Maintenance Agreement Required: [ ] Yes [ ] No

✓ House/Mod Home No Bedrooms 3
Mobile Home No Bathrooms 2 1/2
Business No Employees ____
Other ____


[ ] Slab [ ] Crawl Space ✓ Basement w/plumbing [ ] Basement wo/plumbing

Water Supply: ✓ Individual [ ] Public [ ] Community


Comments/Conditions: Home owner decided to move Driveway - Existing Septic Tank was in way - needed to be moved to location as shown below

Comments/Conditions: Drain lines Installed 9-27-00

INITIAL SITE SKETCH

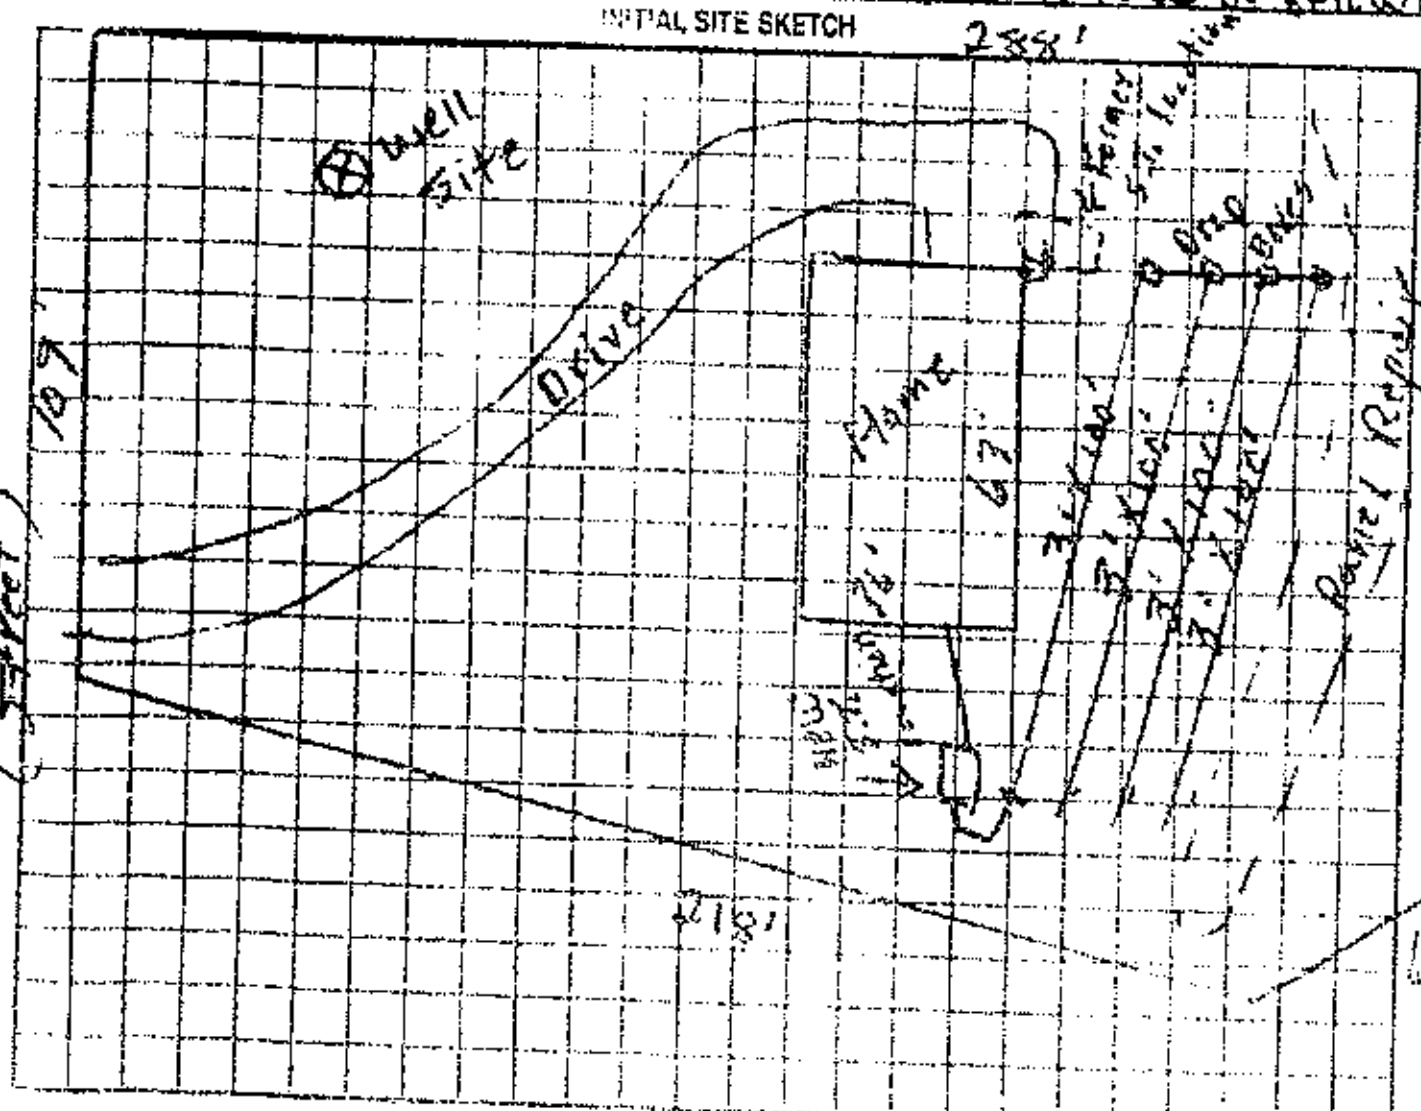

AS BUILT SKETCH

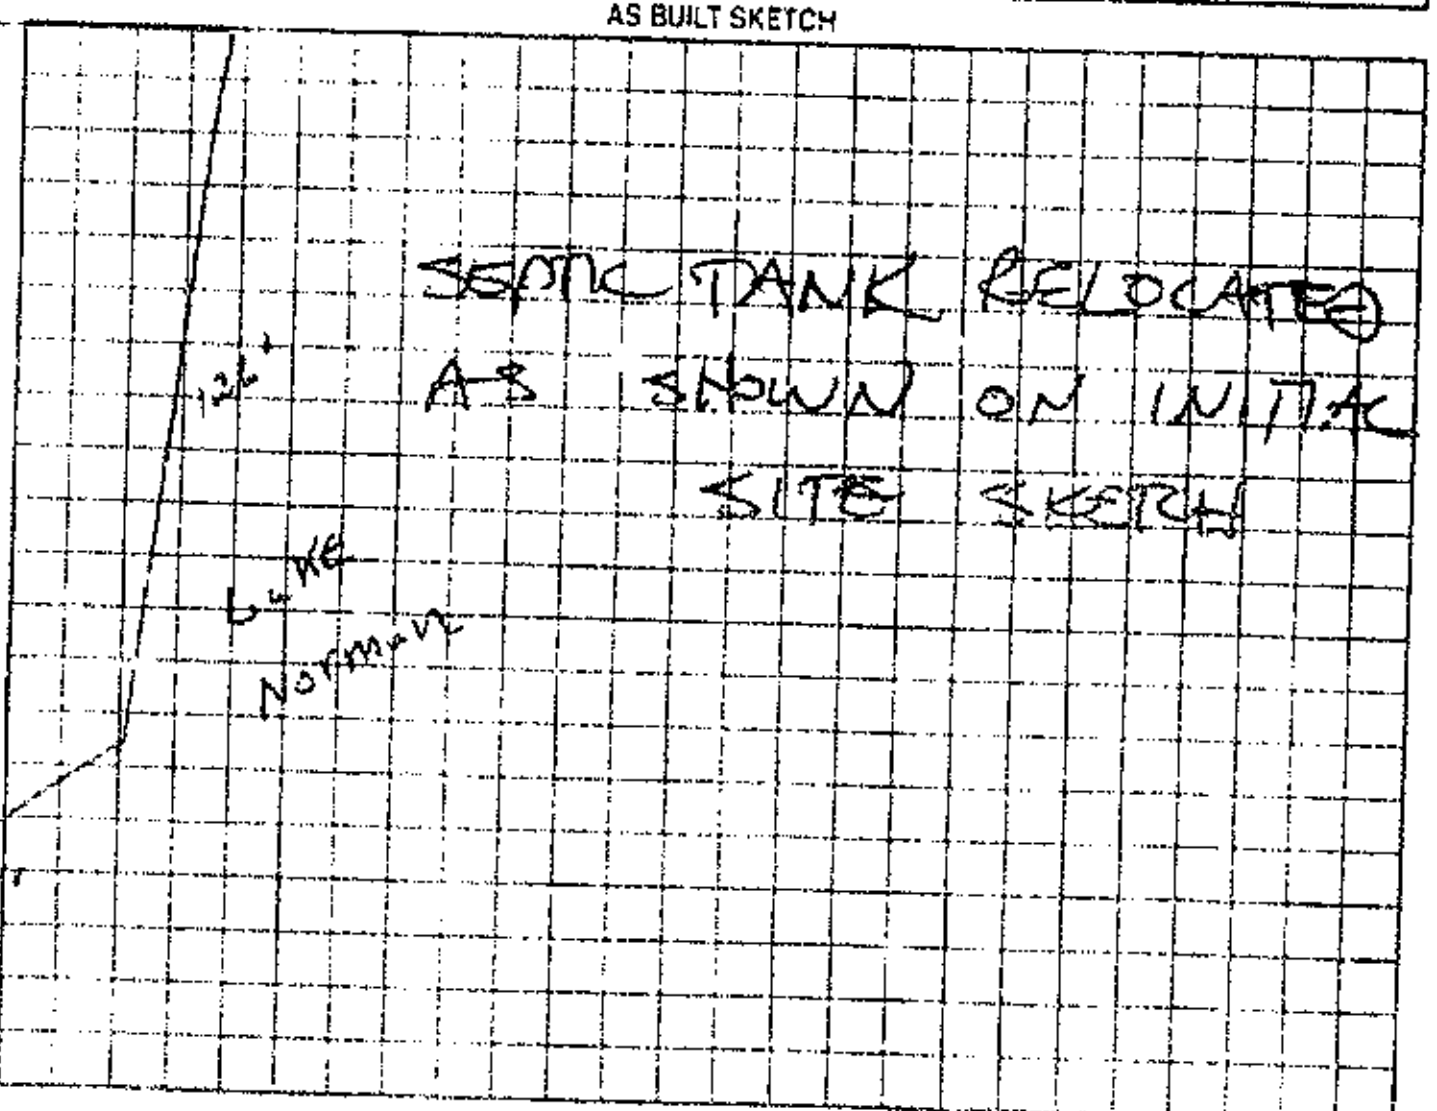

Permit can be suspended or revoked if any false information is supplied toward securing the permit/any unauthorized changes are made to the site/any unauthorized changes are made in the installation of the system. Improvement Permit with plat valid without expiration. Improvement Permit with site plan valid for sixty months. Authorization to Construct is valid for a period equal to that of Improvement Permit - not to exceed sixty months

Signed [signature] date 10/3/00 Installed by DAVID YOUNTZ
Improvement Permit by [signature] date [illegible] Operation Permit by [signature] date 10 6 00
Authorization to Construct by [signature] date [illegible] Existing System Inspection by ____

JAN. 3, 1989 0:47