This Permit Voids Permit Issued on 10-2-98

IREDELL COUNTY HEALTH DEPARTMENT

STATESVILLE 704-878-5305 MOORESVILLE 704-664-5281

IMPROVEMENT PERMIT / AUTHORIZATION TO CONSTRUCT / OPERATION PERMIT / EXISTING SYSTEM INSPECTION

PERMIT# 75712 PIN# 4716 48 5575 DATE June 22, 99

OWNER OR CONTRACTOR Jerry C. Graham PHONE: Business Home 612533 6890 704-450-8599

ADDRESS 13515 Mayview Ct Mint Tonka Mn.

LOCATION Buffalo Shoals ⓛ Laurel Cove ~1 mile on Right

SUBDIVISION Laurel Cove BLOCK / SECTION LOT 16 LOT AREA ~1 Ac SITE CLASS. PS DESIGN FLOW 360 L.T.A.R. .3

Septic Tank: 1000 Gallons; STB 786 Date 5 4 99
Pump Tank: 1000 Gallons; PT 32 Date 4 23 99
Pump Make: Zoeller ½ Hp Model N 163 E Serial No. 630002
Nitrification Field: No Fields 1 Square Feet 1200 Linear Feet 200
No Lines 5 @ 40' Trench Width 24" Max Trench Bottom Depth 36" Gravel Depth N/A

☒ New System ☐ Repair System Type: I, II, III, (IV) V, VI
System Description: 50% Reduction Low Pressure
Repair System Description: Same on Alternate
Maintenance Agreement Required: ☑ Yes ☐ No


☐ House/Mod. Home No. Bedrooms 3
☐ Mobile Home No. Bathrooms 3
☐ Business No. Employees
☐ Other
☐ Slab ☐ Crawl Space ☑ Basement w/plumbing ☐ Basement wo/plumbing

Water Supply: ☒ Individual ☐ Public ☐ Community WELL


Comments:/Conditions: SEE Attachment Sheets for pump tank & pressure line set-up which become part of this permit. A Certified Sub Surface operator must be on contract before an operation permit can be issued

Comments:/Conditions: 6-29-99 Septic Tank & pump tank inspected and Top 3 Lines 6-28-99 Last Two Line installed & pressure head checked. 9-24-99 - Rema 4 Box & Plugs OK No Power to Alarm No Maintenance Agreement

INITIAL SITE SKETCH

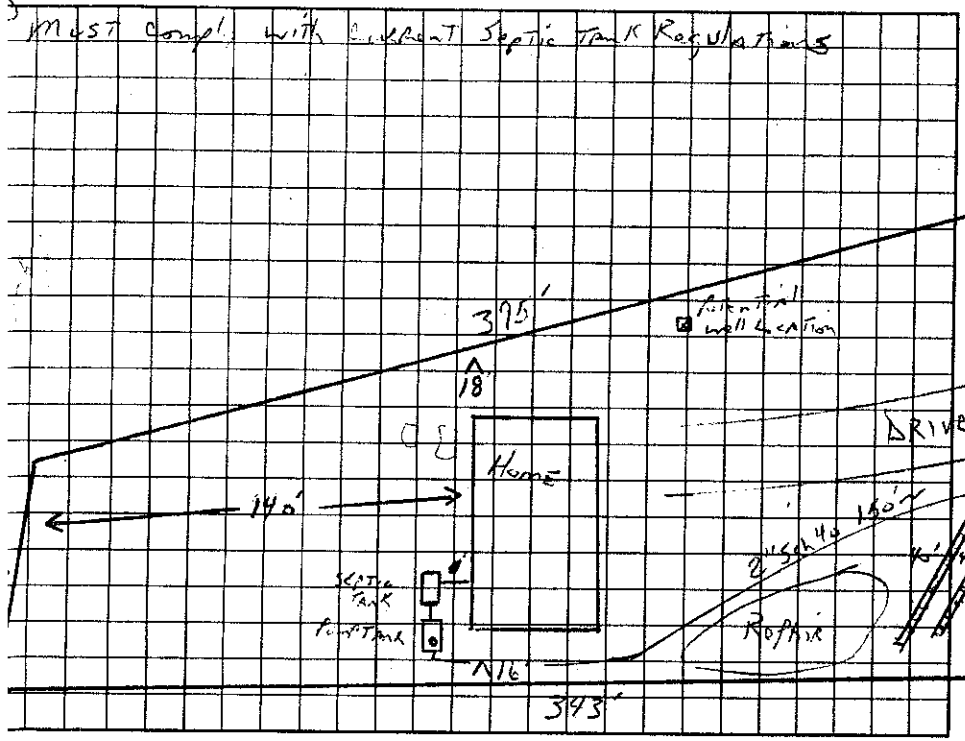

AS BUILT SKETCH

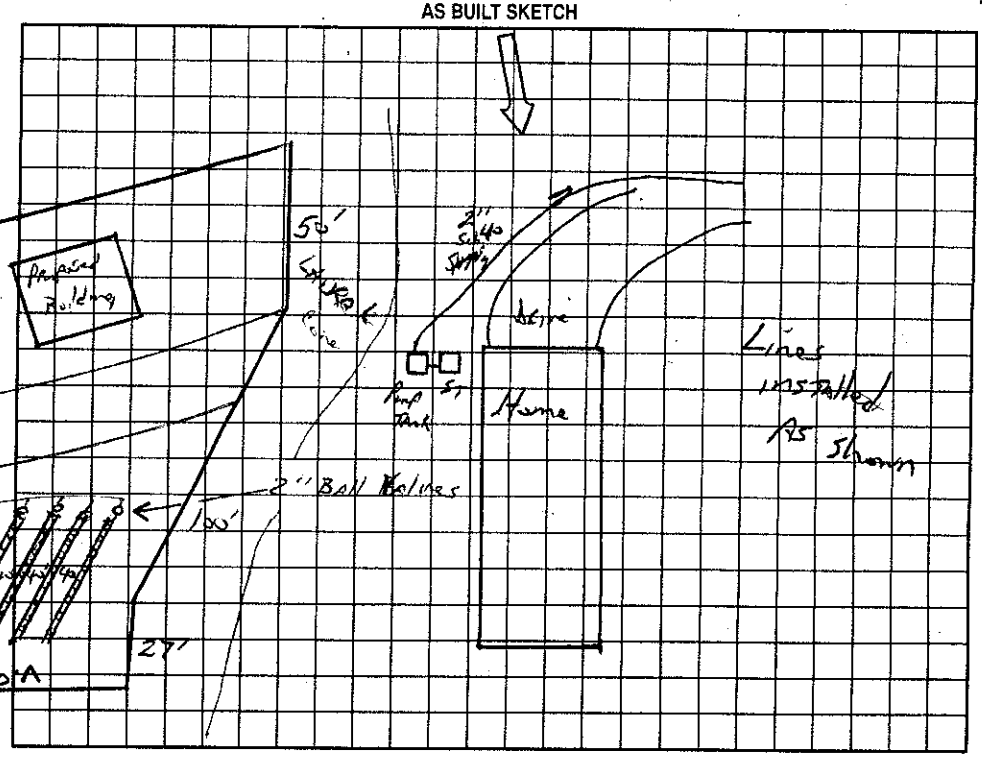

Permit can be suspended or revoked if any false information is supplied toward securing the permit/any unauthorized changes are made to the site/any unauthorized changes are made in the installation of the system. Improvement Permit with plat valid without expiration. Improvement Permit with site plan valid for sixty months. Authorization to Construct is valid for a period equal to that of Improvement Permit -- not to exceed sixty months.

Signed: [signature] date 6-22-99 Installed by:

Improvement Permit by: J.C. Potter date June 22, 99 Operation Permit by: J.C. Potter date Sept 29, 99

Authorization to Construct by: J.C. Potter date June 22, 99 Existing System Inspection by: date

HEALTH DEPT. COPY: WHITE OWNER COPY (FINAL): YELLOW OWNER COPY (INITIAL): PINK