IREDELL COUNTY HEALTH DEPARTMENT

Statesville Office (704) 878-5305 Mooresville Office (704) 660-3625 PERMIT # 205753

IMPROVEMENT PERMIT / AUTHORIZATION TO CONSTRUCT / OPERATION PERMIT / EXISTING SYSTEM

PIN # 4710487879

APPLICANT: John Whitley APPLICANT ADDRESS: 127 Hunter Pointe Mooresville

SITE ADDRESS: 523 Laurel Cove Rd. PHONE: 704-658-9251 ALT. PHONE: N/A


SITE DIRECTIONS: Buffalo Shoals Rd TL Laurel Cove Property on Left.

SUBDIVISION: Crawford Pointe SECTION: N/A LOT # 1 LOT AREA: 4.521 acres DESIGN FLOW: 600gpd L.T.A.R.: 0.3

Septic Tank	1500	(gal)	STB	444-1500	Date	5-30-15	☐ New System	☐ Repair	☐ Expansion	System Type: I II (III) IV V VI		☑ Residence	No. Bedrooms	5	Water Supply								
Pump Tank		(gal)	PT		Date		System Description:	25% Reduction				☐ Business	No. Persons	10	☑ Private								
Pump Make		Model			Serial #		Repair System Description:	25% Reduction				☐ Other	No. Employees		☐ Public								
# Nitrification Fields	1	# Lines	4		Linear Ft:	500	Maintenance Agreement Required:	☐ YES	☑ NO			☐ Slab	☐ Crawl Space		☐ Community								
Trench Width	36"	Max. Trench Bottom Depth	36"		Gravel Depth	N/A	☑ GRAVITY	☐ PRESSURE				☑ Basement w/plumbing			☐ Basement w/o plumbing								

Comments / Conditions: Install a 25% Reduction system on contour with serial distribution. The purpose of this permit was to re-locate septic tank to be a minimum of 100' away from well that was drilled outside the permitted area.

INITIAL SITE SKETCH

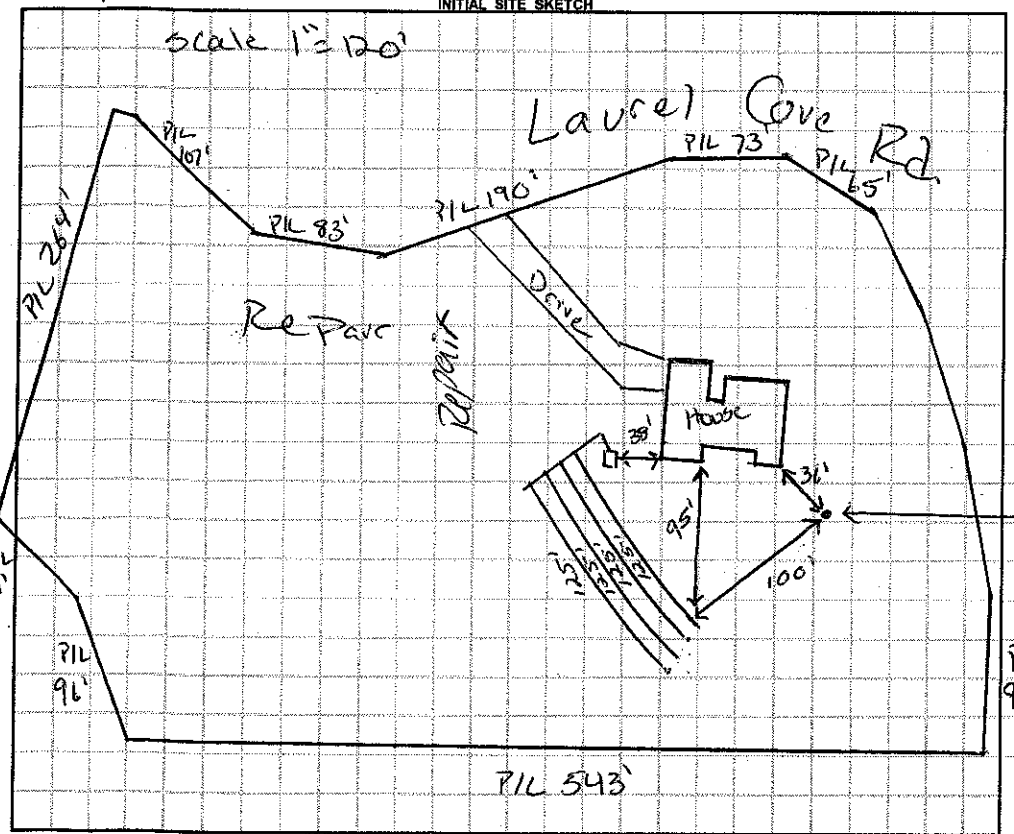

AS BUILT SKETCH

- Red Polylok filter installed
- Quick 4 Chambers installed over ST.
- Risers Installed
- Installed as drawn

Permit can be suspended or revoked if any false information is supplied toward securing the permit / any unauthorized changes are made to the site / any unauthorized changes are made in the installation of the system. **CONTACT A LOCATOR SERVICE PRIOR TO ANY EXCAVATION**

☐ **IMPROVEMENT PERMIT** *with plat valid without expiration.* ☑ **IMPROVEMENT PERMIT** *with site plan valid for 60 mos.* ☑ **AUTHORIZATION TO CONSTRUCT** *valid for period equal to IMPROVEMENT PERMIT--not to exceed 60 mo.*

Owner / Applicant Signature: John R Whitley Date: 7/15/15 Installed by: Kevin Hallowman

IMPROVEMENT PERMIT by: Justin Henderson Date: 7-10-15 OPERATION PERMIT by: Justin Henderson Date: 7-16-15

AUTHORIZATION TO CONSTRUCT by: Justin Henderson Date: 7-10-15 Existing System Inspected by: Date:

Health Dept. Copy - WHITE Applicant (Final Approval) - YELLOW Applicant (Conditional Approval) - PINK