Site Address: 153 High Lake Dr.

(1 THIS PERMIT VOIDS EXPIRED PERMIT #25024

IREDELL COUNTY HEALTH DEPARTMENT

STATESVILLE 704-878-5305 MOORESVILLE 704-664-5281

IMPROVEMENT PERMIT / AUTHORIZATION TO CONSTRUCT / OPERATION PERMIT / EXISTING SYSTEM INSPECTION

PERMIT# 109659 PIN# 4710-49-0853 DATE 10-31-02

OWNER OR CONTRACTOR GEORGE LY PHONE: Business 704-634-5022 Home

ADDRESS 9224 FOUR MILE CREEK ROAD, CHARLOTTE NC 28277

LOCATION BUFFALO SHOALS ROAD TL LAUREL COVE RD, TR HARBORGATE DR TL HARBORWATCH DR, TL HIGH LAKE DR, 6TH LOT ON LEFT

SUBDIVISION HARBOR WATCH BLOCK / SECTION I LOT 1 LOT AREA 0.985 ACRE SITE CLASS PS DESIGN FLOW 360 L.T.A.R. 0.30 GPD/FT²

Septic Tank: 1000 Gallons; STB 1007 Date 12-1-06

Pump Tank: 1000 Gallons; PT 274 Date 12-1-06

Pump Make: GOULDS Model PE5IM Serial No.

Nitrification Field: No Fields 1 Square Feet EQ. DP1200 Lineal Feet 300

No Lines FIVE Trench Width 36" Max Trench Bottom Depth 36" Gravel Depth N/A

☑ New System ☐ Repair System Type: I, II, (III), IV, V, VI

System Description: 25% REDUCTION, PUMP

Repair System Description: 50% REDUCTION, PUMP

Maintenance Agreement Required: ☐ Yes ☑ No

☑ House/Mod. Home No. Bedrooms 3

☐ Mobile Home No. Bathrooms 2

☐ Business No. Employees

☐ Other


☐ Slab ☑ Crawl Space ☑ Basement w/plumbing ☐ Basement wo/plumbing

Water Supply: ☑ Individual ☐ Public ☐ Community WELL


Comments:/Conditions: ① INSTALL 25% REDUCTION SYSTEM ON CONTOUR ② KEEP SYSTEM MINIMUM 100 FEET FROM WELL ③ SEE ATTACHED SHEETS FOR PUMP AND PRESSURE MANIFOLD REQUIREMENTS

Comments:/Conditions: BOLWCO Fith & ICPOR

INITIAL SITE SKETCH SCALE: 1"=50'

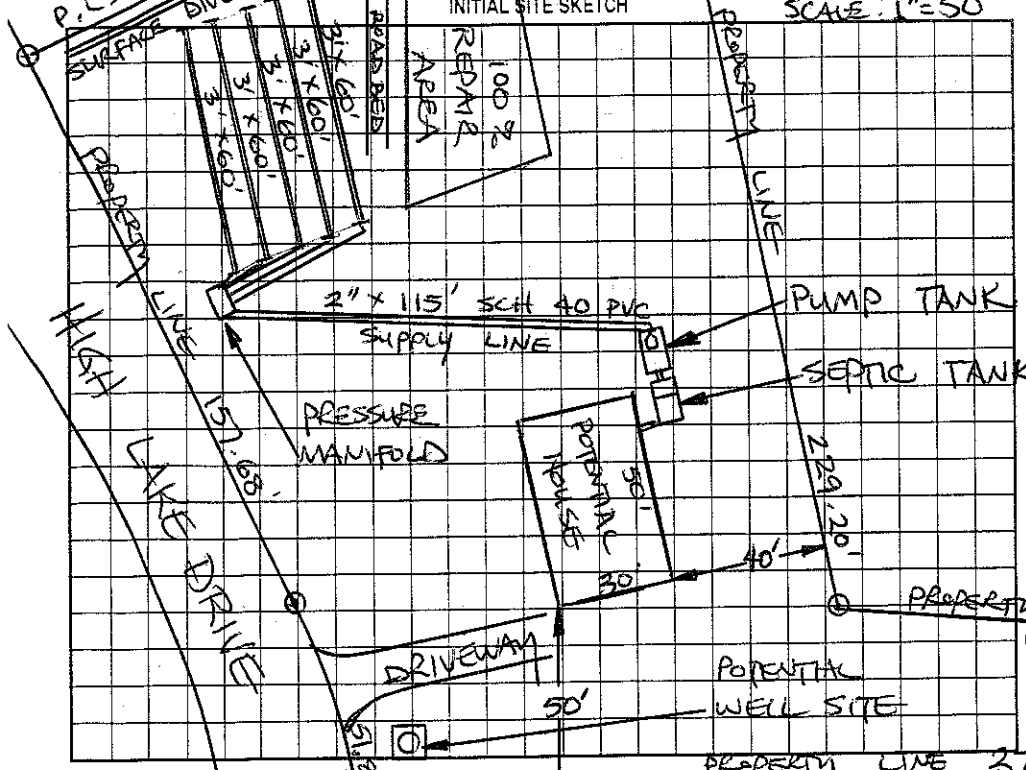

AS BUILT SKETCH

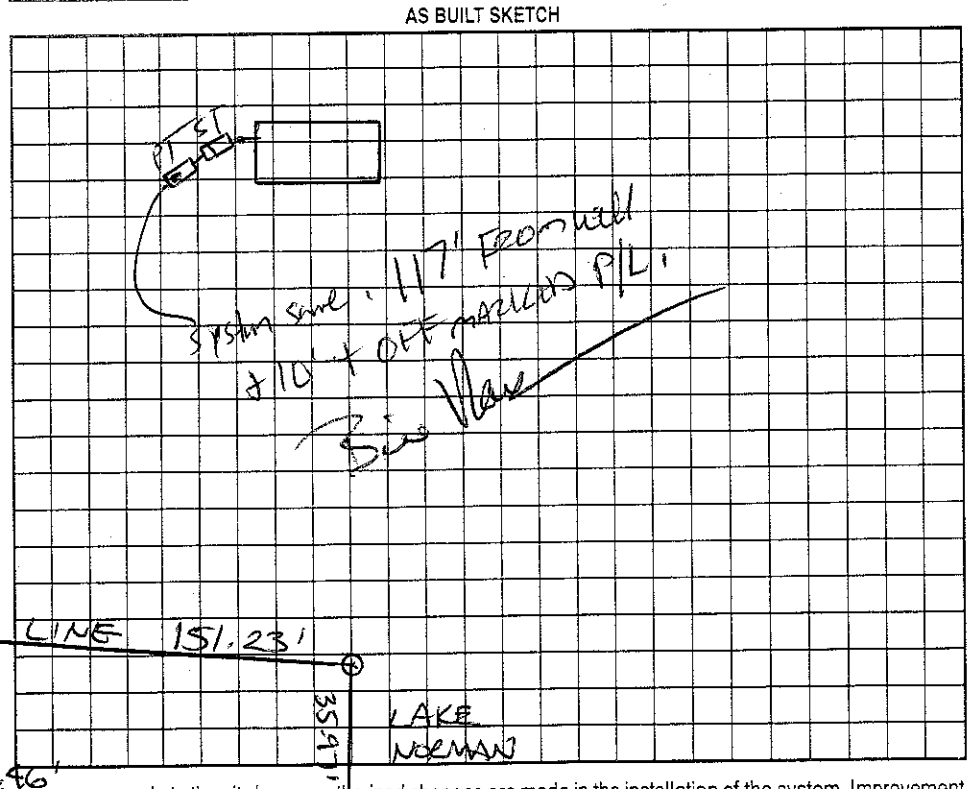

Permit can be suspended or revoked if any false information is supplied toward securing the permit/any unauthorized changes are made to the site/any unauthorized changes are made in the installation of the system. Improvement Permit with plat valid without expiration. Improvement Permit with site plan valid for sixty months. Authorization to Construct is valid for a period equal to that of Improvement Permit – not to exceed sixty months.

Signed: date 10/4/02 Installed by: RICHARD ABERNATHY

Improvement Permit by: STEVE HEDRICK date 10-31-02 Operation Permit by: date 2-26-07

Authorization to Construct by: STEVE HEDRICK date 6-10-05 Existing System Inspection by: date

HEALTH DEPT. COPY: WHITE OWNER COPY (FINAL): YELLOW OWNER COPY (INITIAL): PINK