IREDELL COUNTY HEALTH DEPARTMENT

THIS PERMIT VOIDS PREVIOUS ISSUED 4-16-99

STATESVILLE 704-878-5305 CJ MOORESVILLE 704-664-5281

IMPROVEMENT PERMIT / AUTHORIZATION TO CONSTRUCT / OPERATION PERMIT / EXISTING SYSTEM INSPECTION

PERMIT# 080956 PIN# 4710 49 1638 DATE 4-14-2000

OWNER OR CONTRACTOR L.S. BEAVER CONST. CO PHONE Business (704) 202-1830 Home

ADDRESS 1121 OLD CONCORD RD, SALISBURY, NC 28146

LOCATION BUFFALO SHOALS RD, TL LAUREL COVE, TR ~~HARBOR GATE~~, TL HARBOR WATCH, TL HIGH LAKE, 2ND "LAKE" LOT ON LEFT

SUBDIVISION HARBOR WATCH BLOCK / SECTION I LOT 2 LOT AREA 0.630 ACRE SITE CLASS PS DESIGN FLOW 480 L.T.A.R 0.30 GPD/FT²

Septic Tank: 1000 Gallons; STB 825 Date 4-20-00

Pump Tank: 1000 Gallons; PT 302 Date 5-2-00

Pump Make: Zoeller Model E295 Serial No 00A488

Nitrification Field: No Fields 1 Square Feet 1600 Linear Feet 270

No Lines FIVE Trench Width 24" Max Trench Bottom Depth 36" Depth SAND 6"

✓ New System ☐ Repair System Type: I. II. III. (IV.) V. VI

System Description: 50% REDUCTION, PPBPS LOW PRESSURE

Repair System Description: 50% REDUCTION, LOW PRESS

Maintenance Agreement Required ✓ Yes ☐ No

✓ House/Mod. Home ☐ Residential Duplex ☐ Business ☐ Other

No Bedrooms 3 No. Bathrooms 2½ No Employees


Water Supply: ✓ Individual ☐ Public ☐ Community WELL

☐ Slab ☐ Crawl Space ☐ Basement w/plumbing ☐ Basement wo/plumbing


Comments/Conditions: ① INSTALL LOW-PRESSURE PPBPS USING SIXTY (60) PANELS ACCORDING TO MFG'S SPECIFICATIONS ② SEE ATTACHED SHEETS FOR PUMP & LOW PRESSURE DESIGN CRITERIA ③ KEEP SYSTEM MAXIMUM FEASIBLE DISTANCE FROM WELL (55')

Comments/Conditions: ④ CERTIFIED MANAGEMENT ENTITY SHALL BE CONTRACTED WITH PRIOR TO ISSUANCE OF OPERATION PERMIT

INITIAL SITE SKETCH

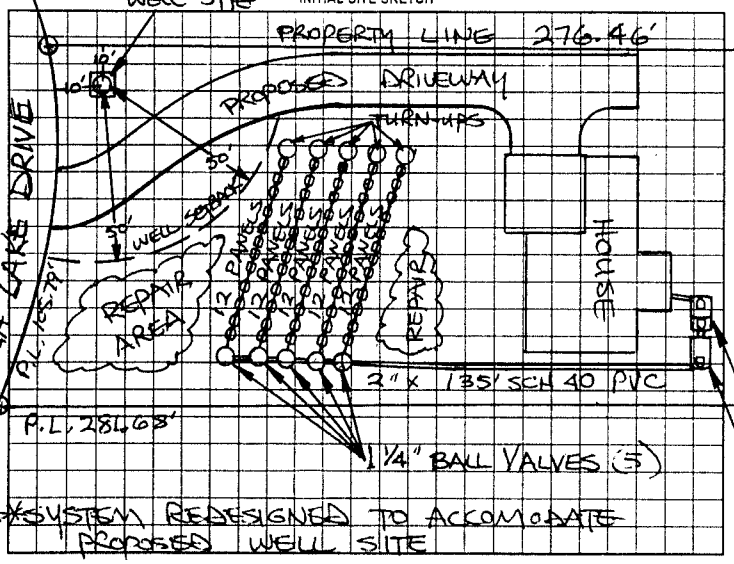

AS BUILT SKETCH

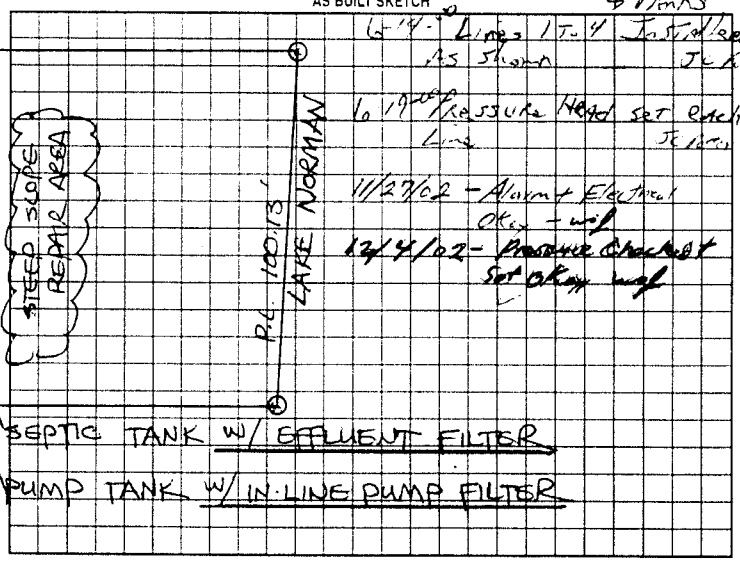

+ Pinks

6 - 1" Lines 1 T. 4 Inside/300 As shown JE

6 - 19 PSI Pressure Heads set each Line JE

11/27/02 - Alarm Electrical Ok - mf

12/4/02 - Pressure Checked Set Ok - mf

Permit can be suspended or revoked if any false information is supplied toward securing the permit/any unauthorized changes are made to the site/any unauthorized changes are made in the installation of the system. Improvement Permit with plat valid without expiration/ Improvement Permit with site plan valid for sixty months. Authorization to Construct is valid for a period equal to that of Improvement Permit – not to exceed sixty months.

Signed: [signature] date 4-17-00 Installed by: Upright Grading + Septic

Improvement Permit by: STEVE HEDRICK date 4-14-2000 Operation Permit by: William C. Johnson date 12/4/02

Authorization to Construct by: STEVE HEDRICK date 4-14-2000 Existing System Inspection by: date

HEALTH DEPT COPY WHITE OWNER COPY (FINAL) YELLOW OWNER COPY (INITIAL) PINK