IREDELL COUNTY HEALTH DEPARTMENT

STATESVILLE 704-878-5305 MOORESVILLE 704-664-5281

IMPROVEMENT PERMIT / AUTHORIZATION TO CONSTRUCT / OPERATION PERMIT / EXISTING SYSTEM INSPECTION

PERMIT# 86843 PIN# 4710 49 4009 DATE 12-17-99

OWNER OR CONTRACTOR Mark Katz PHONE: Business 528 0935 Home

ADDRESS 4509 Forest Glenn Rd Greensboro N.C.

LOCATION Buffalo Shoals Rd TL Laural Cove Rd at lake 10th lot Rt.

SUBDIVISION Laural cove BLOCK / SECTION (INVALID DATES) LOT 10 LOT AREA 20,000 sq ft SITE CLASS. PS DESIGN FLOW 360 L.T.A.R. .3 gpd/sq ft

Septic Tank: 1000 Gallons; STB 1012 Date 2-31-00

Pump Tank: 1000 Gallons; PT 17 Date 10-16-99

Pump Make: CHILDS Model WE10122 Serial No. H9963773

Nitrification Field: No Fields 1 Square Feet 400 Linear Feet 200

No Lines 4 Trench Width 24" Max Trench Bottom Depth 30" Gravel Depth N/A

☑ New System ☐ Repair System Type: I, II, III, IV, V, VI

System Description: Pressure dosed panels

Repair System Description: " " "

Maintenance Agreement Required: ☑ Yes ☐ No

☑ House/Mod. Home No. Bedrooms 3

☐ Mobile Home No. Bathrooms 3

☐ Business No. Employees

☐ Other

☐ Slab ☐ Crawl Space ☐ Basement w/plumbing ☐ Basement wo/plumbing


Water Supply: ☑ Individual ☐ Public ☐ Community

Comments:/Conditions:


Comments:/Conditions: ↳ Pre-engineered structure with conc Pedestal Support Foundation

DRAINFIELD AND TANKS INSPECTED 9-11-2000 - RSA

INITIAL SITE SKETCH

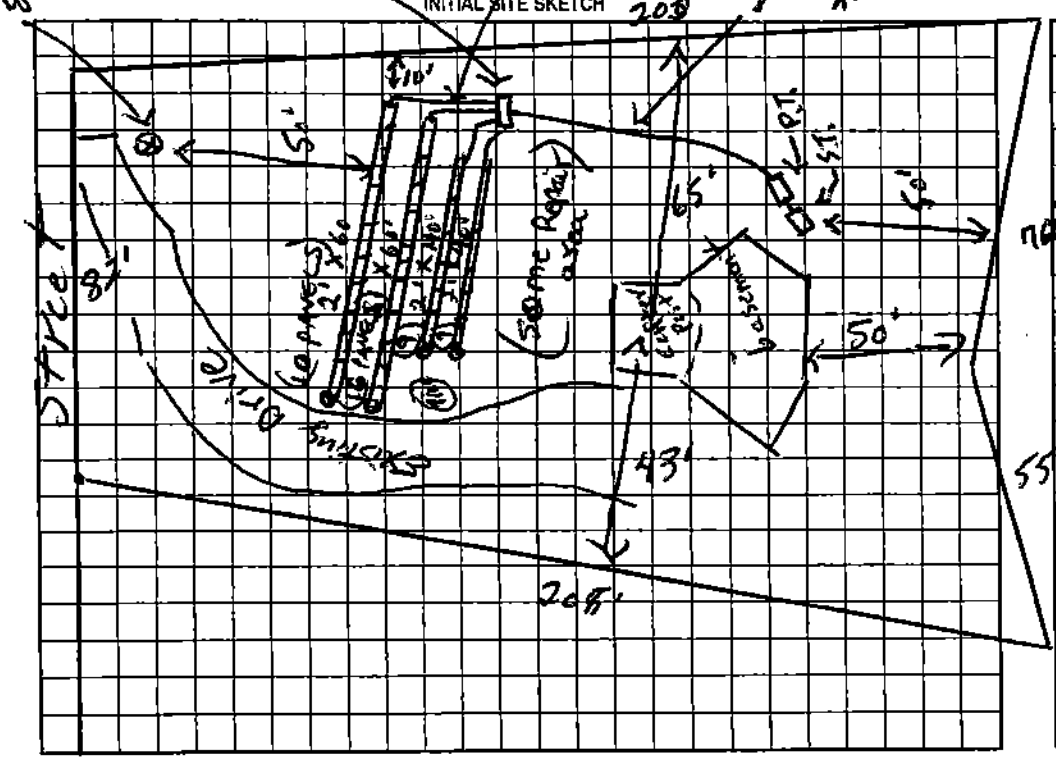

AS BUILT SKETCH

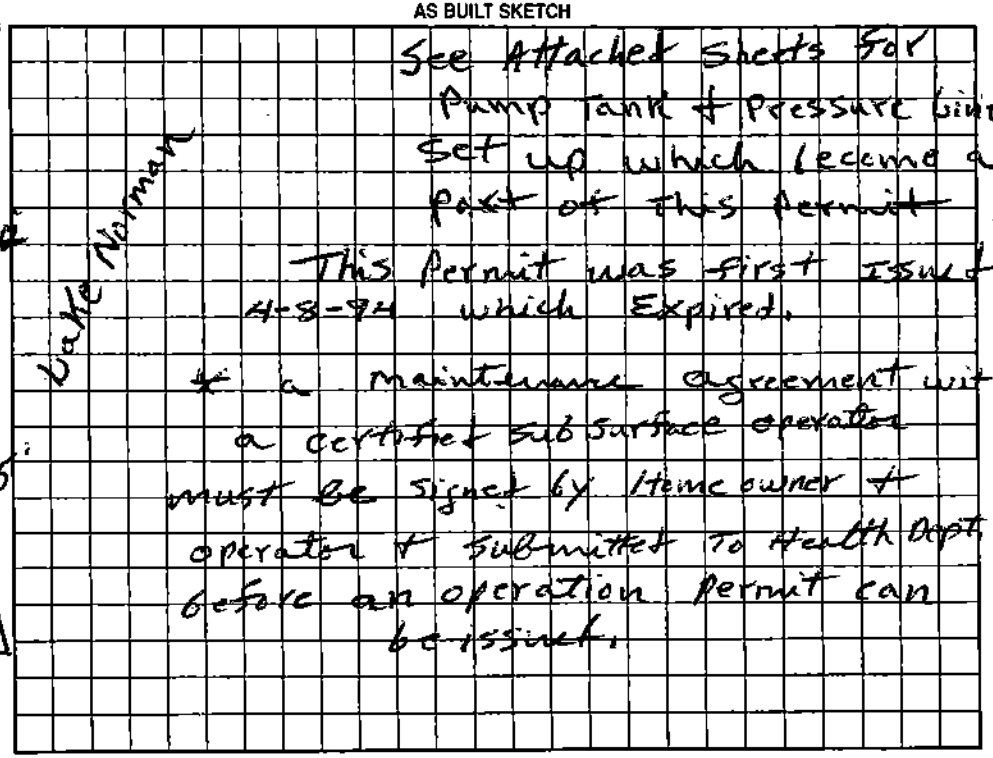

Permit can be suspended or revoked if any false information is supplied toward securing the permit/any unauthorized changes are made to the site/any unauthorized changes are made in the installation of the system. Improvement Permit with plat valid without expiration. Improvement Permit with site plan valid for sixty months. Authorization to Construct is valid for a period equal to that of Improvement Permit – not to exceed sixty months.

Signed: [signature] date 1-10-00

Improvement Permit by: P.C. Moore date 12-17-99

Authorization to Construct by: P.C. Moore date 12-17-99

Installed by: DAVID YOUNTZ

Operation Permit by: STEVE HENDRICK date 11-15-00

Existing System Inspection by: date

HEALTH DEPT. COPY: WHITE OWNER COPY (FINAL): YELLOW OWNER COPY (INITIAL): PINK