IREDELL COUNTY HEALTH DEPARTMENT

Statesville Phone TR 3-7271 Mooresville Phone NO 3-1271

PERMIT TO INSTALL SEPTIC TANK

Permit No. 74 Permit Date May 2. 19__

Owner Benny Daniels Address Arrow Shore

Installed By [illegible] Address [illegible]


Location of Property Arrow Shore Lot, Norman Lines to Chain Link Fence, Lower Left on Step Bank.

Tank		Capacity		Length of Lines		Fixtures	
Block	( )	1000	( )	225'	( )	No. of Baths	(3)
Precast	(✓)	1250	(✓)	250'	( )	Dishwasher	(✓)
		1500	( )	Other 270		Garbage Grdr.	(✓)
		Other				Other	

NOTIFY HEALTH DEPARTMENT AT LEAST EIGHT HOURS BEFORE TANK IS TO BE INSPECTED.

Final Inspection May 24 1972 Approved (✓) Disapproved ( )

Remarks

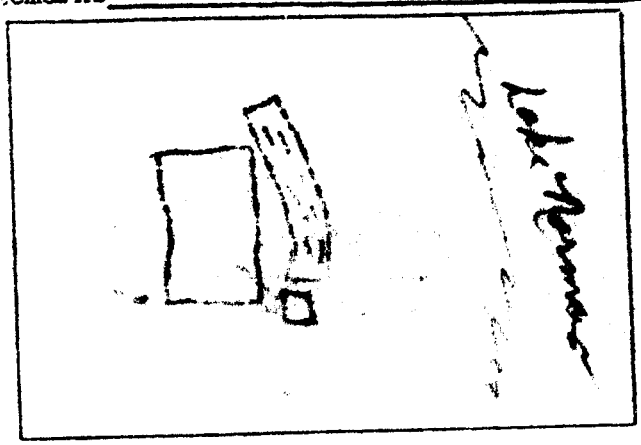

Sketch of Installation

Collin W. Eckerman R.S.

Sanitarian