~~SPRING STORE~~ LOT 50

# EDELL COUNTY HEALTH DEPARTMENT

THIS PERMIT VOIDS PREVIOUS ISSUED 7/15/98

STATESVILLE 704-878-5305 MOORESVILLE 704-664-5281

## PROVEMENT PERMIT / AUTHORIZATION TO CONSTRUCT / OPERATION PERMIT / EXISTING SYSTEM INSPECTION

MIT# 19239 7/017 PIN# TAX MAP 3L-B-70 4710-57-4396 DATE 7-18-98

ER OR CONTRACTOR TILLMAN & MARIETTA KING PHONE: Business (800) 868-8834 Home 643-1779

RESS 9256 ESSEN LANE CHARLOTTE NC 28210

TION I-40 W, TL OLD MTN. RD, TR BUFFALO SHOALS RD, TL PINEVILLE RD, TR SPRING STORE, TR AT END, 2ND LOT ON LEFT BEFORE END.

IVISION ~~W. E. GARDNER~~ BLOCK / SECTION LOT 2 LOT AREA 0.592 ACRE SITE CLASS PS DESIGN FLOW 360 L.T.A.R. 0.3600 ft²

ic Tank: 1000 Gallons: STB 794 Date 5-22-98

p Tank: 1000 Gallons; PT 27 Date 6-22-98

p Make: Hydromatic Model SheE50A1 Serial No. 5788700?

fication Field: No Fields 1 Square Feet BR. to 1200 Linear Feet 204

Lines THREE Trench Width 24" Max Trench Bottom Depth 36" ~~Min~~ Depth 24"

☑ New System ☐ Repair System Type: I, II, III, (IV), V, VI

System Description: PRESSURE-DOSED ABBS

Repair System Description: ~~PRESSURE-DOSED ABBS~~

Maintenance Agreement Required: ☑ Yes ☐ No

☐ House/Mod. Home No. Bedrooms 3

☐ Mobile Home No. Bathrooms 2

☐ Business No. Employees

☐ Other

☐ Slab ☐ Crawl Space ☐ Basement w/plumbing ☐ Basement wo/plumbing

Water Supply: ☐ Individual ☒ ~~Public~~ ☐ Community


irments:/Conditions: FOLLOW DESIGN SPECIFICATIONS PER NEY C. JACOBS RECLASSIFICATION PLAN DATED GUST 1, 1995, REVISED AUG 14, 1995 & JUNE 15, 1998

Comments:/Conditions:

Note: Tank Depth < 36in Not reinforced

8/7 Checked lines, tanks

INITIAL SITE SKETCH SCALE: 1" = 30'

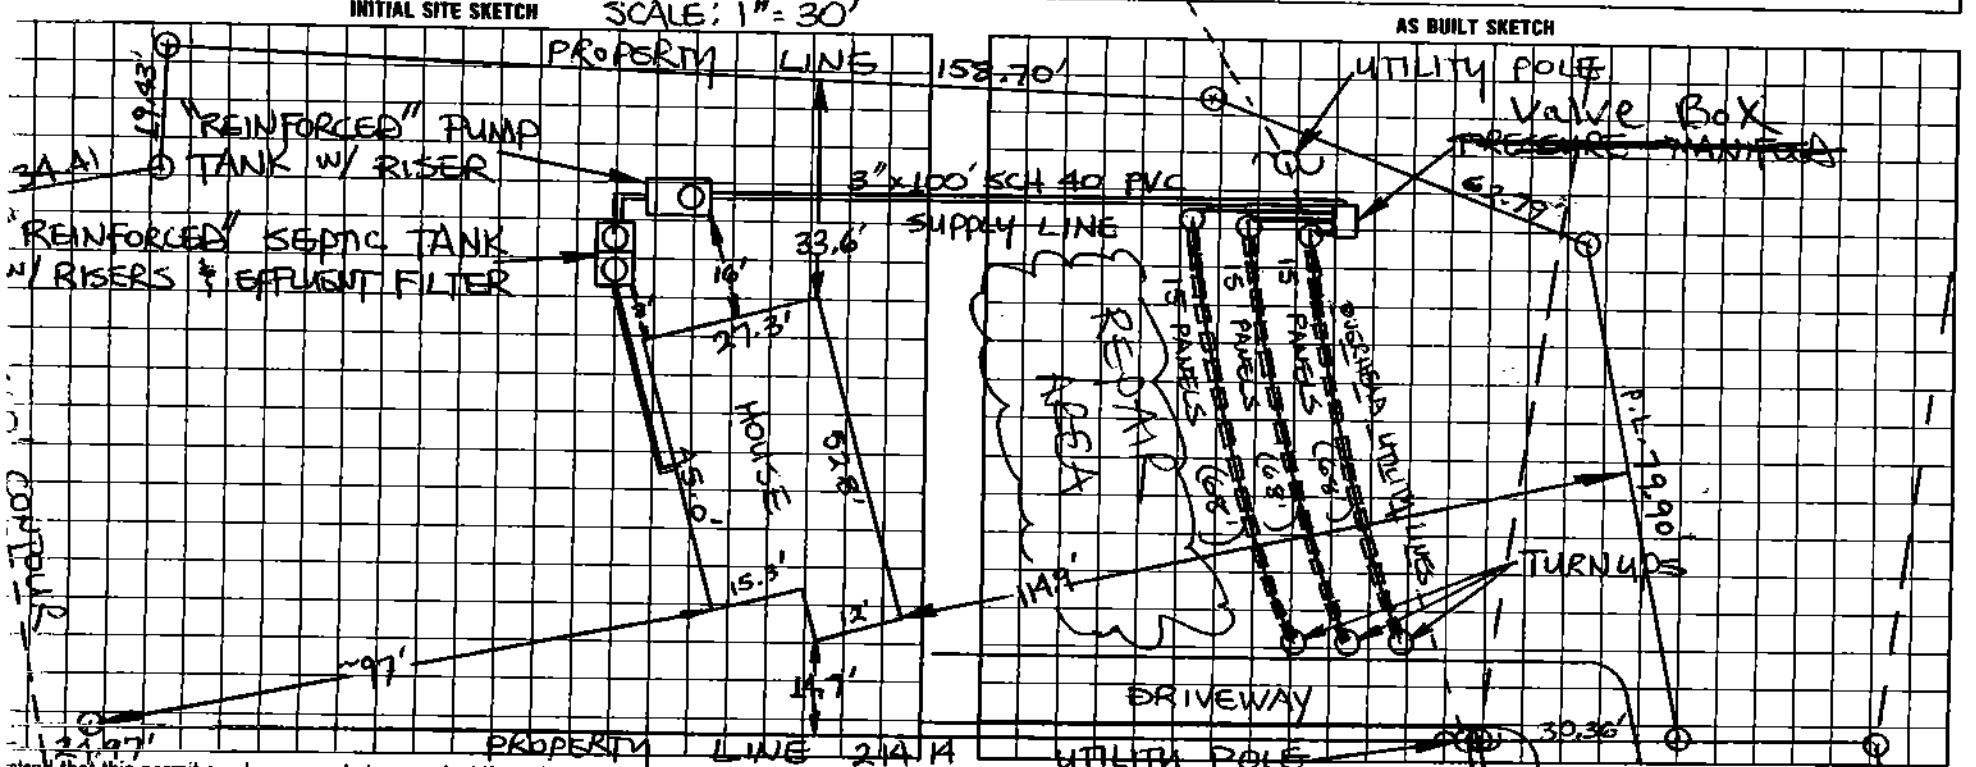


stand that this permit can be suspended or revoked if any false information is supplied toward securing the permit/any unauthorized changes are made to the site/any unauthorized changes are made in the installa-he system. Improvement Permit with plat valid without expiration. Improvement Permit with site plan valid for sixty months. Authorization to Construct is valid for a period equal to that of Improvement Permit – not ed sixty months.

Marietta King date 7-16-98

ement Permit by: STEVE J HENDRICK date 7-13-98

ation to Construct by: STEVE HENDRICK date 7-13-98

Installed by: Tim Amons

Operation Permit by: J. C. Moore date 10-16-98

Existing System Inspection by: date

HEALTH DEPT. COPY: WHITE INSPECTION COPY (FINAL): GREEN OWNER COPY (FINAL): YELLOW INSPECTION COPY (INITIAL): PINK OWNER COPY (INITIAL): GOLD