IREDELL COUNTY HEALTH DEPARTMENT

Statesville Phone TR 3-7271 Mooresville Phone NO 3-1271

PERMIT TO INSTALL SEPTIC TANK

Permit No. 82 Permit Date 5-29 1972

Owner Paul Munday (Jim Whitmire) Address Statesville NC

Installed By York Rufty Address Rt 2 Stony Point NC


Location of Property Spring Shores - Hy Main Road to Lake T.R. on Dead end Road. Last house on L.

Tank		Capacity		Length of Lines		Fixtures	
Block	( )	1000	( )	225'	( )	No. of Baths	(3)
Precast	(✓)	1250	(✓)	250'	( )	Dishwasher	( )
		1500	( )	Other 234		Garbage Grdr.	(1)
		Other				Other	

NOTIFY HEALTH DEPARTMENT AT LEAST EIGHT HOURS BEFORE TANK IS TO BE INSPECTED.

Final Inspection 5-29 1972 Approved (✓) Disapproved ( )

Remarks Community Water

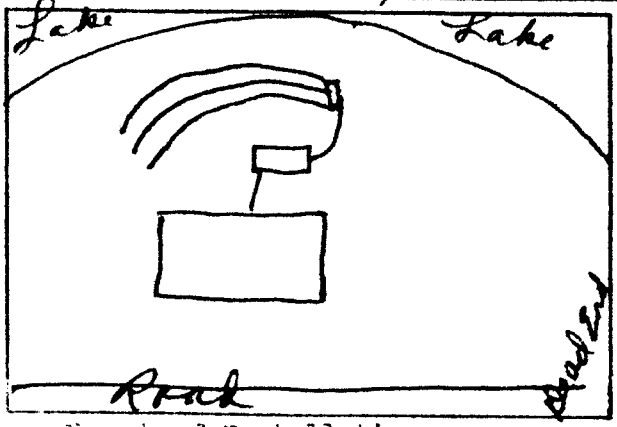

Sketch of Installation

Lines Deep in ground
Extra Stone used.
Soil good

E. G. Stevenson

Sanitarian