IREDELL COUNTY HEALTH DEPARTMENT

Statesville Office (704) 878-5305 Mooresville Office (704) 660-3625 PERMIT # 202032

IMPROVEMENT PERMIT / AUTHORIZATION TO CONSTRUCT / OPERATION PERMIT / EXISTING SYSTEM

PIN # 4710575436

APPLICANT: Howard Rush APPLICANT ADDRESS: 100 Island View Rd Statesville NC 28677

SITE ADDRESS: 100 Island View Rd Statesville NC 28677 PHONE: 336-575-6247 ALT. PHONE: N/A


SITE DIRECTIONS: E Monbo to Pinoville Rd to Spring Shore Rd to Island View Rd

SUBDIVISION: N/A SECTION: N/A LOT # N/A LOT AREA: 0.57 DESIGN FLOW: EX L.T.A.R.: EX


Septic Tank	1000 (gal)	STB	Infiltrator 1050	Date		☐ New System	☒ Repair	☐ Expansion	System Type: I II III IV V VI	☒ Residence	No. Bedrooms 3	Water Supply
Pump Tank	(gal)	PT	Black Plastic	Date		System Description:	Tank Replacement			☐ Business	No. Persons 6	☐ Private
Pump Make	Model		Serial #			Repair System Description:	N/A			☐ Other	No. Employees	☐ Public
# Nitrification Fields	EX # Lines	EX	Linear Ft:	EX		Maintenance Agreement Required:	☐ YES	☒ NO		☐ Slab	☐ Crawl Space	☒ Community
Trench Width	EX Max. Trench Bottom Depth	EX	Gravel Depth	EX			☒ GRAVITY	☐ PRESSURE		☒ Basement w/plumbing	☐ Basement w/o plumbing	

Comments / Conditions: Pump, crush, and fill existing tank. Maintain maximum of 6" of cover over tank. Existing Bed does not meet current set backs to dwlg and may be compromised.

INITIAL SITE SKETCH

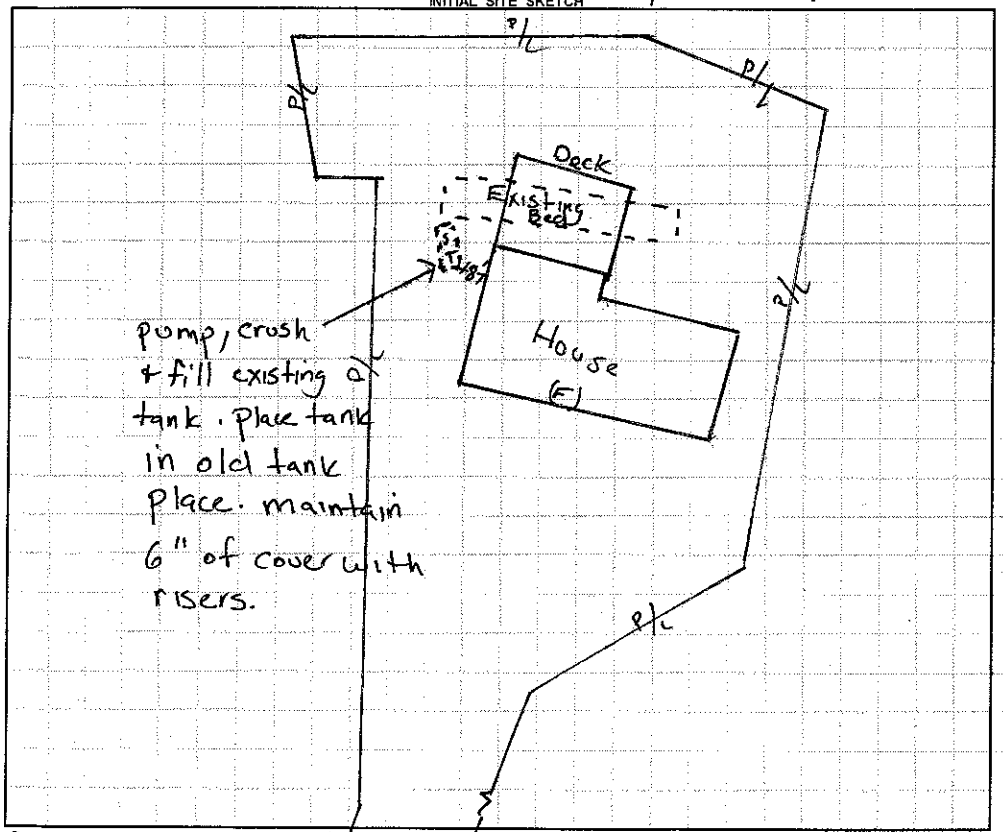

AS BUILT SKETCH

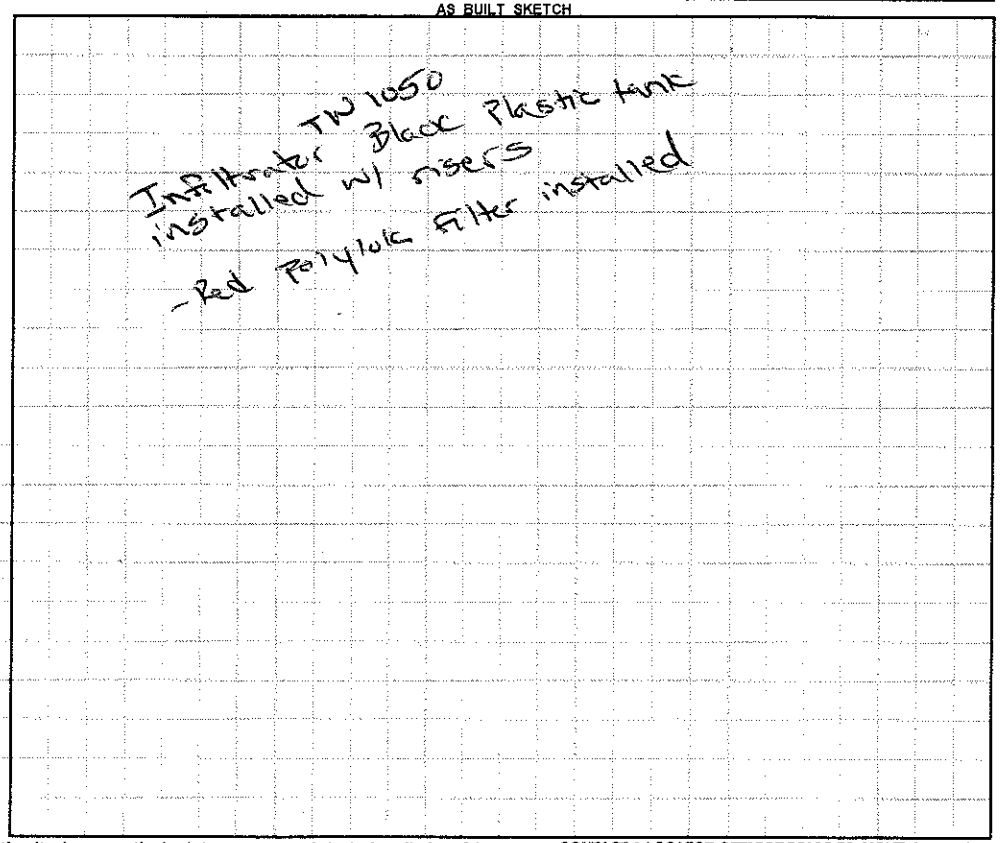

Permit can be suspended or revoked if any false information is supplied toward securing the permit / any unauthorized changes are made to the site / any unauthorized changes are made in the installation of the system. **CONTACT A LOCATOR SERVICE PRIOR TO ANY EXCAVATION**

☐ **IMPROVEMENT PERMIT** *with plat valid without expiration.* ☒ **IMPROVEMENT PERMIT** *with site plan valid for 60 mos.* ☒ **AUTHORIZATION TO CONSTRUCT** *valid for period equal to IMPROVEMENT PERMIT--not to exceed 60 mo.*

Owner / Applicant Signature: Date: 03/13/14 Installed by: Lentz Wastewater

IMPROVEMENT PERMIT by: Date: 03/12/14 OPERATION PERMIT by: Date: 4-4-14

AUTHORIZATION TO CONSTRUCT by: Date: 03/12/14 Existing System Inspected by: Date:

Health Dept. Copy - WHITE Applicant (Final Approval) - YELLOW Applicant (Conditional Approval) - PINK