Site Address: 128 Sunset View Ln. Stat.

IREDELL COUNTY HEALTH DEPARTMENT

STATESVILLE 704-878-5305 | MOORESVILLE 704-664-5281

IMPROVEMENT PERMIT / AUTHORIZATION TO CONSTRUCT / OPERATION PERMIT / EXISTING SYSTEM INSPECTION

DATE 9-27-04

PERMIT# 122141 PIN# 4710-57-7652 52 4710577652 ✓

OWNER OR CONTRACTOR ~~Noble Mills~~ Ronald Lyerly PHONE: Business ~~(704) 528-5013~~ Home 27103

ADDRESS ~~132 Sunset View Lane Statesville NC 28677~~ 437 Hollinswood Ave, Winston-Salem

LOCATION Buffalo Shoals Rd, (L) Pinerville Rd, (R) Spring Shore (R) Sunset View Lane 2nd House on right

SUBDIVISION Spring Shore All BLOCK / SECTION — LOT 141 LOT AREA .69 Ac. SITE CLASS. P5 DESIGN FLOW 240 L.T.A.R. .25 gpd/ft2

Septic Tank: 4,000 Gallons; STB 312 Date 3-20-07

Pump Tank: 4000 Gallons; PT 293 Date 3-23-07

Pump Make: Zoeller Model PE 511 Serial No. 170

Nitrification Field: No Fields 1 Square Feet 960 Linear Feet —

No Lines — Trench Width 2ft Max Trench Bottom Depth —

☒ New System ☐ Repair System Type: I, II, III, IV, V, VI

System Description: Pump, LPP

Repair System Description: Pump, 1945

Maintenance Agreement Required: ☒ Yes ☐ No

☒ House/Mod. Home ☐ Mobile Home ☐ Business ☐ Other

No. Bedrooms 2 No. Bathrooms — No. Employees —

Water Supply: ☒ Individual ☐ Public ☐ Community well

☐ Slab ☐ Crawl Space ☐ Basement w/plumbing ☒ Basement wo/plumbing

Gravel Depth 6"


Comments/Conditions: (1) Install 39 Panels with Gate Control Valve on each line. (2) ST + PT must be 100ft from well; septic lines must be a minimum of 50ft from wells. (3) Install subsurface drainage as shown 40" deep to daylight (4) A maintenance Contract

Comments/Conditions: must be signed before O.P. issues. (5) Attachments "A" + "B" are part of this permit

(6) Approved 54' WIDE X 47' DEEP HOUSE. SEE Attached PLANS

1" = 40 Ft


INITIAL SITE SKETCH

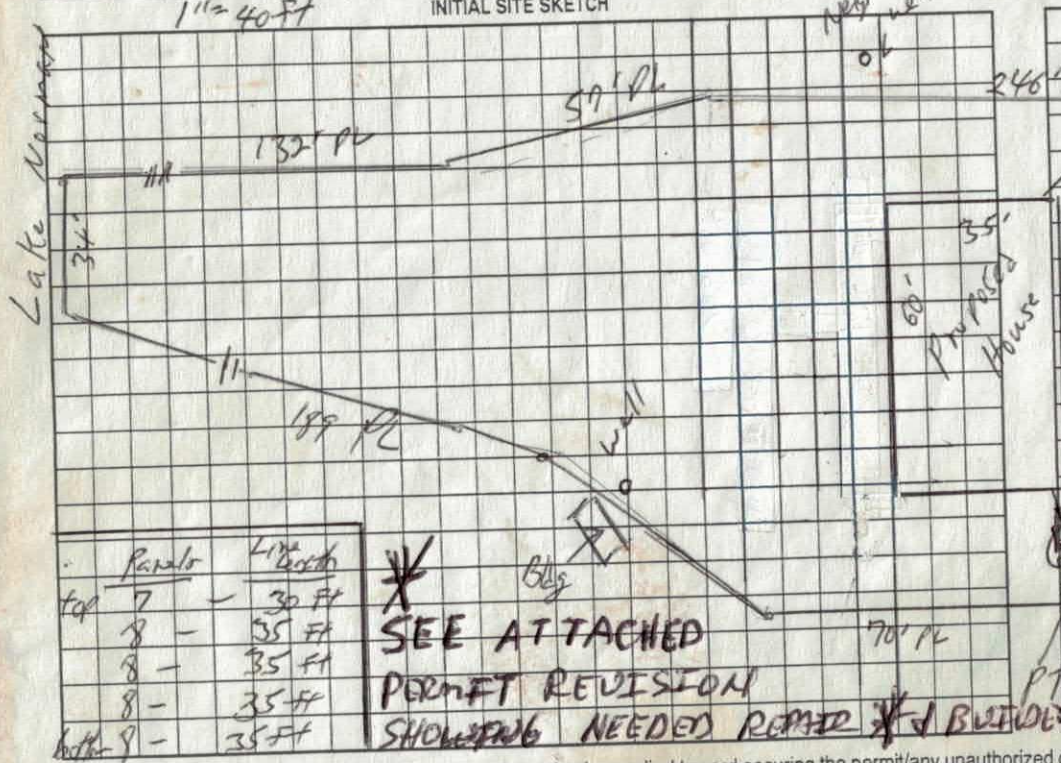

	Panels	Line Length
top	7	30 Ft
	8	35 Ft
	8	35 Ft
	8	35 Ft
bottom	8	35 Ft

* SEE ATTACHED PERMIT REVISION SHOWING NEEDED REPAIR

AS BUILT SKETCH

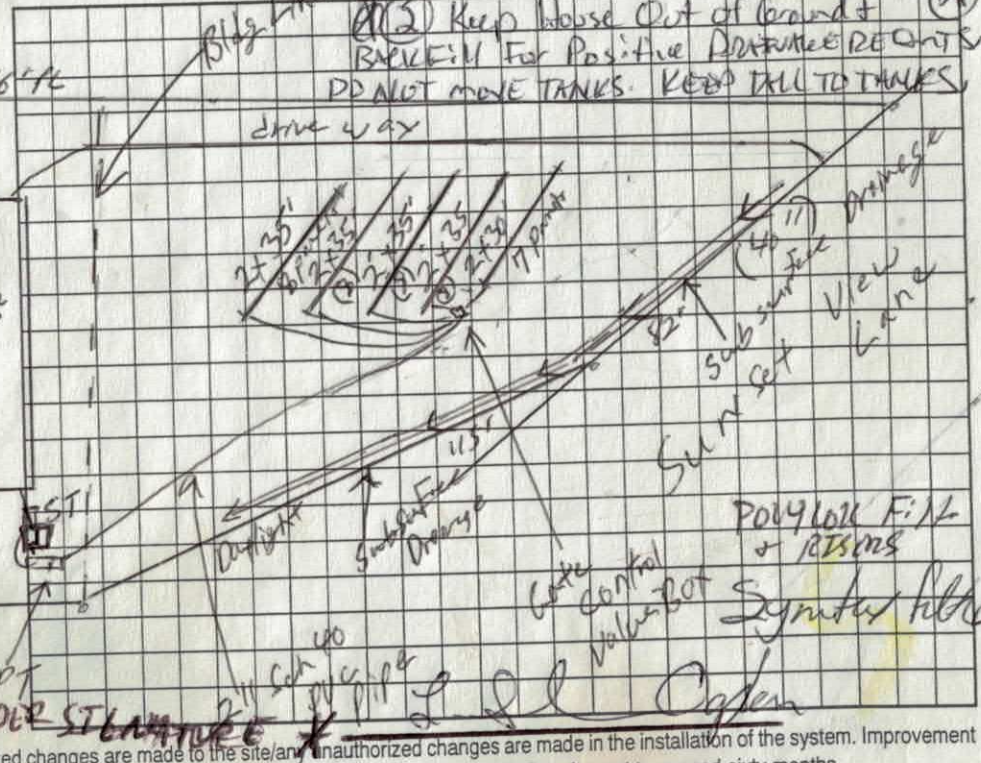

Permit can be suspended or revoked if any false information is supplied toward securing the permit/any unauthorized changes are made to the site/any unauthorized changes are made in the installation of the system. Improvement Permit with plat valid without expiration. Improvement Permit with site plan valid for sixty months. Authorization to Construct is valid for a period equal to that of Improvement Permit – not to exceed sixty months.

Signed: Noble B. Mills Jr date —

Improvement Permit by: William O. Johnson date 9/27/04

Authorization to Construct by: [signature] date 11/2/06

Installed by: Richard Abernathy

Operation Permit by: [signature] date 7-7-07

Existing System Inspection by: — date —

HEALTH DEPT. COPY: WHITE OWNER COPY (FINAL): YELLOW OWNER COPY (INITIAL): PINK

DEPARTMENT OF ENVIRONMENT AND NATURAL RESOURCES
DIVISION OF ENVIRONMENTAL HEALTH
ON-SITE WASTEWATER SECTION

Sheet 1 of 2
PROPERTY ID #:
COUNTY:

SOIL/SITE EVALUATION
for ON-SITE WASTEWATER SYSTEM

OWNER: Noble Mills APPLICATION DATE: DATE EVALUATED:
ADDRESS: PROPERTY SIZE:
PROPOSED FACILITY: PROPOSED DESIGN FLOW (.1949): PROPERTY RECORDED:
LOCATION OF SITE:
WATER SUPPLY: ☐ Private ☐ Public ☐ Well ☐ Spring ☐ Other
EVALUATION METHOD: ☐ Auger Boring ☐ Pit ☐ Cut #141 Spring Shore
TYPE OF WASTEWATER: ☐ Sewage ☐ Industrial Process ☐ Mixed

PROFILE #	.1940 LANDSCAPE POSITION/ SLOPE %	HORIZON DEPTH (IN.)	SOIL MORPHOLOGY (.1941) STRUCTURE/ TEXTURE	SOIL MORPHOLOGY (.1941) CONSISTENCE/ MINERALOGY	OTHER PROFILE FACTORS .1942 SOIL WETNESS/ COLOR	.1943 SOIL DEPTH	.1956 SAPRO CLASS	.1944 RESTR HORIZ	PROFILE CLASS & LTAR
1	Level	0-9	cl sbk	fr SS SP SE+P	18" BLK drainage mottles				PS .25
		9-27	c Abk	fi S P SE+P					
		27-48	c 4/sp sbk	fr SS SP SE+P	45" Chroma 3	FD			
2	Level	0-13	cl	fr SS SP SE+P	Other				PS .25
		13-27	c Abk	fi SP SE+P	12" BLK mottles				
		27-43	c 4/sp	SE+P					
		43-49	sc 4/sp sbk	SE+P	44" Chroma 3	FD			
3		0-9	cl	fr SS SP SE+P	11" BLK mottles				PS .25
		9-40	c Abk	fi SP SE+P					
		40-49	sc 4/sp sbk		43" Other Orange mottles				
4									

DESCRIPTION	INITIAL SYSTEM	REPAIR SYSTEM
Available Space (.1945)	PS	
System Type(s)	Pump LPP	
Site LTAR	.25	

OTHER FACTORS (.1946):
SITE CLASSIFICATION (.1948):
EVALUATED BY: Bill Johnson
OTHER(S) PRESENT:

COMMENTS:

LEGEND

use the following standard abbreviations

LANDSCAPE POSITION	GROUP	SOIL TEXTURE	CONVENTIONAL .1955 LTAR*	LPP .1957 LTAR*
CC (Concave Slope) CV (Convex Slope) D (Drainage Way) DS (Debris Slump) FP (Flood Plain) FS (Foot Slope) H (Head Slope) L (Linear Slope) N (Nose Slope) R (Ridge) S (Shoulder Slope) T (Terrace)	I	S (Sand) LS (Loamy Sand)	1.2 - 0.8	0.6 - 0.4
	II	SL (Sandy Loam) L (Loam)	0.8 - 0.6	0.4 - 0.3
	III	SCL (Sandy Clay Loam) SiL (Silt Loam) CL (Clay Loam) SiCL (Silty Clay Loam) Si (Silt)	0.6 - 0.3	0.3 - 0.15
	IV	SC (Sandy Clay) SiC (Silty Clay) C (Clay)	0.4 - 0.1	0.2 - 0.05
		O (Organic)	None	

MINERALOGY/ CONSISTENCE	STRUCTURE
NEXP (Non-expansive)	G (Single Grain)
SEXP (Slightly Expansive)	M (Massive)
EXP (Expansive)	CR (Crumb)
	GR (Granular)
	SBK (Subangular Blocky)
	ABK (Angular Blocky)
	PL (Platy)
	PR (Prismatic)

MOIST	WET
VFR (Very Friable)	NS (Non-sticky)
FR (Friable)	SS (Slightly Sticky)
FI (Firm)	S (Sticky)
VFI (Very Firm v. Very Sticky)	VS (Very Sticky)
EFI (Extremely Firm)	NP (Non-plastic)
	SP (Slightly Plastic)
	P (Plastic)
	VP (Very Plastic)

***Adjust LTAR due to depth, consistence, structure, soil wetness, landscape, position, wastewater flow and quality.**

NOTES

HORIZON DEPTH — In inches below natural soil surface

DEPTH OF FILL — In inches from land surface

RESTRICTIVE HORIZON — Thickness and depth from land surface

SAPROLITE — S(suitable) or U(unsuitable)


SOIL WETNESS — Inches from land surface to free water or inches from land surface to soil colors with chroma 2 or less - record Munsell color chip designation

CLASSIFICATION — S (Suitable), PS (Provisionally Suitable), or U (Unsuitable)

Evaluation of saprolite shall be by pits.

Long-term Acceptance Rate (LTAR): gal/day/ft^2

Show profile locations and other site features (dimensions, reference or benchmark, and North).

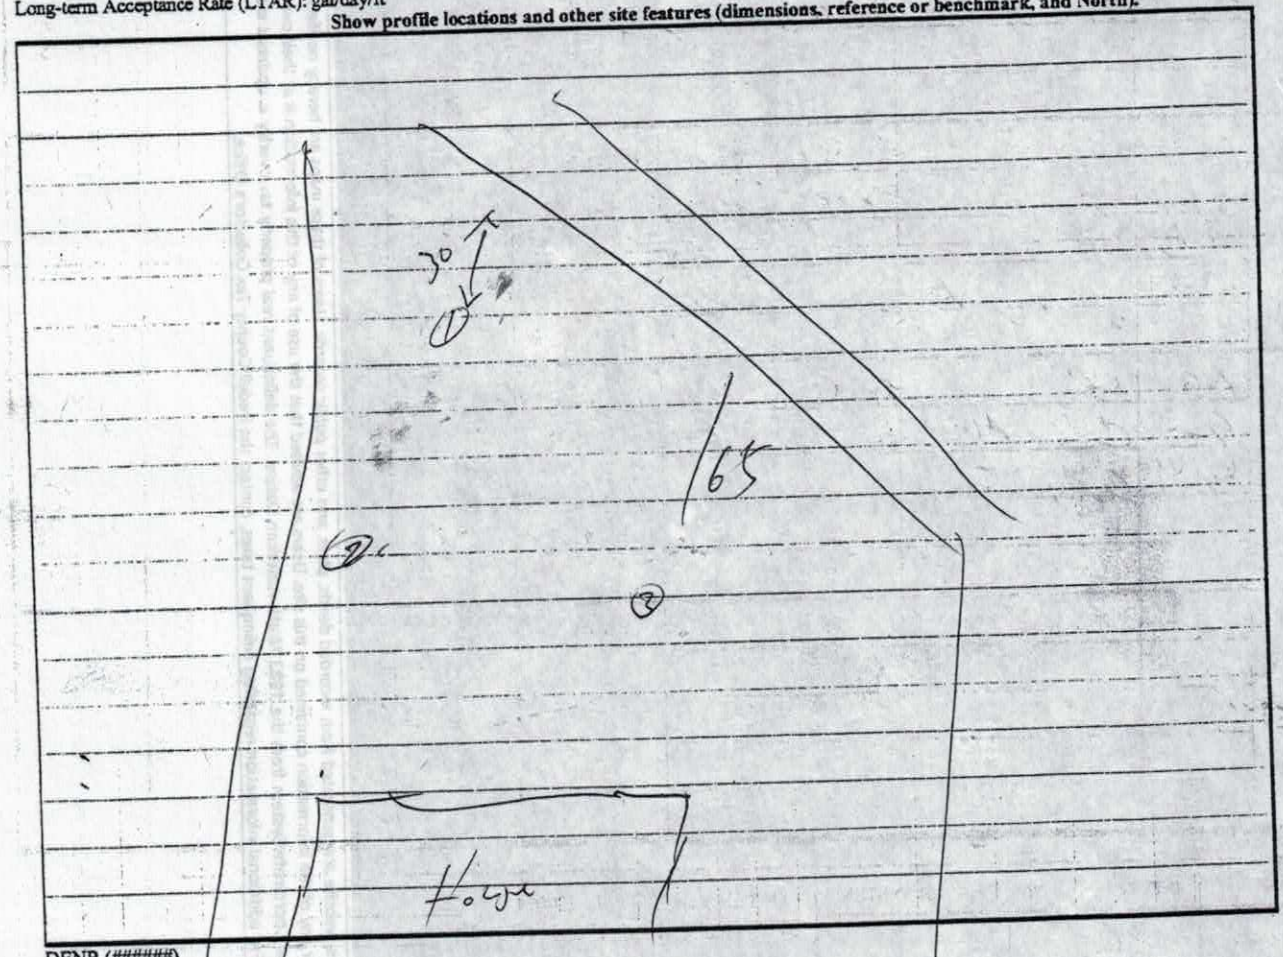

DENR (######)
Review (#####)

DEPARTMENT OF ENVIRONMENT AND NATURAL RESOURCES
DIVISION OF ENVIRONMENTAL HEALTH
ON-SITE WASTEWATER SECTION

PROPERTY ID #: _____
COUNTY: _____

SOIL/SITE EVALUATION
for ON-SITE WASTEWATER SYSTEM

OWNER: Noel Mills APPLICATION DATE _____ DATE EVALUATED: _____
ADDRESS: _____
PROPOSED FACILITY: _____ PROPOSED DESIGN FLOW (.1949): _____ PROPERTY SIZE: _____
LOCATION OF SITE: _____ PROPERTY RECORDED: _____
WATER SUPPLY: ❑ Private ❑ Public ❑ Well ❑ Spring ❑ Other _____
EVALUATION METHOD: ❑ Auger Boring ❑ Pit ❑ Cut Sparling Shore #141
TYPE OF WASTEWATER: ❑ Sewage ❑ Industrial Process ❑ Mixed

PROFILE #	.1940 LANDSCAPE POSITION/ SLOPE %	HORIZON DEPTH (IN.)	SOIL MORPHOLOGY (.1941) .1941 STRUCTURE/ TEXTURE	.1941 CONSISTENCE/ MINERALOGY	OTHER PROFILE FACTORS .1942 SOIL WETNESS/ COLOR	.1943 SOIL DEPTH	.1956 SAPRO CLASS	.1944 RESTR HORIZ	PROFILE CLASS & LTAR
1	LinCar	6 to 10	Sc sbk	fr SS SP					
		10 to 15	C Abk	fi SP SBT					
		15-19	C/Sap	SS SP SBT					PS
		19-48	Sap				Saprolite		
2	LinCar	6 to 10	Sc sbk	fr SS SBT			Soil		
		10-24	Sc sbk	Fr SP SBT					PS
		24-48	Sap bdrk						
3									
4									

DESCRIPTION	INITIAL SYSTEM	REPAIR SYSTEM
Available Space (.1945)		
System Type(s)		
Site LTAR		

OTHER FACTORS (.1946): _____
SITE CLASSIFICATION (.1948): _____
EVALUATED BY: _____
OTHER(S) PRESENT: _____

COMMENTS: _____

LEGEND

use the following standard abbreviations

LANDSCAPE POSITION	GROUP	SOIL TEXTURE	CONVENTIONAL .1955 LTAR*	LPP .1957 LTAR*
CC (Concave Slope) CV (Convex Slope) D (Drainage Way) DS (Debris Slump) FP (Flood Plain) FS (Foot Slope) H (Head Slope) L (Linear Slope) N (Nose Slope) R (Ridge) S (Shoulder Slope) T (Terrace)	I	S (Sand) LS (Loamy Sand)	1.2 - 0.8	0.6 - 0.4
	II	SL (Sandy Loam) L (Loam)	0.8 - 0.6	0.4 - 0.3
	III	SCL (Sandy Clay Loam) SiL (Silt Loam) CL (Clay Loam) SiCL (Silty Clay Loam) Si (Silt)	0.6 - 0.3	0.3 - 0.15
	IV	SC (Sandy Clay) SiC (Silty Clay) C (Clay) O (Organic)	0.4 - 0.1 None	0.2 - 0.05

MINERALOGY/ CONSISTENCE

NEXP (Non-expansive)
SEXP (Slightly Expansive)
EXP (Expansive)

STRUCTURE

G (Single Grain)
M (Massive)
CR (Crumb)
GR (Granular)
SBK (Subangular Blocky)
ABK (Angular Blocky)
PL (Platy)
PR (Prismatic)

MOIST

VFR (Very Friable)
FR (Friable)
FI (Firm)
VFI (Very Firm v. Very Sticky)
EFI (Extremely Firm)

WET

NS (Non-sticky)
SS (Slightly Sticky)
S (Sticky)
VS (Very Sticky)
NP (Non-plastic)
SP (Slightly Plastic)
P (Plastic)
VP (Very Plastic)

***Adjust LTAR due to depth, consistence, structure, soil wetness, landscape, position, wastewater flow and quality.**


NOTES

HORIZON DEPTH	In inches below natural soil surface
DEPTH OF FILL	In inches from land surface
RESTRICTIVE HORIZON	Thickness and depth from land surface
SAPROLITE	S(suitable) or U(unsuitable)
SOIL WETNESS	Inches from land surface to free water or inches from land surface to soil colors with chroma 2 or less - record Munsell color chip designation
CLASSIFICATION	S (Suitable), PS (Provisionally Suitable), or U (Unsuitable)

Evaluation of saprolite shall be by pits.

Long-term Acceptance Rate (LTAR): gal/day/ft^2

Show profile locations and other site features (dimensions, reference or benchmark, and North).

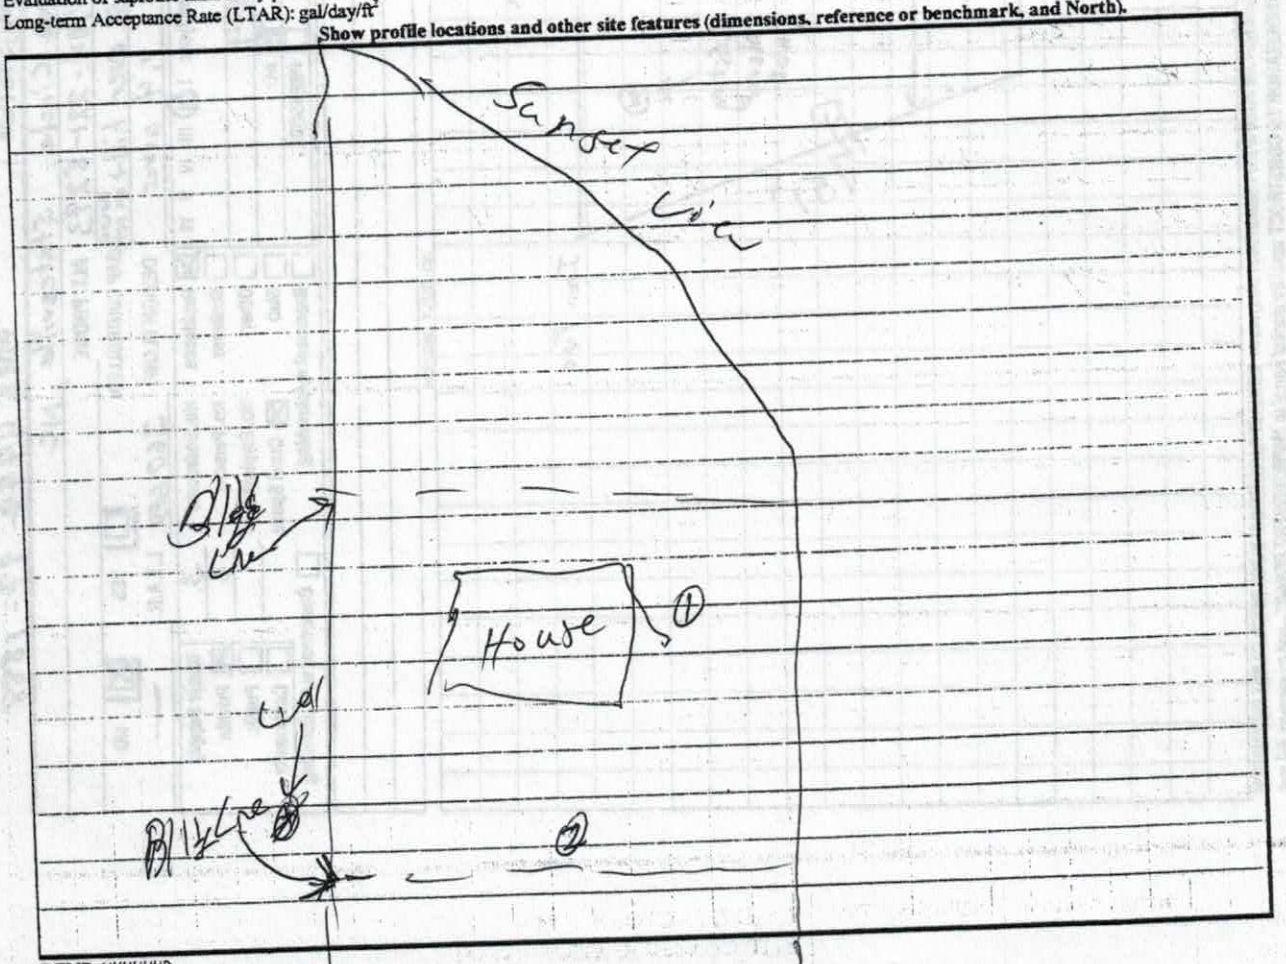

DENR (######)
Review (#####)

DEPARTMENT OF ENVIRONMENT AND NATURAL RESOURCES
DIVISION OF ENVIRONMENTAL HEALTH
ON-SITE WASTEWATER SECTION

Sheet ___ of ___
PROPERTY ID #: 122141
COUNTY: 4710-57-7657

SOIL/SITE EVALUATION
for ON-SITE WASTEWATER SYSTEM

OWNER: RONALD LEARY
ADDRESS:
PROPOSED FACILITY: SpringStone 141
LOCATION OF SITE:
APPLICATION DATE
DATE EVALUATED:
PROPOSED DESIGN FLOW (.1949): 240
PROPERTY SIZE: 1.6 AC
PROPERTY RECORDED: YES

WATER SUPPLY: ☐ Private ☐ Public ☐ Well ☐ Spring ☐ Other
EVALUATION METHOD: ☒ Auger Boring ☐ Pit ☐ Cut
TYPE OF WASTEWATER: ☒ Sewage ☐ Industrial Process ☐ Mixed

PROFILE #	.1940 LANDSCAPE POSITION/ SLOPE %	HORIZON DEPTH (IN.)	SOIL MORPHOLOGY (.1941) .1941 STRUCTURE/ TEXTURE	.1941 CONSISTENCE/ MINERALOGY	OTHER PROFILE FACTORS .1942 SOIL WETNESS/ COLOR	.1943 SOIL DEPTH	.1956 SAPRO CLASS	.1944 RESTR HORIZ	PROFILE CLASS & LTAR
1	25% L	0-18"	scl wk gr	fr nsp nsp		48"			PS .3
		18-36"	cmed sbk	fr ss sp sp					
		36-48"	cmed sbk	fr ss sp sp					
			sap inclusions <50%						
2	25% L	0-18"	scl wk gr	fr nsp nsp		48"			PS .3
		18-36"	cmed sbk	fr ss sp sp					
		36-48"	cmed sbk	fr ss sp sp					
			sap inclusions <50%						
3									
4									

DESCRIPTION	INITIAL SYSTEM	REPAIR SYSTEM
Available Space (.1945)		YES
System Type(s)		LPP 50%
Site LTAR	.3	.3

OTHER FACTORS (.1946):
SITE CLASSIFICATION (.1948): PS
EVALUATED BY: L. COOK
OTHER(S) PRESENT: K. COOK

COMMENTS: EVALUATION FOR REPAIR

LEGEND

use the following standard abbreviations

LANDSCAPE POSITION	GROUP	SOIL TEXTURE	CONVENTIONAL .1955 LTAR*	LPP .1957 LTAR*
CC (Concave Slope) CV (Convex Slope) D (Drainage Way) DS (Debris Slump) FP (Flood Plain) FS (Foot Slope) H (Head Slope) L (Linear Slope) N (Nose Slope) R (Ridge) S (Shoulder Slope) T (Terrace)	I	S (Sand) LS (Loamy Sand)	1.2 - 0.8	0.6 - 0.4
	II	SL (Sandy Loam) L (Loam)	0.8 - 0.6	0.4 - 0.3
	III	Si (Silt) SiCL (Silty Clay Loam) CL (Clay Loam) SCL (Sandy Clay Loam) SiL (Silt Loam)	0.6 - 0.3	0.3 - 0.15
	IV	SC (Sandy Clay) SiC (Silty Clay) C (Clay)	0.4 - 0.1	0.2 - 0.05
		O (Organic)	None	None

MINERALOGY/ CONSISTENCE
NEXP (Non-expansive)
SEXP (Slightly Expansive)
EXP (Expansive)

STRUCTURE
G (Single Grain)
M (Massive)
CR (Crumb)
GR (Granular)
SBK (Subangular Blocky)
ABK (Angular Blocky)
PL (Platy)
PR (Prismatic)

MOIST
VFR (Very Friable)
FR (Friable)
FI (Firm)
VFI (Very Firm v. Very Sticky)
EFI (Extremely Firm)

WET
NS (Non-sticky)
SS (Slightly Sticky)
S (Sticky)
VS (Very Sticky)
NP (Non-plastic)
SP (Slightly Plastic)
P (Plastic)
VP (Very Plastic)

*Adjust LTAR due to depth, consistence, structure, soil wetness, landscape, position, wastewater flow and quality.


NOTES

HORIZON DEPTH — In inches below natural soil surface
DEPTH OF FILL — In inches from land surface
RESTRICTIVE HORIZON — Thickness and depth from land surface
SAPROLITE — S(suitable) or U(unsuitable)
SOIL WETNESS — Inches from land surface to free water or inches from land surface to soil colors with chroma 2 or less - record Munsell color chip designation
CLASSIFICATION — S (Suitable), PS (Provisionally Suitable), or U (Unsuitable)

Evaluation of saprolite shall be by pits.


Long-term Acceptance Rate (LTAR): gal/day/ft^2

Show profile locations and other site features (dimensions, reference or benchmark, and North).

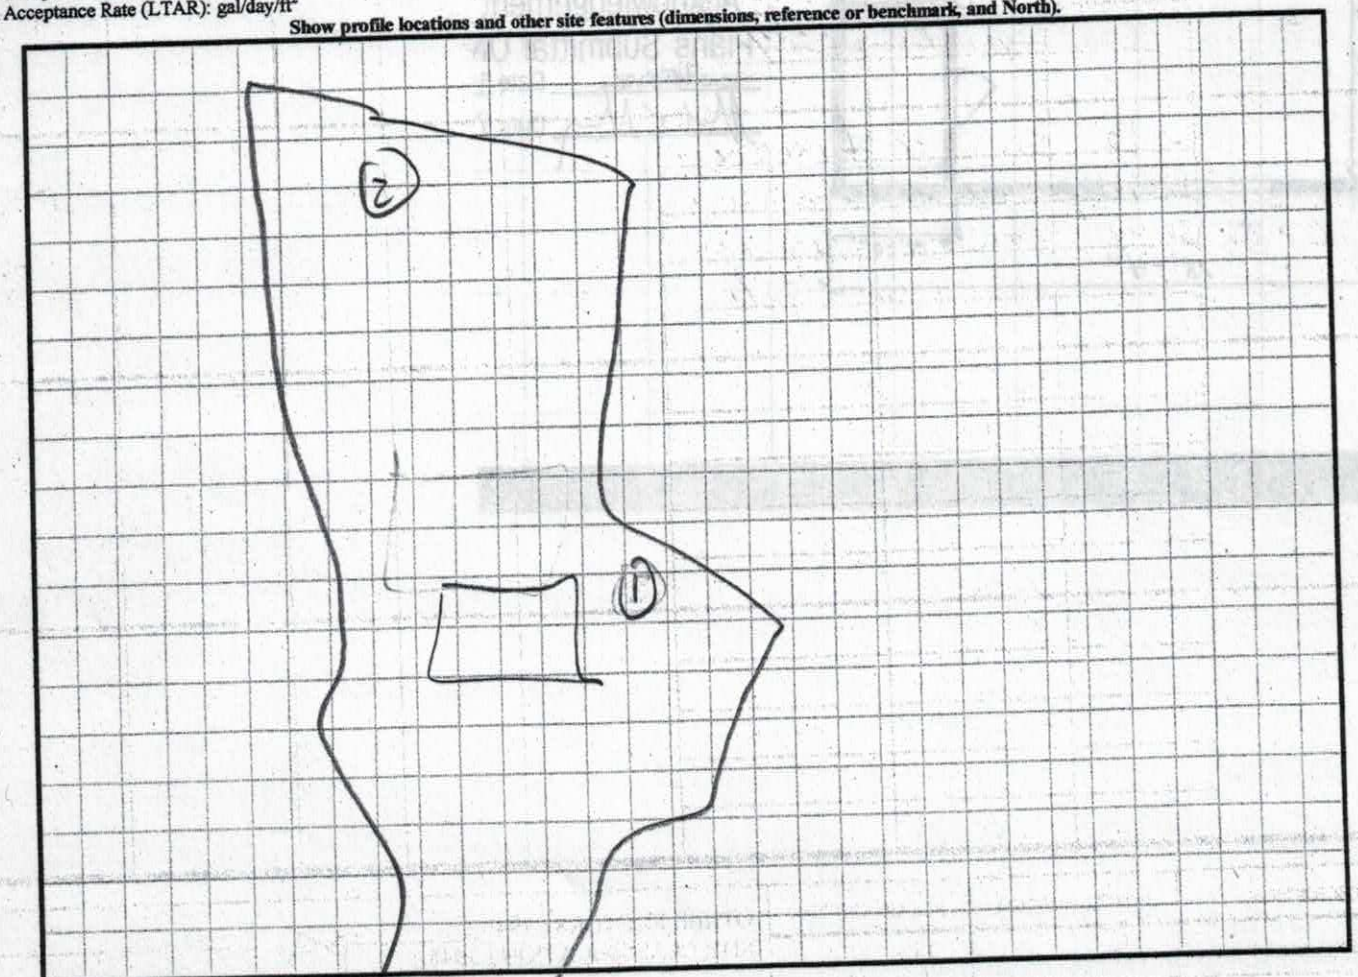

DENR (######)
Review (#####)

Noble Mills Permit # 122141 Attachment "A"

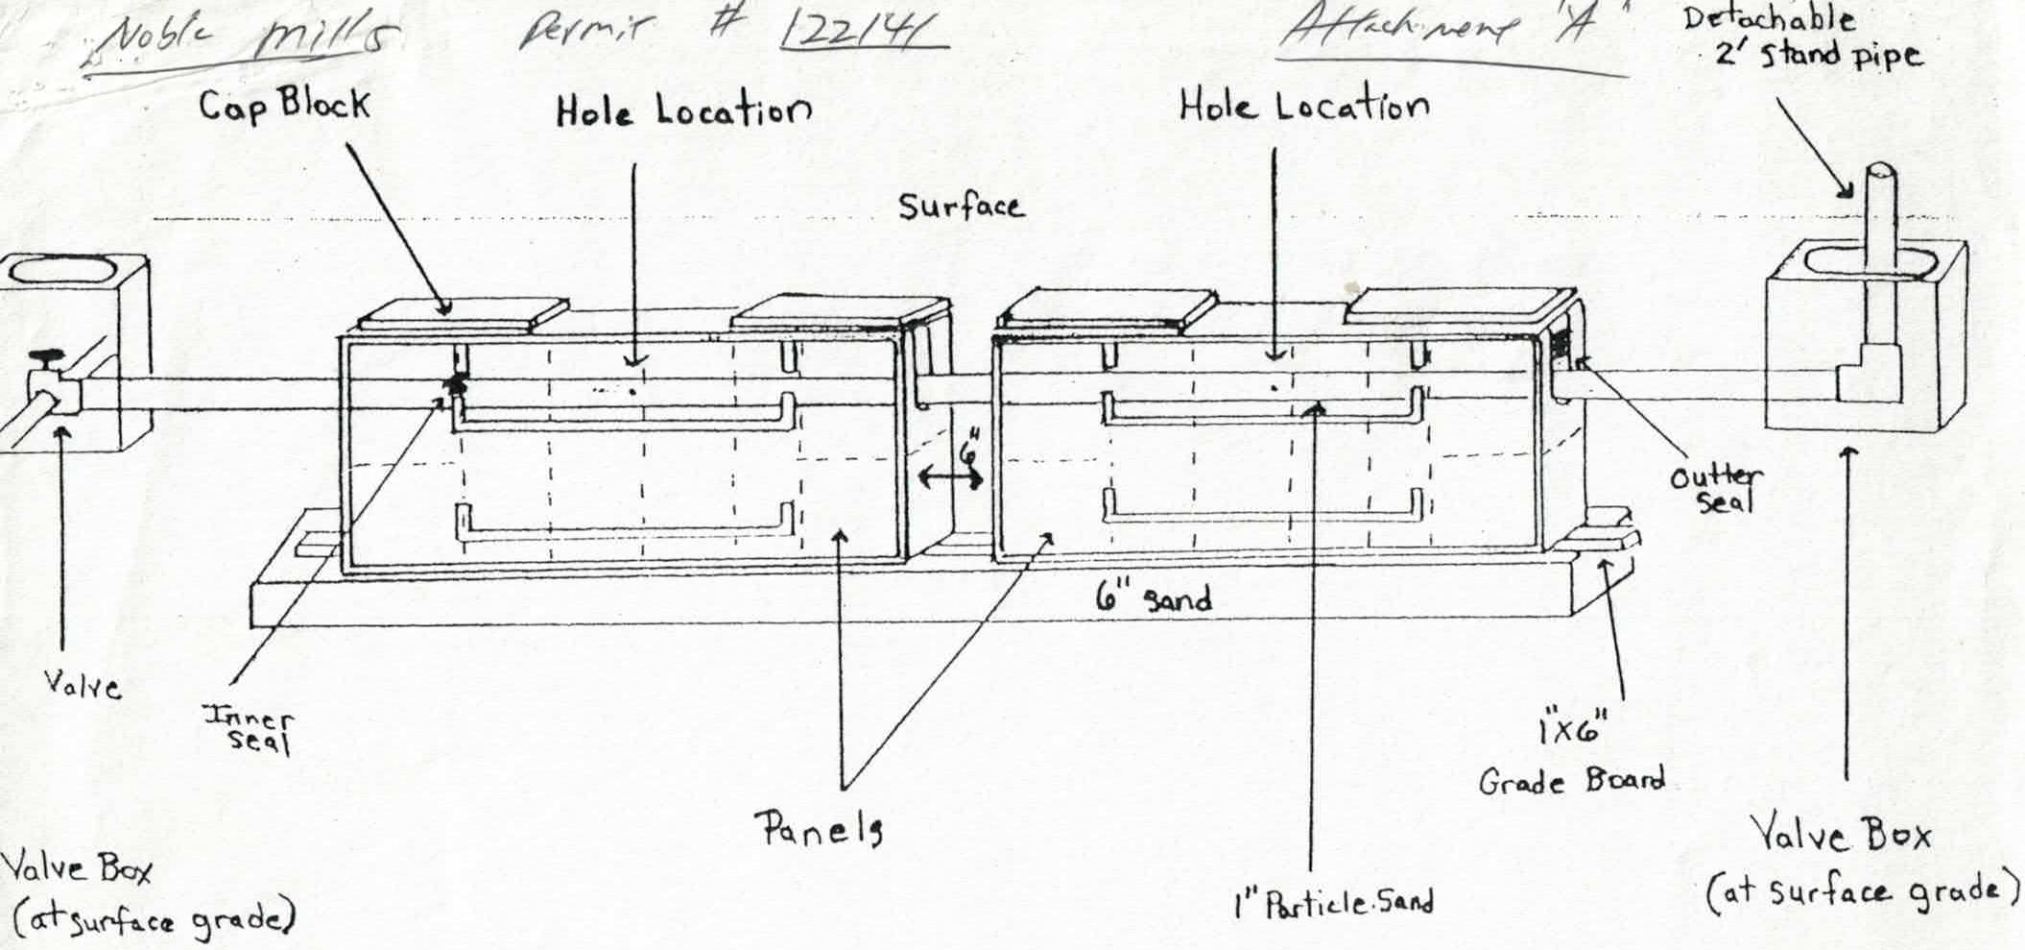

Pressure Dosed PPBPS

# of panels 39.
Size holes 3/16. 1 hole per panel.
Approximate amount of sand needed 28.
100 lbs. of partical sand per 8 panels.
Sidewalls raked and limed.
GPM 20.
TDH _____.

Comments

Set floats for 140 gallons dose.

5

IREDELL COUNTY HEALTH DEPARTMENT

Application For Improvement Permit and/or Authorization To Construct, Existing System Inspection

(THE ABOVE PERMIT DOCUMENTS WILL BECOME INVALID IF INFORMATION PROVIDED ON THIS APPLICATION IS FALSIFIED OR CHANGED, OR IF THE SITE IS ALTERED. THE IMPROVEMENT PERMIT IS VALID FOR EITHER 60 MONTHS OR WITHOUT EXPIRATION DEPENDING UPON DOCUMENTATION SUBMITTED - APPLICATION WITH SITE PLAN 60 MONTHS, APPLICATION WITH COMPLETE, SCALED PLAT WITHOUT EXPIRATION. SEE 15A NCAC 18A .1937(f) FOR DETAILS)

1. APPLICATION FOR: ___ Improvement Permit ✓ Authorization To Construct ___BOTH ___Existing System Inspection

2. Page 2: *Site Plan Worksheet* Form MUST Accompany This Application
   The following optional attachments may also be submitted: ___ Survey Plat, Scaled no more than 1 Inch = 60 Feet
   Place check ( ) beside whichever is submitted if applicable ___ Custom Site Plan, Scaled no more than 1 Inch = 60 Feet

3. **Applicant Information:**

Applicant Name	Mailing Address	Home Phone	Work Phone
L. Shaun Ogle Const	P-O-Box 1281 Davidson NC. 28036	704-309-6810	

Owner Name	Mailing Address	Home Phone	Work Phone
Ron & Carol Lyerly			

4. **Property Information:**

Street Address	Subdivision Name	Section/Phase and Lot Number
Sunset View	Spring Shore	Lot 141

Driving Directions: Pinevilla Rd turn into Spring Shore subdivision Rt Sunset View Lot on Rt

****

5. **RESIDENTIAL Site Development Information:** *(Check or Complete ALL that apply)*

(✓) New, Single Family Residence
( ) New, Multi-Family Residence
( ) Expansion of Existing Septic System
( ) Repair To Failing Septic System

Maximum Number of Bedrooms 2
Maximum Number of Occupants ___
If Expansion, Current Number of Bedrooms ___

( ) Crawl Space Foundation?
( ) Concrete Slab Foundation?
( ) Basement w/Plumbing?
(✓) Basement w/out Plumbing?

IF Non- Residential Site Development:
Type of Business ___
Square Footage of Building ___
Maximum Number of Employees ___
Maximum Number of Seats ___

****

6. **Proposed Water Supply:**

( ) New Well (✓) Existing Well ( ) Community Well ( ) City Water ( ) Other Public Water

****

7. **Desired Septic System Type:** *(You may rank in order of preference, if any)*

( ) Alternative ( ) Conventional ( ) Innovative (✓) Modified Conventional ( ) Other_____ ( ) No Preference

****

8. **Please Answer The Following To The Best of Your Ability:**


( ) Yes (✓) No Does the site contain any jurisdictional wetlands?
( ) Yes (✓) No Is any non-domestic sewage (i.e. industry) to be generated?
( ) Yes (✓) No Is the site subject to approval by any other public agency?

****


I have read this application and certify that the information provided herein is true, complete, and correct. Authorized county and state officials are granted right of entry to conduct necessary inspections to determine compliance with applicable laws and rules. I understand that I am solely responsible for the proper identification and labeling of all property lines and corners and making the site accessible so that a complete site evaluation can be performed.

9. **Signature:** L. Shaun Ogle — 11-2-06

Property owner or owner's legal representative signature (SIGNATURE REQUIRED) — DATE

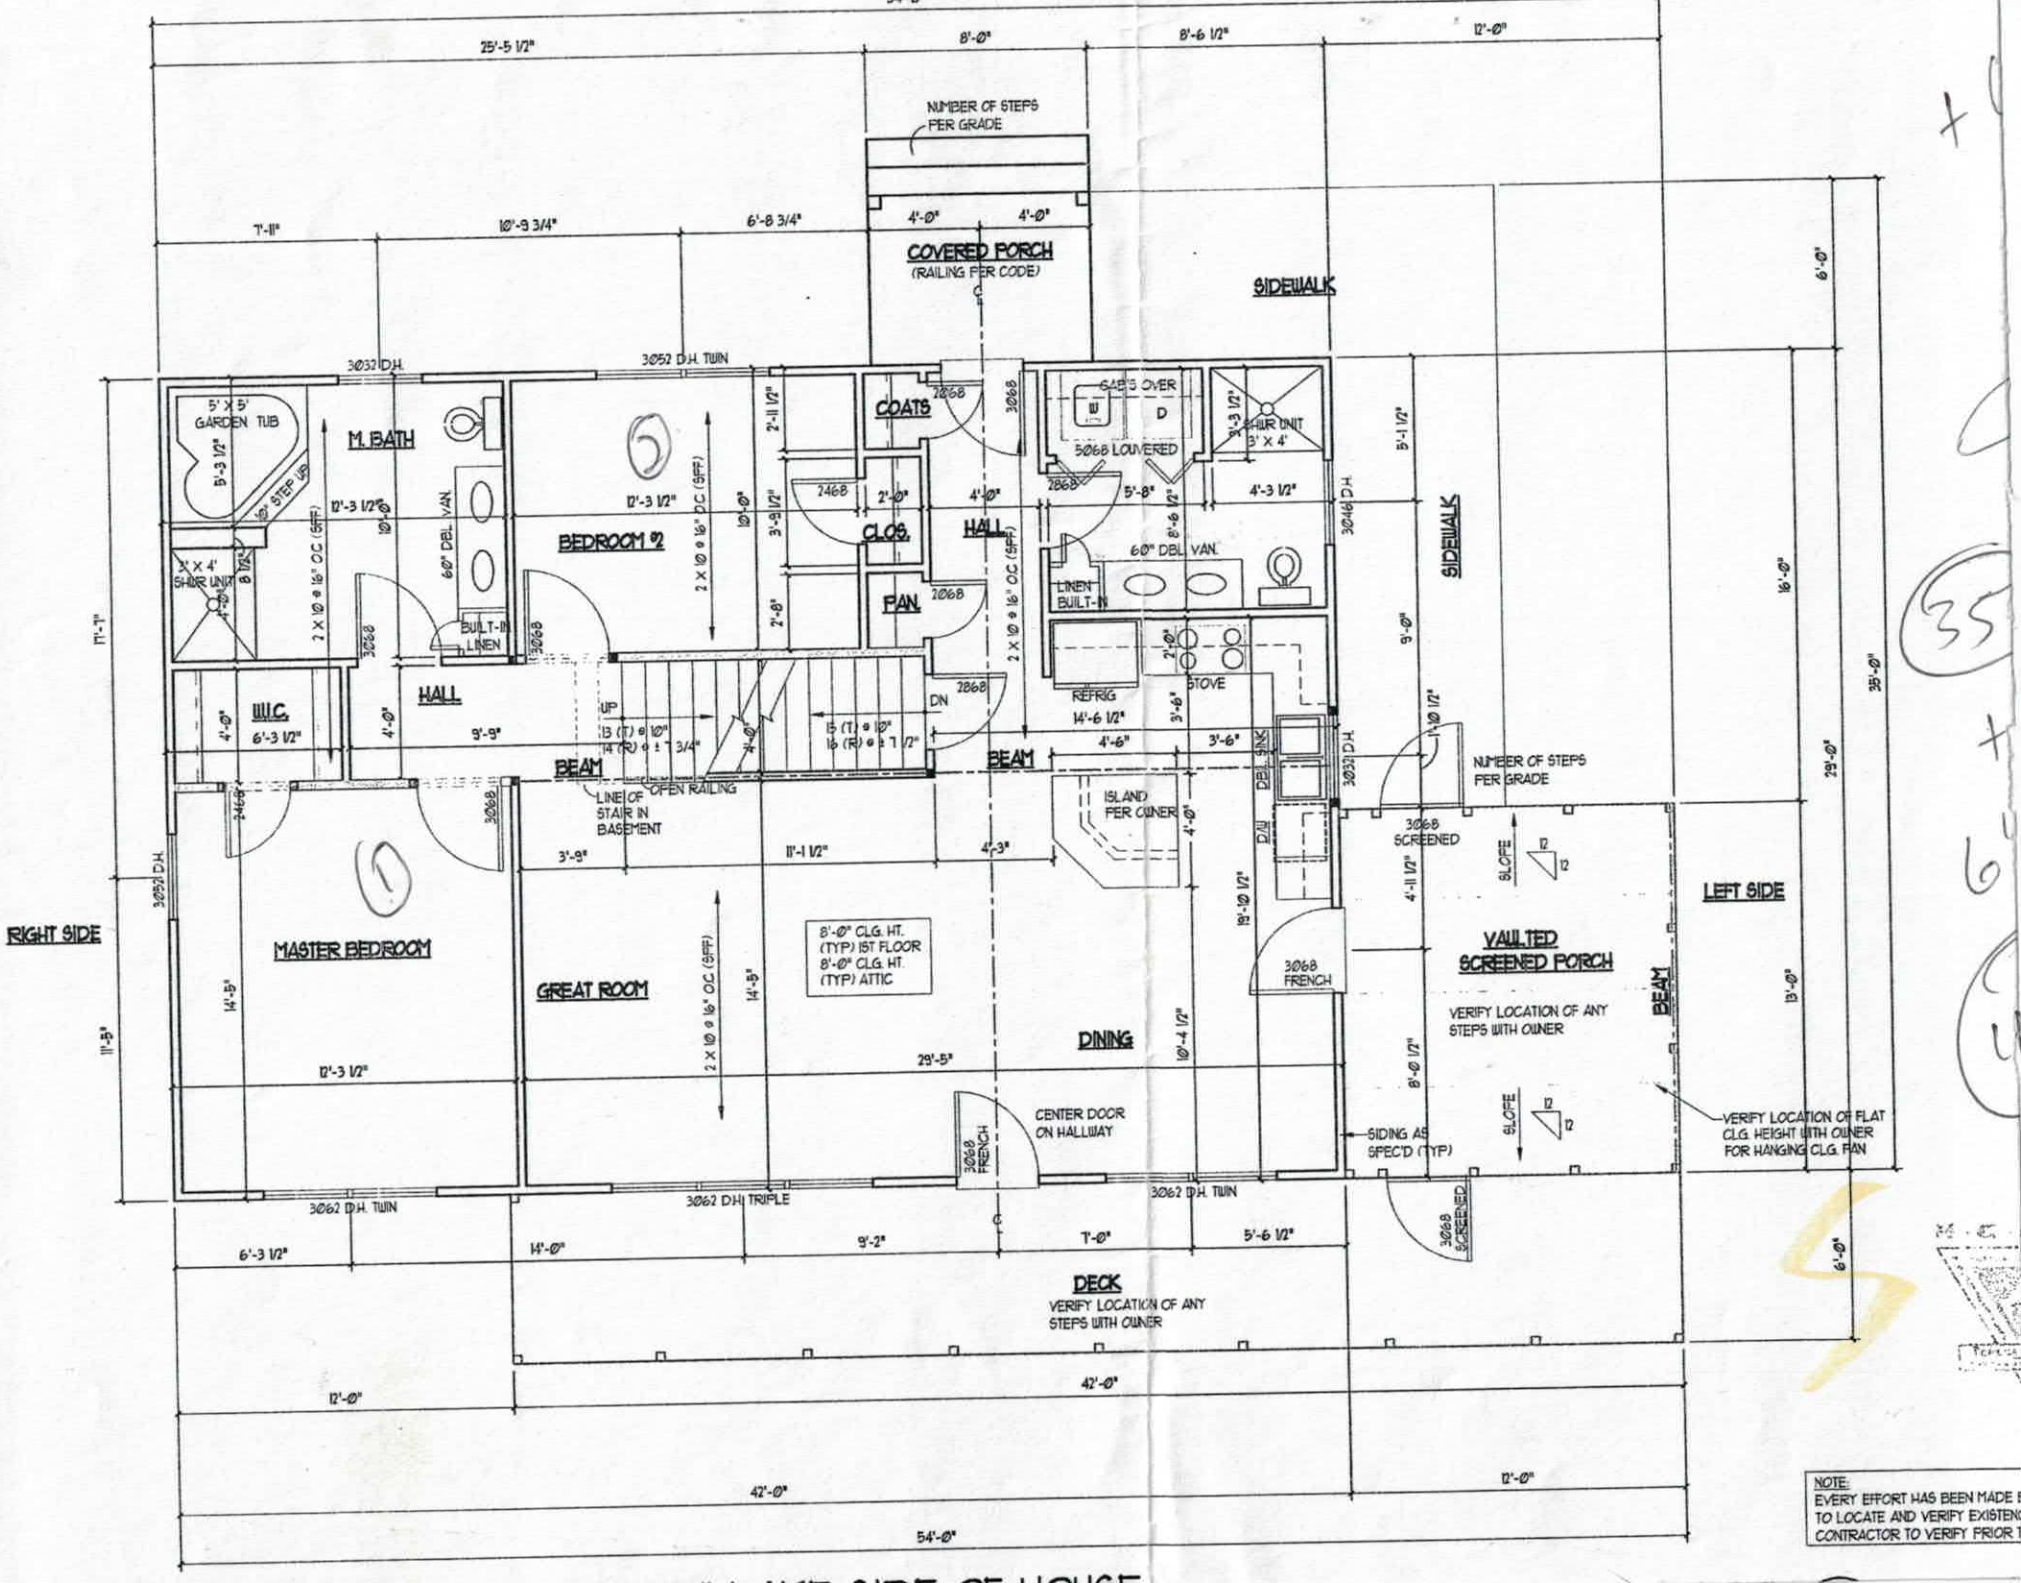

25'-5 1/2"
8'-0"
8'-6 1/2"
12'-0"
NUMBER OF STEPS PER GRADE
7'-11"
10'-9 3/4"
6'-8 3/4"
4'-0"
4'-0"
COVERED PORCH
(RAILING PER CODE)
SIDEWALK
3032 D.H.
3052 D.H. TWIN
5' X 5' GARDEN TUB
M. BATH
5'-3 1/2"
10" STEP UP
12'-3 1/2"
10'-0"
60" DBL. VAN.
2 X 10 @ 16" OC (SPF)
BEDROOM #2
12'-3 1/2"
3'-9 1/2"
2'-11 1/2"
COATS
2868
3068
2468
2'-0"
4'-0"
CLOS.
HALL
FAN
2068
2'-8"
GABLE OVER
W
D
3068 LOUVERED
2868
5'-8"
4'-3 1/2"
5'-1 1/2"
3046 D.H.
8'-6 1/2"
60" DBL. VAN.
LINEN BUILT-IN
SIDEWALK
3' X 4' SHOWER UNIT
8 1/2"
BUILT-IN LINEN
3068
W.I.C.
6'-3 1/2"
4'-0"
HALL
9'-9"
UP
13 (T) @ 10"
14 (R) @ ± 3/4"
15 (T) @ 10"
16 (R) @ ± 7 1/2"
DN
2868
REFRIG
14'-6 1/2"
3'-6"
4'-6"
3'-6"
STOVE
2'-0"
3032 D.H.
1'-10 1/2"
NUMBER OF STEPS PER GRADE
BEAM
LINE OF OPEN RAILING
LINE OF STAIR IN BASEMENT
BEAM
ISLAND PER OWNER
4'-0"
DBL. SINK
D/W
3068 SCREENED
SLOPE
12
12
4'-11 1/2"
LEFT SIDE
RIGHT SIDE
3052 D.H.
MASTER BEDROOM
GREAT ROOM
3'-9"
11'-1 1/2"
4'-3"
8'-0" CLG. HT. (TYP) 1ST FLOOR
8'-0" CLG. HT. (TYP) ATTIC
2 X 10 @ 16" OC (SPF)
14'-5"
19'-10 1/2"
VAULTED SCREENED PORCH
VERIFY LOCATION OF ANY STEPS WITH OWNER
BEAM
3068 FRENCH
DINING
10'-4 1/2"
8'-0 1/2"
29'-5"
12'-3 1/2"
CENTER DOOR ON HALLWAY
SIDING AS SPEC'D (TYP)
VERIFY LOCATION OF FLAT CLG. HEIGHT WITH OWNER FOR HANGING CLG. FAN
3062 D.H. TWIN
3062 D.H. TRIPLE
3062 D.H. TWIN
3068 SCREENED
6'-3 1/2"
14'-0"
9'-2"
1'-0"
5'-6 1/2"
DECK
VERIFY LOCATION OF ANY STEPS WITH OWNER
12'-0"
42'-0"
42'-0"
12'-0"
54'-0"
NOTE:
EVERY EFFORT HAS BEEN MADE
TO LOCATE AND VERIFY EXISTEN
CONTRACTOR TO VERIFY PRIOR

"FRONT" STREET SIDE OF HOUSE

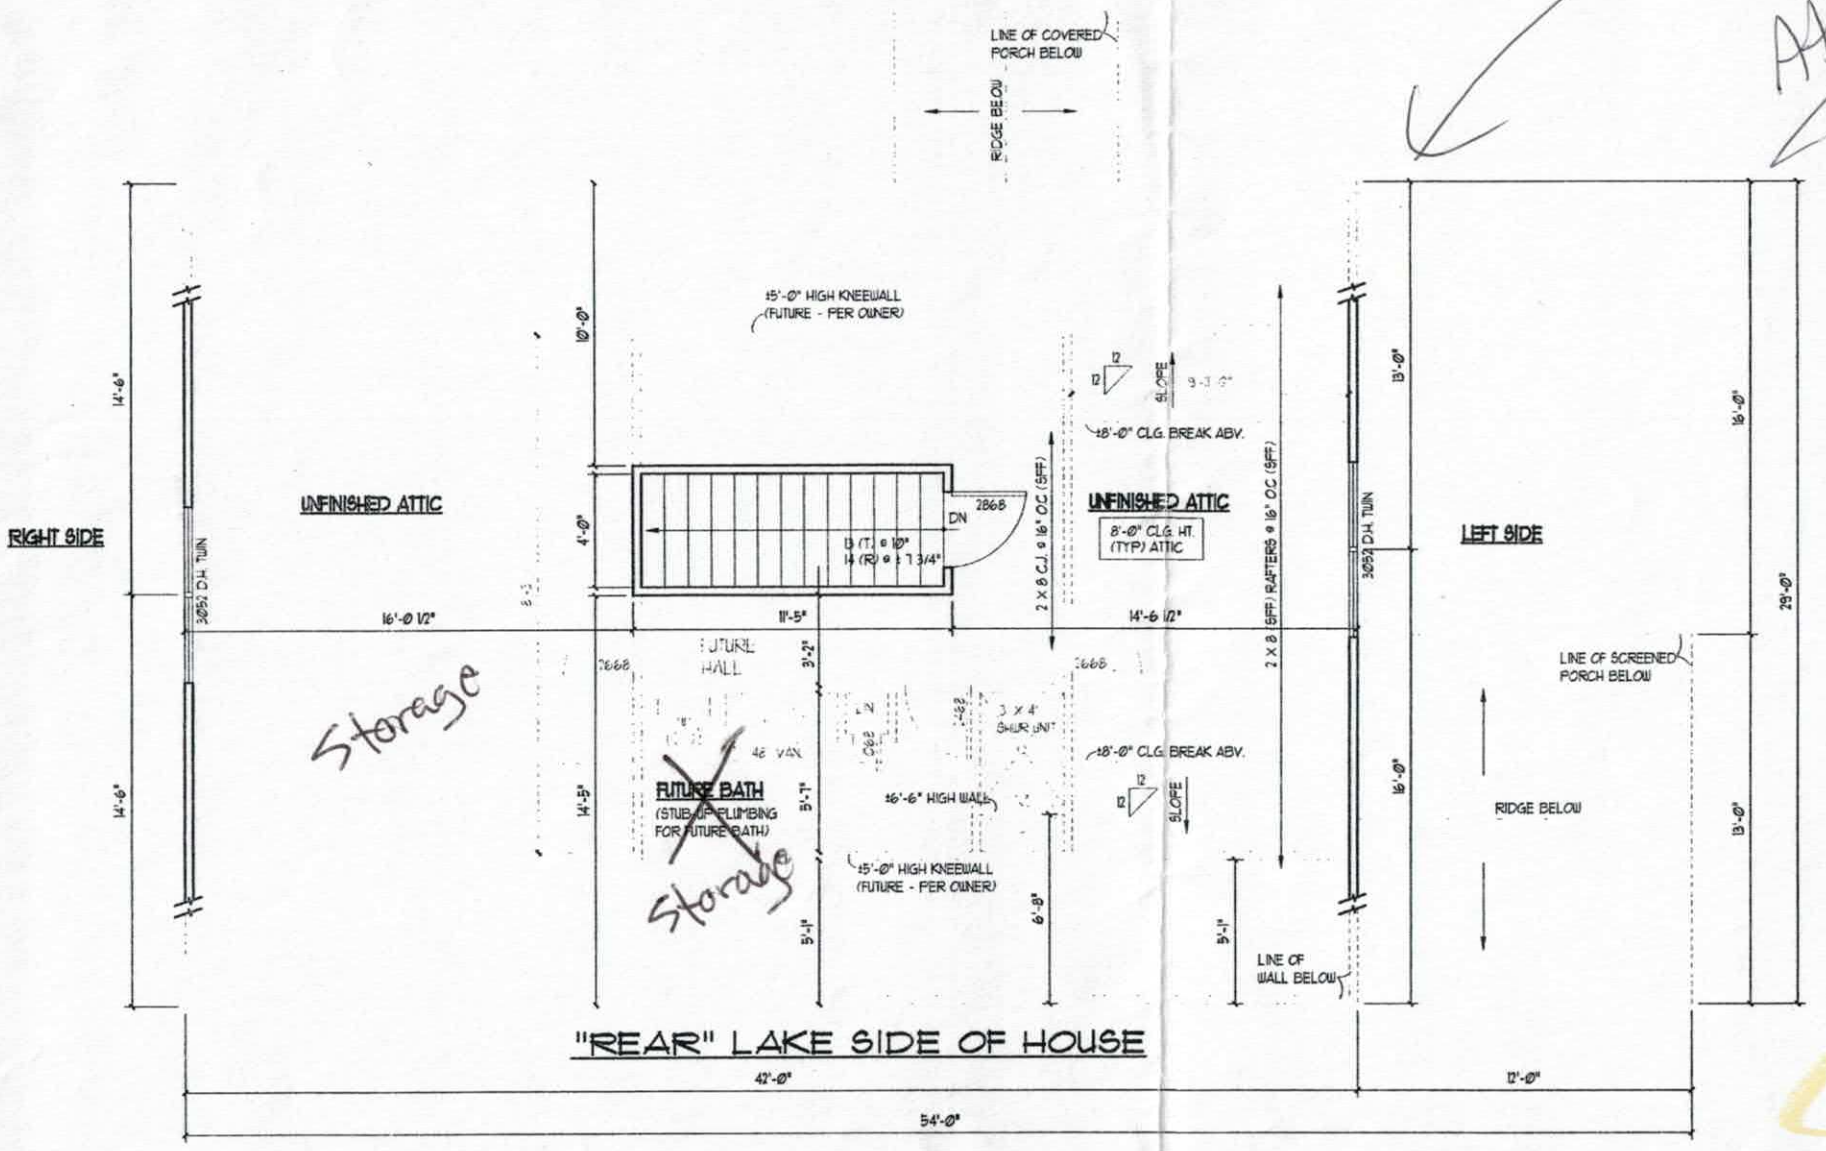

"REAR" LAKE SIDE OF HOUSE

NOTE:
EVERY EFFORT HAS BEEN MADE B
TO LOCATE AND VERIFY EXISTENC
CONTRACTOR TO VERIFY PRIOR T

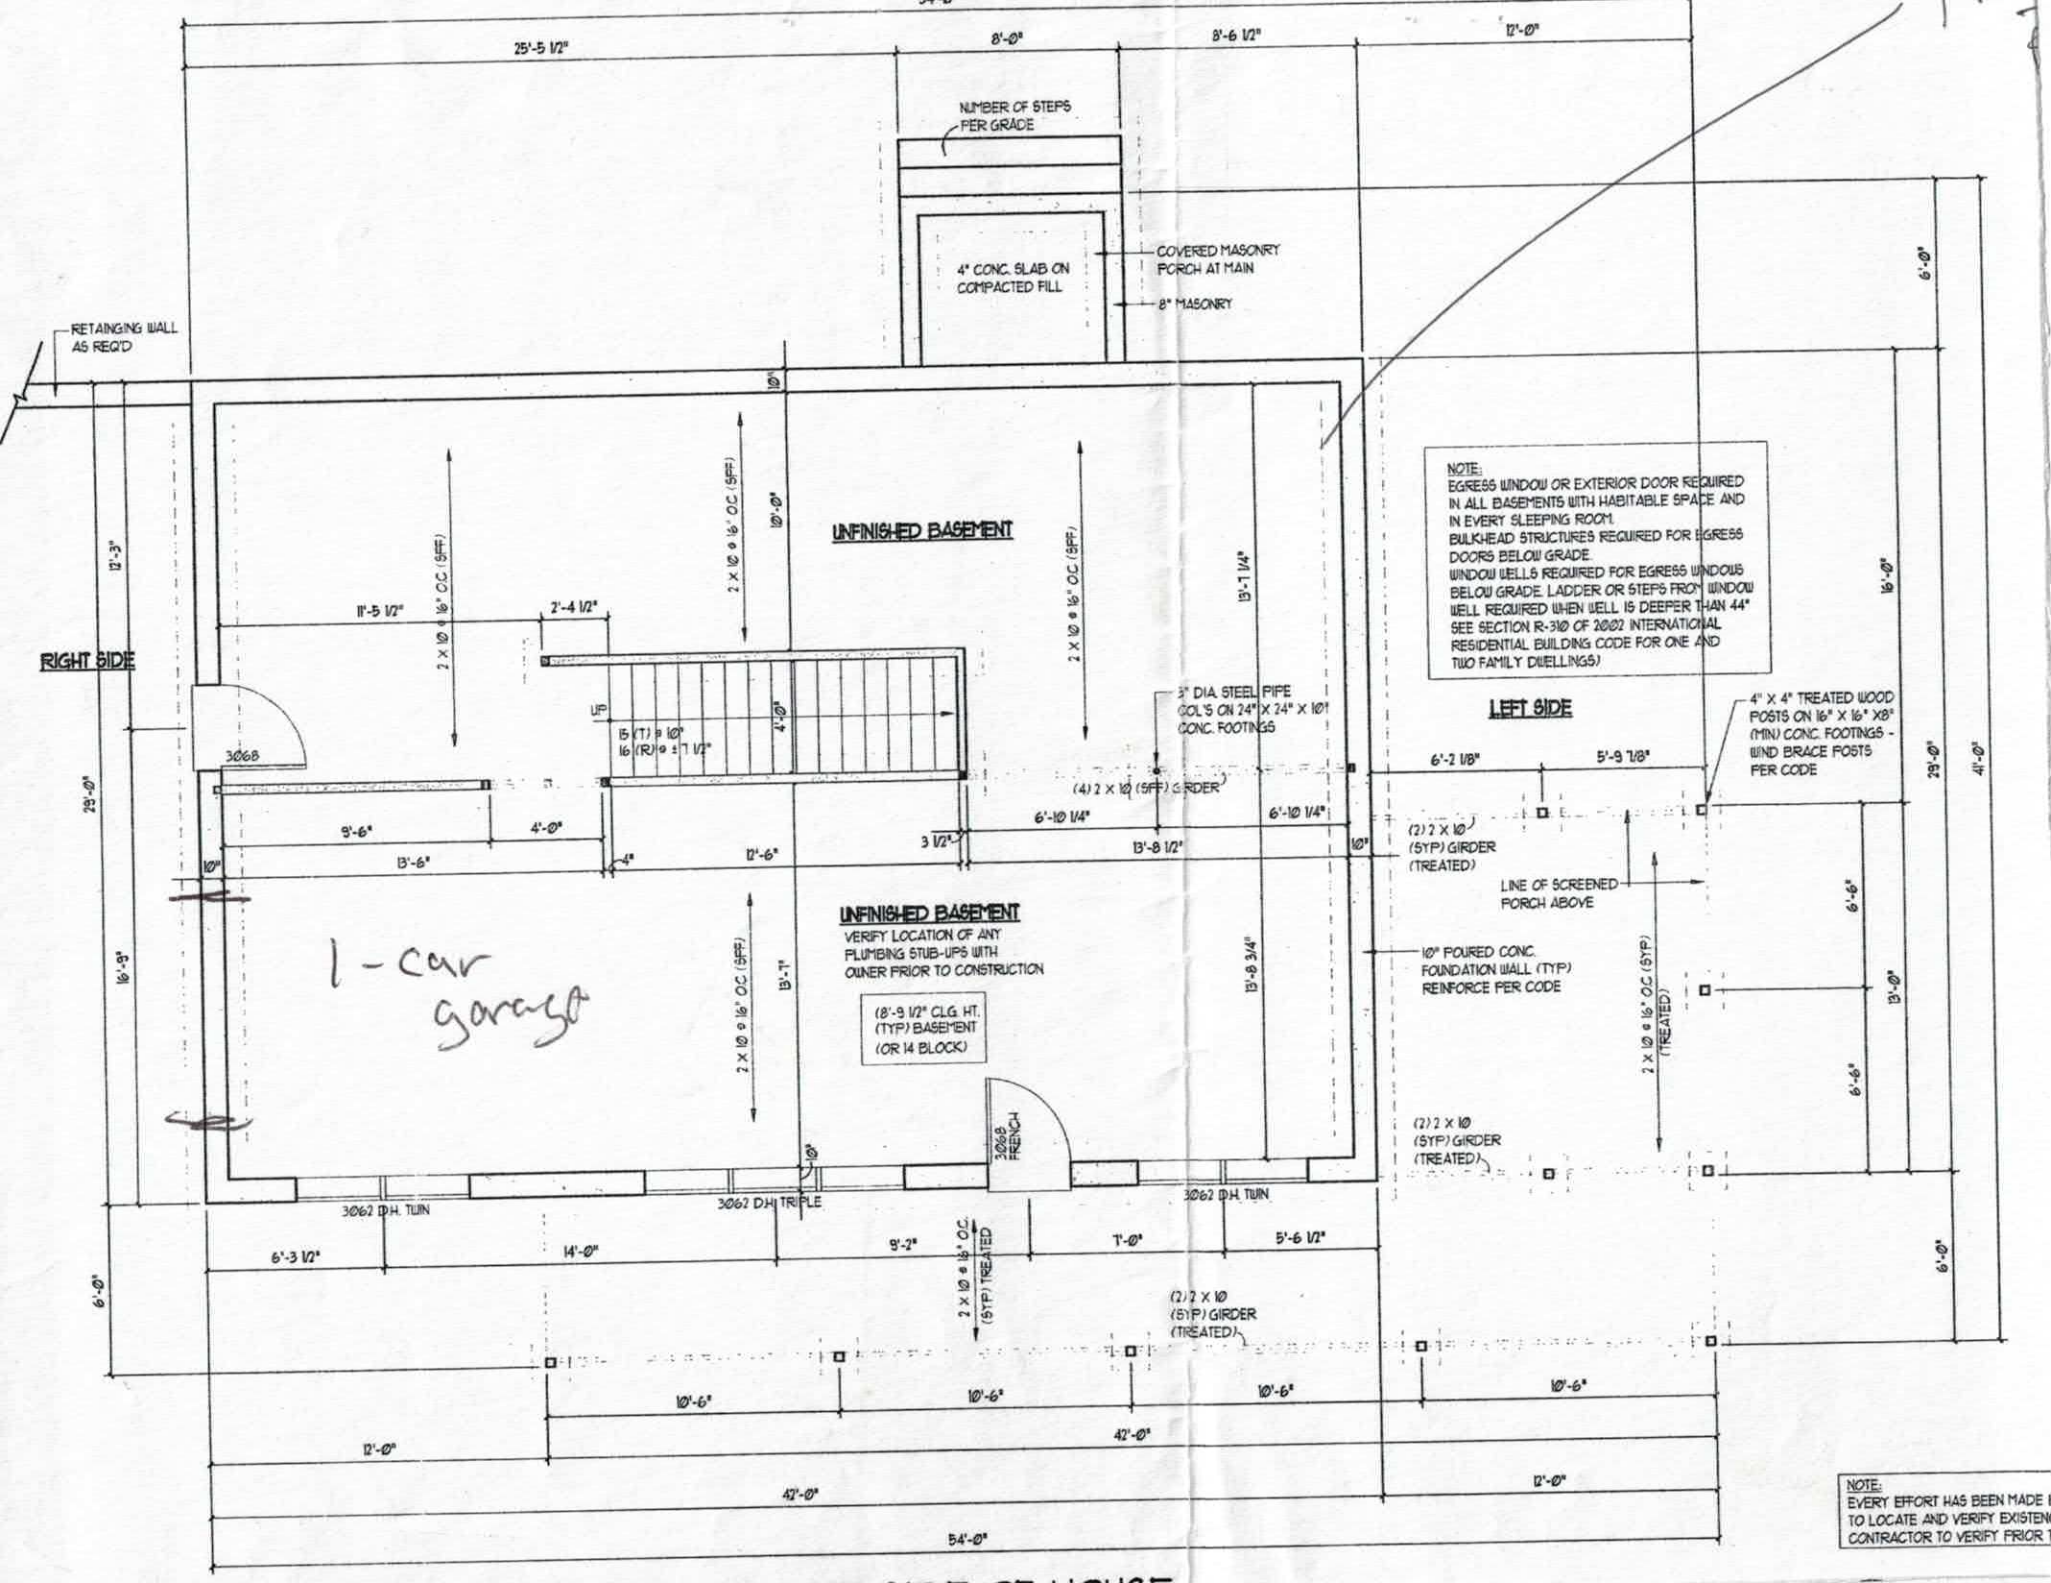
25'-5 1/2"
8'-0"
8'-6 1/2"
12'-0"
NUMBER OF STEPS PER GRADE
4" CONC. SLAB ON COMPACTED FILL
COVERED MASONRY PORCH AT MAIN
8" MASONRY
RETAINING WALL AS REQ'D
RIGHT SIDE
UNFINISHED BASEMENT
2 X 10 @ 16" O.C. (SPF)
11'-5 1/2"
2'-4 1/2"
15 (T) @ 10"
16 (R) @ 7 1/2"
4'-0"
3068
9'-6"
4'-0"
13'-6"
12'-6"
3 1/2"
6'-10 1/4"
13'-8 1/2"
(4) 2 X 10 (SPF) GIRDER
3" DIA. STEEL PIPE COL'S ON 24" X 24" X 10" CONC. FOOTINGS
13'-7 1/4"
UNFINISHED BASEMENT
VERIFY LOCATION OF ANY PLUMBING STUB-UPS WITH OWNER PRIOR TO CONSTRUCTION
(8'-9 1/2" CLG. HT. (TYP) BASEMENT (OR 14 BLOCK)
13'-7"
13'-8 3/4"
1-car garage
3068 FRENCH
3062 D.H. TWIN
3062 D.H. TRIPLE
3062 D.H. TWIN
6'-3 1/2"
14'-0"
9'-2"
1'-0"
5'-6 1/2"
2 X 10 @ 16" O.C. (SYP) TREATED
(2) 2 X 10 (SYP) GIRDER (TREATED)
10'-6"
10'-6"
10'-6"
10'-6"
42'-0"
12'-0"
42'-0"
12'-0"
54'-0"
NOTE:
EGRESS WINDOW OR EXTERIOR DOOR REQUIRED IN ALL BASEMENTS WITH HABITABLE SPACE AND IN EVERY SLEEPING ROOM.
BULKHEAD STRUCTURES REQUIRED FOR EGRESS DOORS BELOW GRADE.
WINDOW WELLS REQUIRED FOR EGRESS WINDOWS BELOW GRADE. LADDER OR STEPS FROM WINDOW WELL REQUIRED WHEN WELL IS DEEPER THAN 44" SEE SECTION R-310 OF 2002 INTERNATIONAL RESIDENTIAL BUILDING CODE FOR ONE AND TWO FAMILY DWELLINGS)
LEFT SIDE
4" X 4" TREATED WOOD POSTS ON 16" X 16" X 8" (MIN) CONC. FOOTINGS - WIND BRACE POSTS PER CODE
6'-2 1/8"
5'-9 7/8"
(2) 2 X 10 (SYP) GIRDER (TREATED)
LINE OF SCREENED PORCH ABOVE
10" POURED CONC. FOUNDATION WALL (TYP) REINFORCE PER CODE
2 X 10 @ 16" O.C. (SYP) (TREATED)
(2) 2 X 10 (SYP) GIRDER (TREATED)
29'-0"
16'-9"
12'-3"
16'-0"
13'-0"
6'-6"
6'-0"
41'-0"
NOTE:
EVERY EFFORT HAS BEEN MADE
TO LOCATE AND VERIFY EXISTEN
CONTRACTOR TO VERIFY PRIOR

Iredell County
ZONING PERMIT

227 South Center St. PO Box 788 Statesville, NC 28687 Phone 704-878-3118

Call Sanitarian between 8 a.m. & 9 a.m. Statesville 704-878-5305 Mooresville 704-664-5281

Permit #:	122141ZO	Subdivision:	
Proposed Use:	Single Family	Township:	1500 Fallstown
Location of Property:	000 Sunset View Ln. Statesville NC 28677		
Parcel #:	4710-57-7651	Zoning:	R20
Lot #:	141-142 Size: .67	Flood Plain:	Yes Watershed: WSIV-CA
Applicant:	Noble Mills	Owner:	Noble Mills
Address:	132 Sunset View Lane Statesville NC 28677	Address:	132 Sunset View Lane Statesville, NC 28677
Phone:		Phone:	
Property Recorded:	Yes Site Plan Reviewed:	Community Water:	Yes Community Sewer: No

If permitted the following minimum requirements must be met, unless Health Department requires more land area, or other qualifications are indicated in the comments.

Min. Lot Area: 25,000 Min. Front Yard: 35 ft Min. Left Side Yard: 15 ft

Min. Lot Width: 100 Min: Rear Yard: 50 ft Min: Right Side Yard: 15 ft

Min. Number Parking Spaces: Max. Built Upon Area:

Comments:

Property is located in a flood zone per GIS. Applicant has provided a survey showing the flood line realtive to a proposed area of construction on the lot.

Directions:

East Mombo, R Pineville Rd., L Spring Shore Dev., one mile R Sunsetview Lane at the end

FEES

Zoning Permit/Inspection Fee	☑	$45.00
Site Plan Review Fee	☐	$0.00
Environmental Health New System	☑	$200.00
Environmental Health Existing System	☐	$0.00
Total Fees:		$245.00

I certify that all statements made in this application and any attached documents are true, complete, and correct to the best of my knowledge and belief and are made in good faith. I understand that false information may be grounds for rejection of this application. Authorized Health Department and Planning & Enforcement Representatives are granted right of entry to make evaluations or inspections and to release information upon public request.

Applicant: Noble B Mills, II Date: 6-17-04

A non-refundable fee of $45.00 is charged on all permit applications.


ELLIOTTE BLACKWELL Printed: 6/17/2004

The applicant certifies that there are no deed restrictions, contractual agreements or governmental regulations of any kind that interfere with or prohibit the use of the property or the use for which this permit is requested. Applicant further acknowledges that the enforcement of deed restrictions, plat conditions, and other contractual agreements will not be undertaken by Iredell County and is the sole responsibility of the affected parties.

s/ Adele B. Mills, PE — 6-17-04

Applicant **Date**

STREET NAME

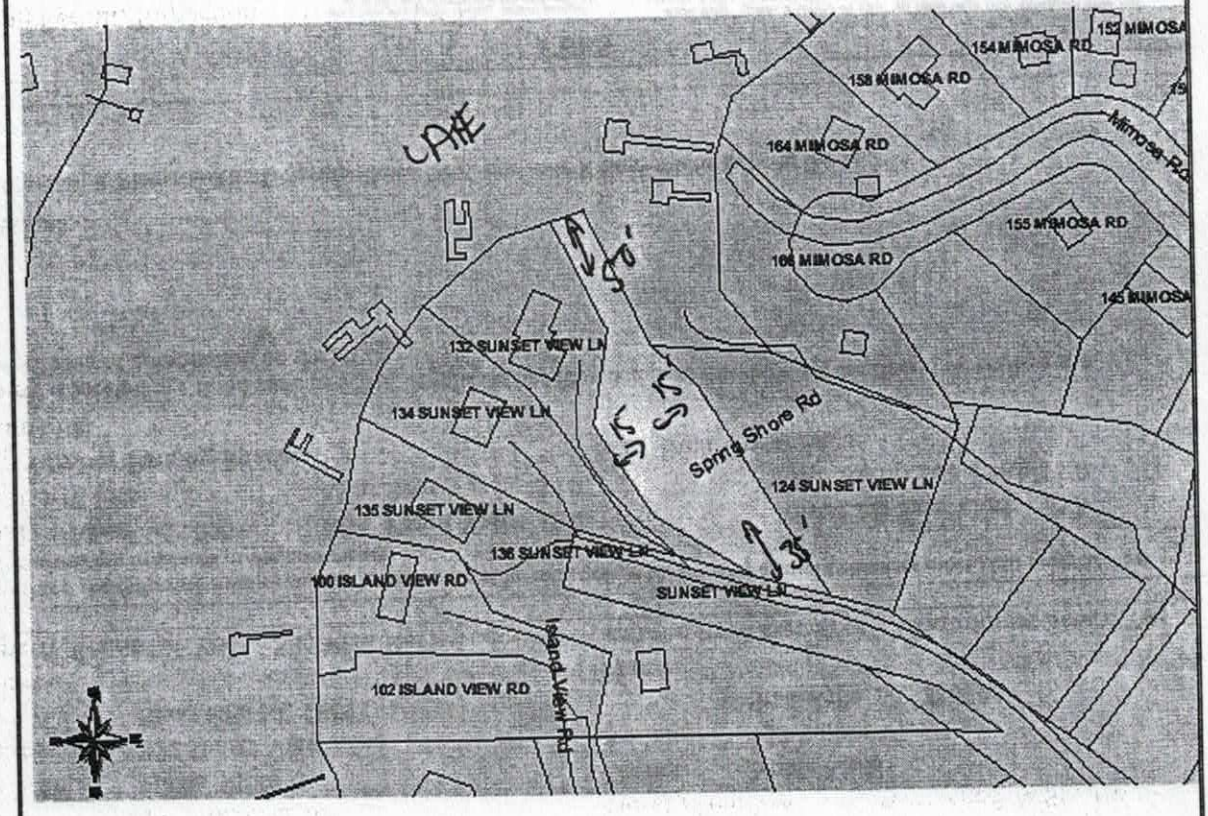

In the box above indicate the location of the building's or structure's, their orientation to the front of the lot as indicated, and the setback distances to all property lines and the distances to any other building's or structure's on the lot. Also indicate the size/shape of the lot and the corresponding dimensions when necessary. The front of the lot is the portion, which abuts a public right of way or easement.