IREDELL COUNTY HEALTH DEPARTMENT

STATESVILLE 704-878-5305 MOORESVILLE 704-664-5281

IMPROVEMENT PERMIT / AUTHORIZATION TO CONSTRUCT / OPERATION PERMIT / EXISTING SYSTEM INSPECTION

PERMIT# REPAIR PIN# 4710-58-6395 DATE 4-3-06

OWNER OR CONTRACTOR MARK S. SHILL PHONE: Business 336-577-8487 Home

ADDRESS 5261 BRIDGE POINTE DR CLEMMONS, NC 27012

LOCATION BUFFALO SHOALS RD TO LAUREL COVE RD, TL ISLAND TERRACE, TL RIVER RIDGE LN, 0.2 MILE ON LEFT AT BOX #147

SUBDIVISION RIVER HILL EST BLOCK / SECTION LOT 5 LOT AREA ~1 ACRE SITE CLASS PS DESIGN FLOW 360 L.T.A.R. EXISTING

Septic Tank: 1000 Gallons: STB Date

Pump Tank: Gallons: PT Date

Pump Make: Model Serial No.

Nitrification Field: No Fields 1 Square Feet N/A Linear Feet EXISTING

No Lines N/A Trench Width N/A Max Trench Bottom Depth N/A Gravel Depth N/A

☐ New System ☑ Repair System Type: I, II, III, IV, V, VI

System Description:

Repair System Description: CONVENTIONAL, GRAVITY

Maintenance Agreement Required: ☐ Yes ☑ No

☑ House/Mod. Home No. Bedrooms 3

☐ Mobile Home No. Bathrooms 1 1/2

☐ Business No. Employees

☐ Other


☐ Slab ☐ Crawl Space ☑ Basement w/plumbing ☐ Basement wo/plumbing

Water Supply: ☑ Individual ☐ Public ☐ Community WELL


Comments:/Conditions: ① INSTALL NEW SEPTIC TANK AT LOCATION SHOWN, CRUSH & FILL EXISTING SEPTIC TANK ② THIS PERMIT SERVES AS "NOTICE of VIOLATION", SYSTEM TO BE REPAIRED BY MAY 3, 2006

Comments:/Conditions:

INITIAL SITE SKETCH

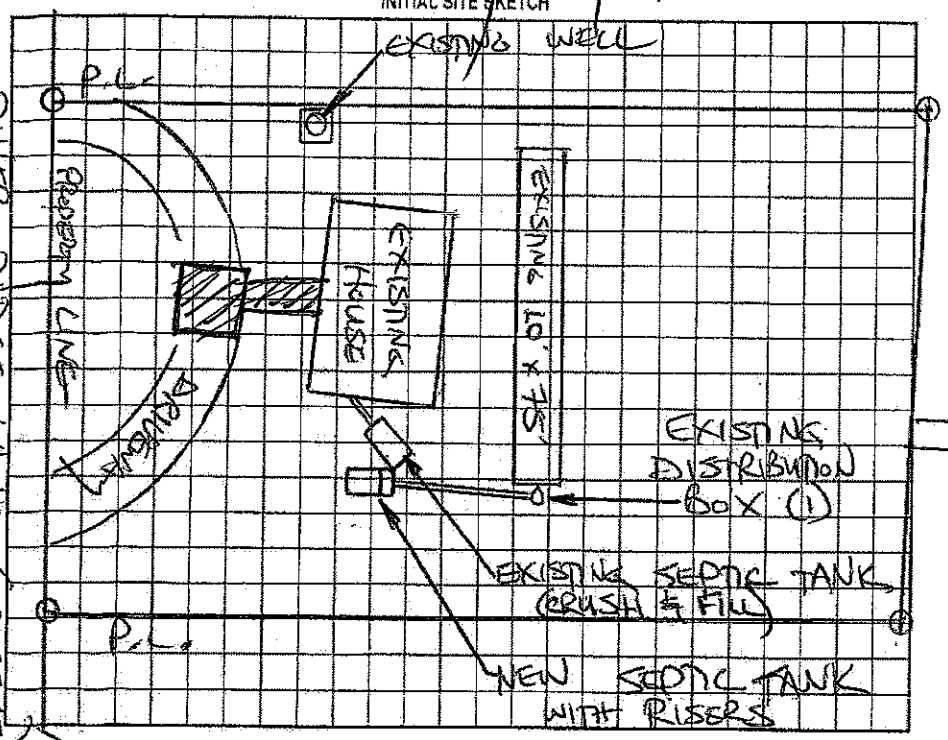

AS BUILT SKETCH

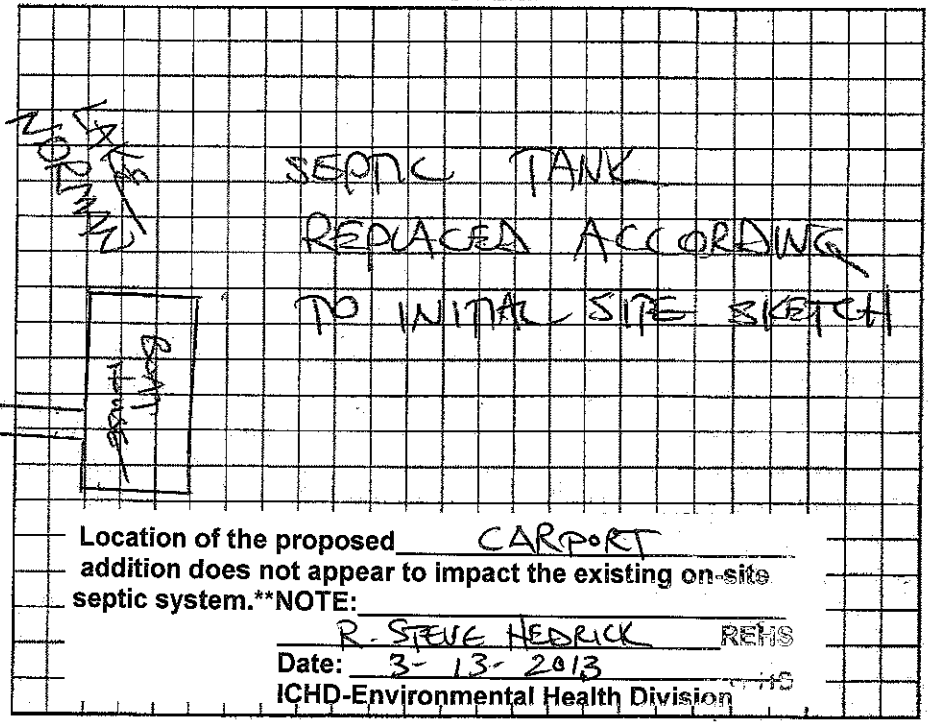

Location of the proposed CARPORT addition does not appear to impact the existing on-site septic system.NOTE:**

R. STEVE HEDRICK REHS

Date: 3-13-2013

ICHD-Environmental Health Division

Permit can be suspended or revoked if any false information is supplied toward securing the permit/any unauthorized changes are made to the site/any unauthorized changes are made in the installation of the system. Improvement Permit with plat valid without expiration. Improvement Permit with site plan valid for sixty months. Authorization to Construct is valid for a period equal to that of Improvement Permit – not to exceed sixty months.

Signed: date 4/3/06 Installed by: ROBBIE BROWN

Improvement Permit by: STEVE HEDRICK date 4-3-06 Operation Permit by: STEVE HEDRICK date 4-13-06

Authorization to Construct by: STEVE HEDRICK date 4-3-06 Existing System Inspection by: date

WILL BE SAC

HEALTH DEPT. COPY: WHITE OWNER COPY (FINAL): YELLOW OWNER COPY (INITIAL): PINK