IREDELL COUNTY HEALTH DEPARTMENT

STATESVILLE 704-878-5305 MOORESVILLE 704-664-5281

IMPROVEMENT PERMIT / AUTHORIZATION TO CONSTRUCT / OPERATION PERMIT / EXISTING SYSTEM INSPECTION

PERMIT# 138226 PIN# 4710-58-9569 DATE 1-5-07

OWNER OR APPLICANT WILSON CARTER BLDRS TED BATTY PHONE: Business 336-469-0507 Home 336-679-2031

ADDRESS PO BOX 1719 YADKINVILLE, NC 27055

LOCATION BUFFALO SHOALS ⓓ LOVE ⓛ ISLAND TRAILER ⓛ RIVER RIDGE PROPERTY ON LEFT

SUBDIVISION RIVER RIDGE BLOCK / SECTION ____ LOT 1 LOT AREA 1.05AC SITE CLASS. PS DESIGN FLOW 360 L.T.A.R. 13

Septic Tank: 1000 Gallons; STB 1007 Date 5-19-07

Pump Tank: ____ Gallons; PT ____ Date ____

Pump Make: ____ Model ____ Serial No. ____

Nitrification Field: No Fields/ ____ Square Feet EQ=1200' Linear Feet 300'

No Lines 3x100' Trench Width 36" Max Trench Bottom Depth 36" Gravel Depth N/A ☐ Gravity ☐ Pressure

☒ New System ☐ Repair ☐ Expansion System Type: I II III IV V VI

System Description: 60 IN 2500

Repair System Description: LP 50%

Maintenance Agreement Required: ☐ Yes ☒ No

☒ House/Mod. Home ☐ Mobile Home ☐ Business ☐ Other

No. Bedrooms 3 No. Persons 6 No. Employees ____

Water Supply: ☒ Individual ☐ Public ☐ Community

☐ Slab ☐ Crawl Space ☒ Basement w/plumbing ☐ Basement wo/plumbing

Comments:/Conditions: ① DOE TO SAPROLITE WELL MUST BE 100' AWAY ② HOUSE + SYSTEM FLAGGED OUT COMPLETELY ③ INSTALL LINES ON CONTOURS & MAINTAIN SETBACKS.

Comments:/Conditions: BOWCO FITTINGS & RISERS

INITIAL SITE SKETCH

SEE ATTACHED SYSTEM DESIGN BY LORNE COOK, R.S.

AS BUILT SKETCH

INSTALLED AS DRAWN SYSTEM IS 100'+ TO LINES + 100' TO TANK FROM WELL

Permit can be suspended or revoked if any false information is supplied toward securing the permit/any unauthorized changes are made to the site/any unauthorized changes are made in the installation of the system. Improvement Permit with plat valid without expiration ☐ Improvement Permit with site plan valid for sixty months ☒ Authorization to Construct is valid for a period equal to that of Improvement Permit – not to exceed sixty months.

Signed: ____ date ____ Installed by: Charles Batty

Improvement Permit by: ____ date 1-5-07 Operation Permit by: ____ date 7-18-07


Authorization to Construct by: ____ date 1-5-07 Existing System Inspection by: ____ date ____

HEALTH DEPT. COPY: WHITE OWNER COPY (FINAL): YELLOW OWNER COPY (INITIAL): PINK

System Design

Permit # 138226

PIN # 4710589569

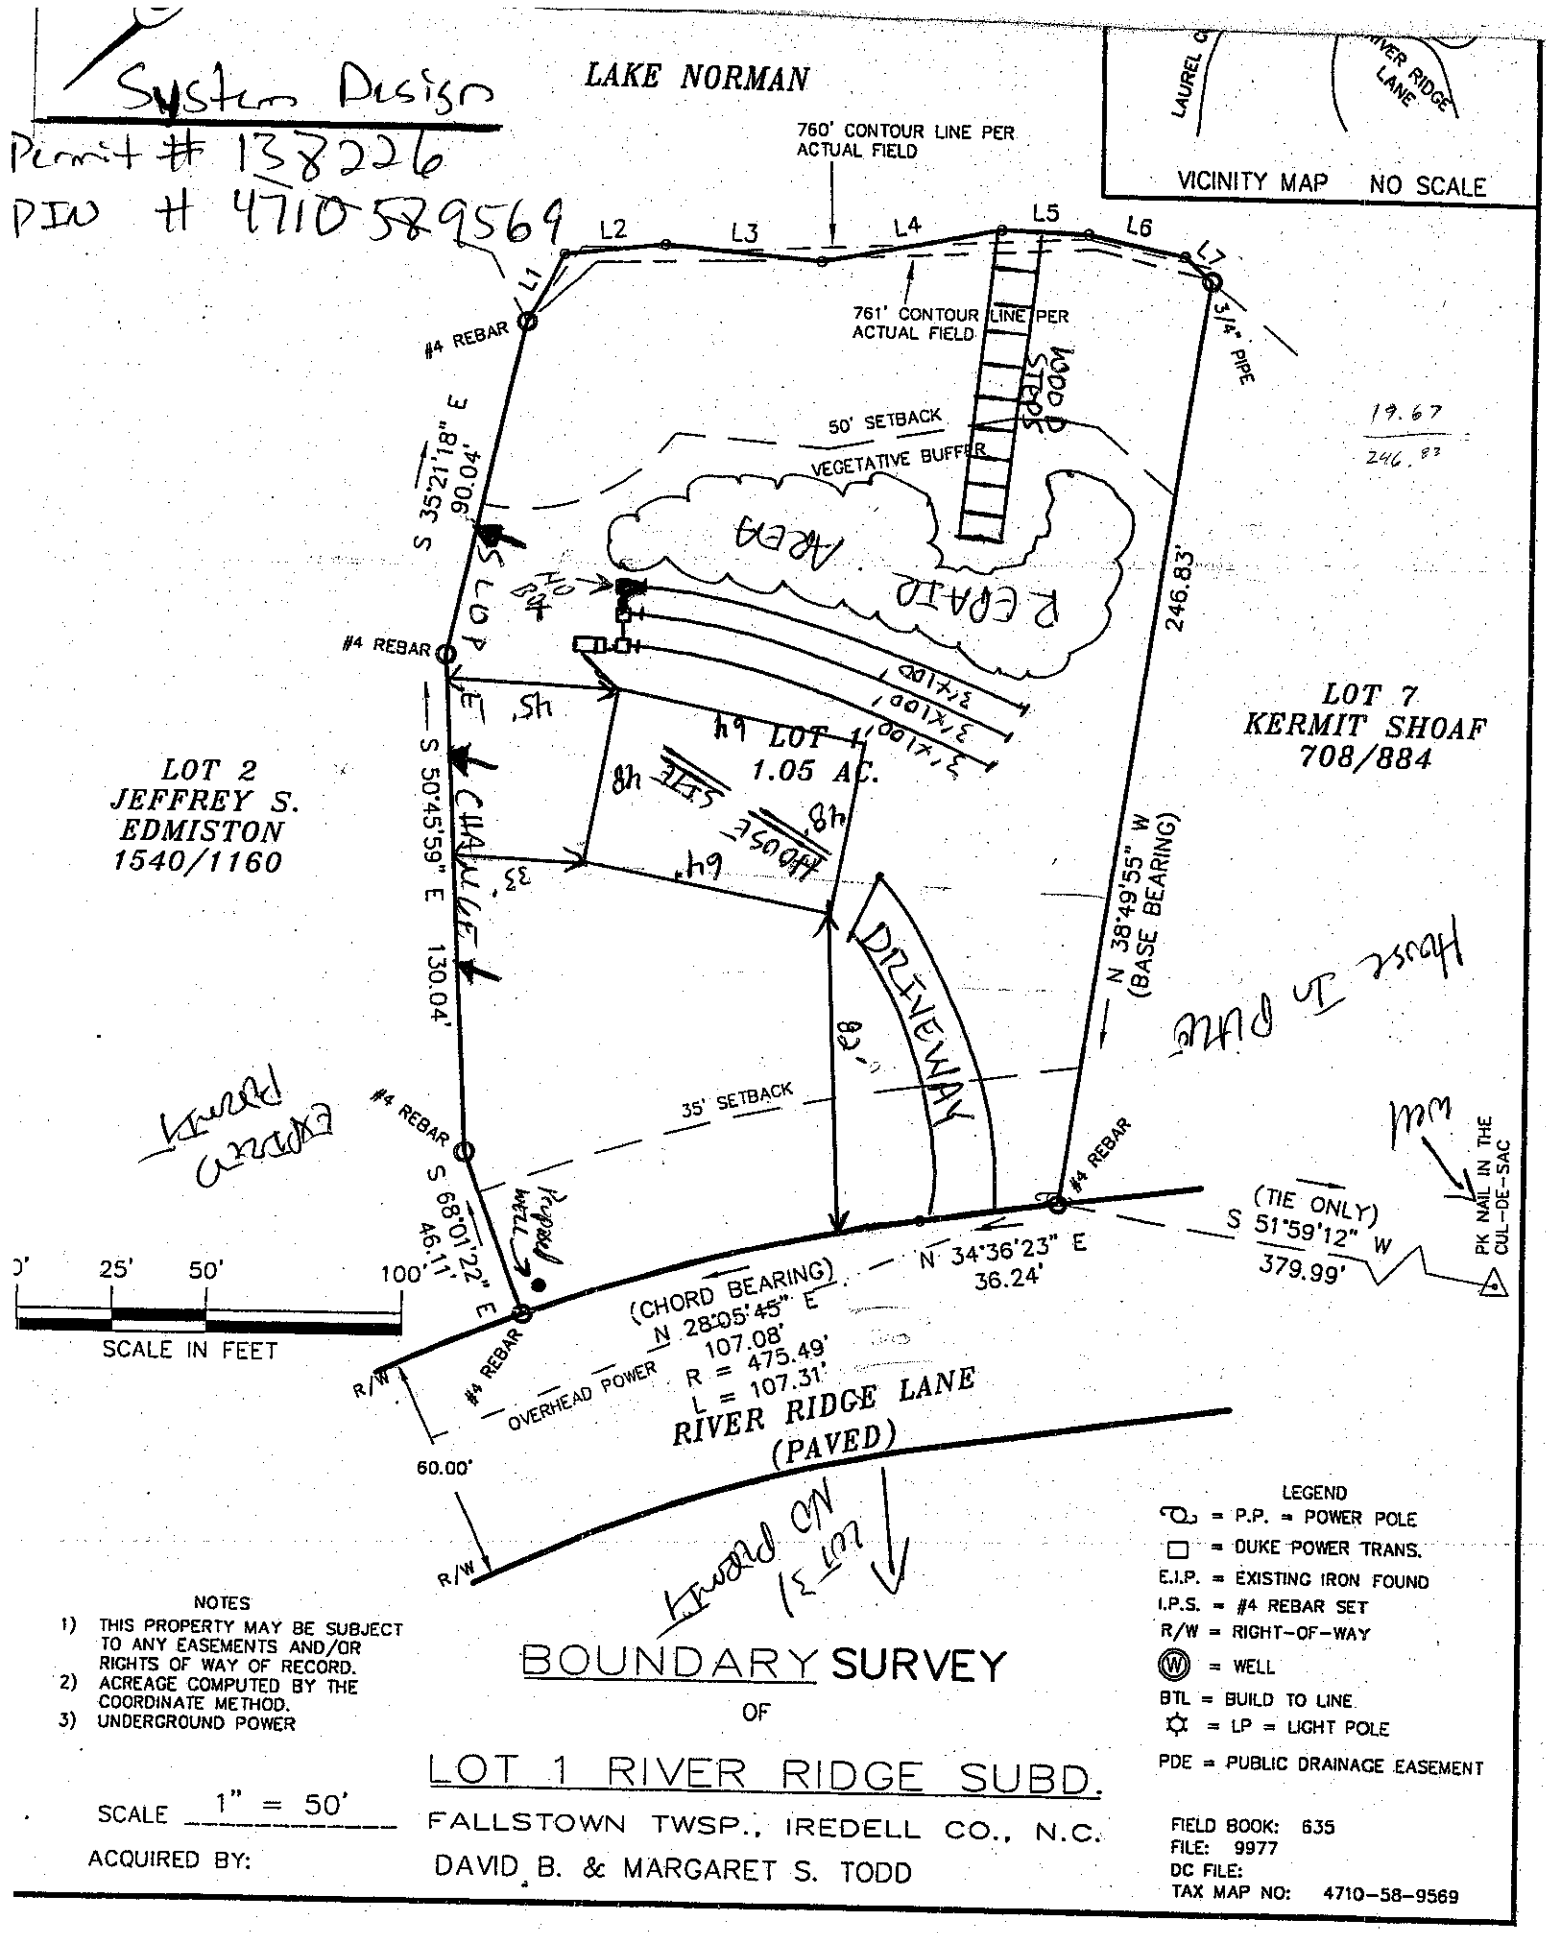

NOTES

1) THIS PROPERTY MAY BE SUBJECT TO ANY EASEMENTS AND/OR RIGHTS OF WAY OF RECORD.
2) ACREAGE COMPUTED BY THE COORDINATE METHOD.
3) UNDERGROUND POWER

LEGEND

- P.P. = POWER POLE
- = DUKE POWER TRANS.
- E.I.P. = EXISTING IRON FOUND
- I.P.S. = #4 REBAR SET
- R/W = RIGHT-OF-WAY
- (W) = WELL
- BTL = BUILD TO LINE
- = LP = LIGHT POLE
- PDE = PUBLIC DRAINAGE EASEMENT

BOUNDARY SURVEY

OF

LOT 1 RIVER RIDGE SUBD.

FALLSTOWN TWSP., IREDELL CO., N.C.

DAVID B. & MARGARET S. TODD

SCALE 1" = 50'

ACQUIRED BY:

FIELD BOOK: 635
FILE: 9977
DC FILE:
TAX MAP NO: 4710-58-9569