* THIS PERMIT VOIDS PREVIOUS PERMIT DATED 11/21/01 *

IREDELL COUNTY HEALTH DEPARTMENT

STATESVILLE 704-878-5305 (ap) MOORESVILLE 704-664-5281

IMPROVEMENT PERMIT / AUTHORIZATION TO CONSTRUCT / OPERATION PERMIT / EXISTING SYSTEM INSPECTION

PERMIT# 101205 PIN# 4710 59 1712 DATE 8/18/05

OWNER OR CONTRACTOR LAKESHORE REALTY / ELIZABETH TOUCHTON PHONE: Business 704 677 2312 Home 704 677 4798 - MAH

ADDRESS 249 WILLIAMSON RD MOORESVILLE, NC 28117

LOCATION 40W (L) OLD MOUNTAIN RD (R) BUFFALO SHOALS RD (L) LAURAL COVE RD (L) ISLAND TERRACE DR (L) LOT

SUBDIVISION River Hill Est. BLOCK / SECTION ____ LOT 21 LOT AREA .53 ACRES SITE CLASS. PS DESIGN FLOW 360 gpd L.T.A.R. .3

Septic Tank: 1000 Gallons; STB 1000 Date 02-27-06
Pump Tank: 1000 Gallons; PT 574 Date 5-16-06
Pump Make: ____ Model PCH-CSA-7K Serial No. 509930
Nitrification Field: No Fields 1 Square Feet 900 Linear Feet 300
No Lines 4 Trench Width 36" Max Trench Bottom Depth 36" Gravel Depth NA

[X] New System [ ] Repair System Type: I, II, (III), IV, V, VI
System Description: PUMP 25% REDUCTION
Repair System Description: LP PPBRS
Maintenance Agreement Required: [ ] Yes [X] No

[X] House/Mod. Home No. Bedrooms 3
[ ] Mobile Home No. Bathrooms 3
[ ] Business No. Employees ____
[ ] Other ____


[ ] Slab [ ] Crawl Space [X] Basement w/plumbing [ ] Basement wo/plumbing

Water Supply: [X] Individual [ ] Public [ ] Community

Comments:/Conditions:

SCALE 1" = 50'

INITIAL SITE SKETCH

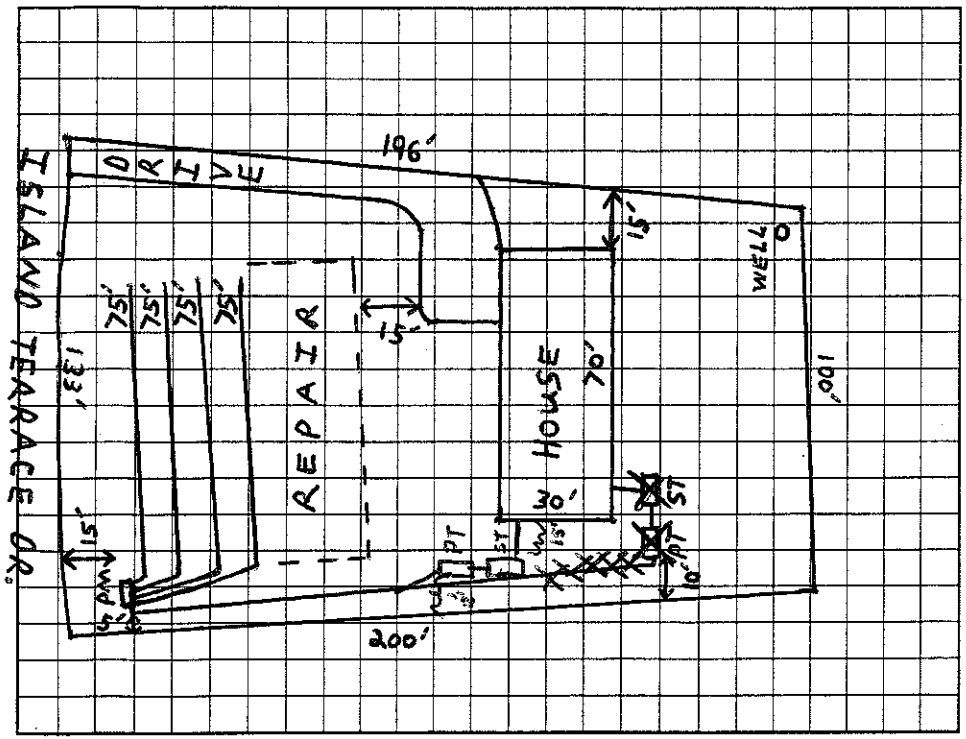

Comments:/Conditions:

Pump tank Brown
Septic tank Brown Marker
Brown Jetter

AS BUILT SKETCH

Permit can be suspended or revoked if any false information is supplied toward securing the permit/any unauthorized changes are made to the site/any unauthorized changes are made in the installation of the system. Improvement Permit with plat valid without expiration. Improvement Permit with site plan valid for sixty months. Authorization to Construct is valid for a period equal to that of Improvement Permit – not to exceed sixty months.

Signed: Elizabeth A. Touchton date 5/3/06

Improvement Permit by: [signature] date 8/18/05

Authorization to Construct by: James Stevens date 5-3-06

Installed by: Richard Hannah

Operation Permit by: James [signature] date 7-25-06

Existing System Inspection by: ____ date ____

HEALTH DEPT. COPY: WHITE OWNER COPY (FINAL): YELLOW OWNER COPY (INITIAL): PINK