D CI

IREDELL COUNTY HEALTH DEPARTMENT

STATESVILLE 704-878-5305 MOORESVILLE 704-664-5281

IMPROVEMENT PERMIT / AUTHORIZATION TO CONSTRUCT / OPERATION PERMIT / EXISTING SYSTEM INSPECTION

PERMIT# 095475 PIN# 4710-59-8325 DATE 10/8/01

OWNER OR CONTRACTOR BO & NC Inc. PHONE: Business 704-425-1600 Home

ADDRESS 5734 Hwy 150 E Denver NC 28037

LOCATION OMR, TR Buffalo Shoals, TL Laurel Cove, TL Island Terrace on Corner of River Ridge

SUBDIVISION River Hill Est BLOCK / SECTION LOT 8 LOT AREA 0.59 AC SITE CLASS PS DESIGN FLOW 360 L.T.A.R. 0.3

Septic Tank: 1000 Gallons: STB 312 Date 9-31-01
Pump Tank: Gallons: PT Date
Pump Make: Model Serial No.
Nitrification Field: No Fields 1 Square Feet 1200 Linear Feet 400
No Lines 4 @ 100' Trench Width 36" Max Trench Bottom Depth 36"

☒ New System ☐ Repair System Type: (I) II III IV V VI
System Description: Gravity Conventional
Repair System Description: Gravity 25% Red.
Maintenance Agreement Required: ☐ Yes ☒ No


☒ House/Mod. Home ☐ Mobile Home ☐ Business ☐ Other
No. Bedrooms 3 No. Bathrooms 3 No. Employees
Gravel Depth 12" ☐ Slab ☒ Crawl Space ☐ Basement w/plumbing ☐ Basement wo/plumbing

Water Supply: ☒ Individual ☐ Public ☐ Community

Comments/Conditions:

Comments/Conditions ZABEL FILTER & MARKER

INITIAL SITE SKETCH

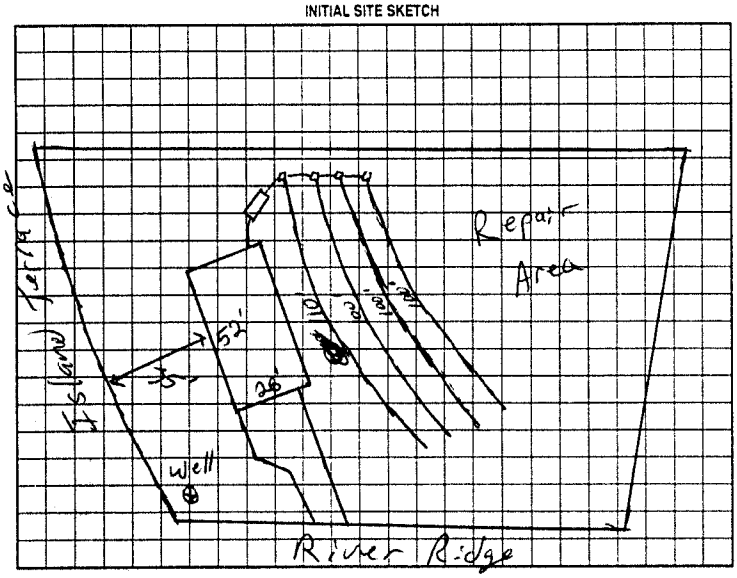

AS BUILT SKETCH

1st LINE = OK. MAY NEED TO CHANGE TO SHALLOW DROP BOX DEPENDING ON THE ONLY ditches changes

2nd LINE = NEEDS SHALLOW BOX, IT WILL BUST OUT OF GROUND IF DON'T. LINE HAS 4' OF HALL TRENCH BOTTOM & 5" FALL TOP OF PIPE, FIX IT BY ADDING ON TO CONC LINES the difference that not in compliance

3RD LINE = NEEDS SHALLOW DROP BOX

4th LINE = NEEDS CHECKING

11/16/01

BOXES LOWERED & 2nd DITCH FIXED, 3RD DITCH FINE, 4th DITCH FINE, EVERYTHING OK & 1st LINE HAS 10' EXTRA.

ELEVATION OF OUTLETS ON DROP BOXES PUSHED & WILL NOT BUST OUT OF GROUND UNLESS EXCESSIVE LANDSCAPING RESULTS (CUTTING).

Permit can be suspended or revoked if any false information is supplied toward securing the permit/any unauthorized changes are made to the site/any unauthorized changes are made in the installation of the system. Improvement Permit with plat valid without expiration. Improvement Permit with site plan valid for sixty months. Authorization to Construct is valid for a period equal to that of Improvement Permit – not to exceed sixty months.

Signed: Deane Caudle date 10-9-01

Improvement Permit by: RSI date 10/8/01

Authorization to Construct by: RSI date 10/8/01

Installed by: TIM AMMONS

Operation Permit by: RS date 11-16-01

Existing System Inspection by: date

HEALTH DEPT COPY. WHITE OWNER COPY (FINAL) YELLOW OWNER COPY (INITIAL) PINK