Postcard-op-920-01

IREDELL COUNTY HEALTH DEPARTMENT

STATESVILLE 704-878-5305 MOORESVILLE 704-664-5281

IMPROVEMENT PERMIT / AUTHORIZATION TO CONSTRUCT / OPERATION PERMIT / EXISTING SYSTEM INSPECTION

PERMIT# 95476 PIN# 4710 59 8495 DATE 7/19/01

OWNER OR CONTRACTOR R&D of NC Inc PHONE: Business 704-425-1600 Home

ADDRESS 5734 Hwy 150 E Denver NC 28037

LOCATION Buffalo Shoals, TL Laurel Cove, TL Island Terrace on Lt.

SUBDIVISION River Hill Est BLOCK / SECTION LOT 9 LOT AREA 0.75 AC SITE CLASS PS DESIGN FLOW 360 L.T.A.R. 0.3

Septic Tank: 1000 Gallons: STB 794 Date 8-11-01
Pump Tank: Gallons; PT Date
Pump Make: Model Serial No
Nitrification Field: No Fields 1 Square Feet 1200 Linear Feet 400
No Lines 4 @ 100' Trench Width 36" Max Trench Bottom Depth 36" Gravel Depth 12"

[X] New System [ ] Repair System Type: I (II) III IV V VI
System Description: Gravity Conventional
Repair System Description: Stone
Maintenance Agreement Required: [ ] Yes [X] No


[X] House/Mod. Home No. Bedrooms 3
[ ] Mobile Home No. Bathrooms 2
[ ] Business No. Employees
[ ] Other
[ ] Slab [X] Crawl Space [ ] Basement w/plumbing [ ] Basement wo/plumbing

Water Supply: [X] Individual [ ] Public [ ] Community


Comments/Conditions:

Comments/Conditions: - Zabel Filter Installed
- Septic marker Installed

INITIAL SITE SKETCH

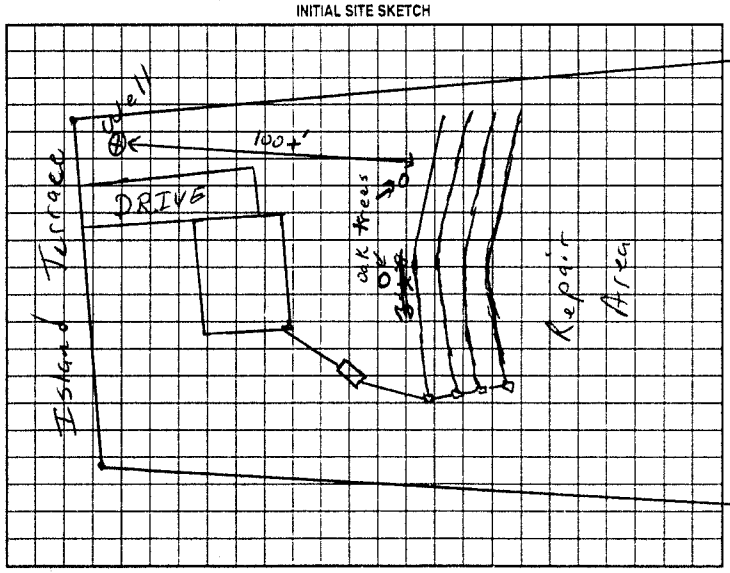

AS BUILT SKETCH

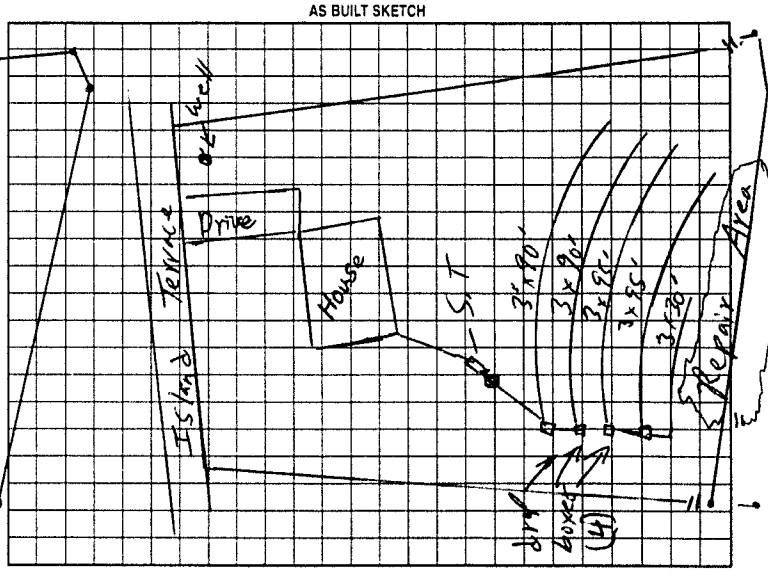

Permit can be suspended or revoked if any false information is supplied toward securing the permit/any unauthorized changes are made to the site/any unauthorized changes are made in the installation of the system. Improvement Permit with plat valid without expiration. Improvement Permit with site plan valid for sixty months. Authorization to Construct is valid for a period equal to that of Improvement Permit – not to exceed sixty months.

Signed: Duane Lovedahl date 7-25-01 Installed by: Tim Ammons

Improvement Permit by: [signature] RSE date 7/19/01 Operation Permit by: William O. Johnson date 9/19/01

Authorization to Construct by: [signature] RSE date 7/19/01 Existing System Inspection by: date

HEALTH DEPT COPY: WHITE OWNER COPY (FINAL): YELLOW OWNER COPY (INITIAL): PINK