...LL COUNTY HEALTH DEPARTMENT

STATESVILLE 704-878-5305 MOORESVILLE 704-664-5281

@THIS PERMIT REPLACES PREVIOUS ISSUED 6-17-2008

...VEMENT PERMIT / AUTHORIZATION TO CONSTRUCT / OPERATION PERMIT / EXISTING SYSTEM INSPECTION

144773 PIN # 4710-65-6684 DATE APRIL 16, 2010

...CANT SHANNON MYERS PHONE: Business 704-239-0059 Home:

...ANT ADDRESS 129 SINGLETON ROAD, MOORESVILLE NC 28117

...IONS EAST MONBO ROAD TO PINEVILLE ROAD, TL SUNNY PATH LANE, STAIGHT AHEAD AT END

SUBDIVISION R.T. SETZER EST. BLOCK / SECTION LOT # 11 LOT AREA 0.48Ac DESIGN FLOW 480 L.T.A.R. 0.50 GPD/FT²

Septic Tank 1000 Gallons: STB 425 Date 3-11-10

Pump Tank 1000 Gallons: PT 325 Date 3-18-10

Pump Make Model Serial #

Nitrification Field No Fields 1 No Lines 4 Linear Feet 160

Trench Width 24" Max. Trench Bottom Depth 30" Stone Depth 24"

☑ New System ☐ Repair ☐ Expansion System Type I II III IV V VI

System Description: 50% REDUCTION, LOW-PRESSURE

Repair System Description: 15A NCAC 18A .1945 (c)

Maintenance Agreement Required ☑ YES ☐ NO

☐ GRAVITY ☑ PRESSURE

☑ Residence No. Bedrooms 4

☐ Business No. Persons

☐ Other No. Employees

☐ Slab ☐ Crawl Space

☑ Basement w/plumbing ☐ Basement w/o plumbing

Water Supply: ☑ Private ☐ Public WELL ☐ Community


Comments / Conditions: (1) GRADING ACTIVITES IN AREA of DRAINFIELD SHALL NOT EXCEED LIMITS SET FORTH IN ATTACHED GRADING PLAN. (2) CONTACT HEALTH DEPARTMENT AFTER GRADING PRIOR TO SYSTEM INSTALLATION TO FLAG DRAINFIELD.

Comments / Conditions: (3) SEE ATTACHED SHEETS FOR PUMP & PRESSURE MANIFOLD REQUIREMENTS. (4) INSTALL 50% REDUCTION SYSTEM USING 38 PPBPS PANELS. (5) KEEP SUPPLY LINE MINIMUM 5' FROM PROPERTY LINE


INITIAL SITE SKETCH

~SCALE: 1"=30'

(THIS IS NOT A SURVEY)

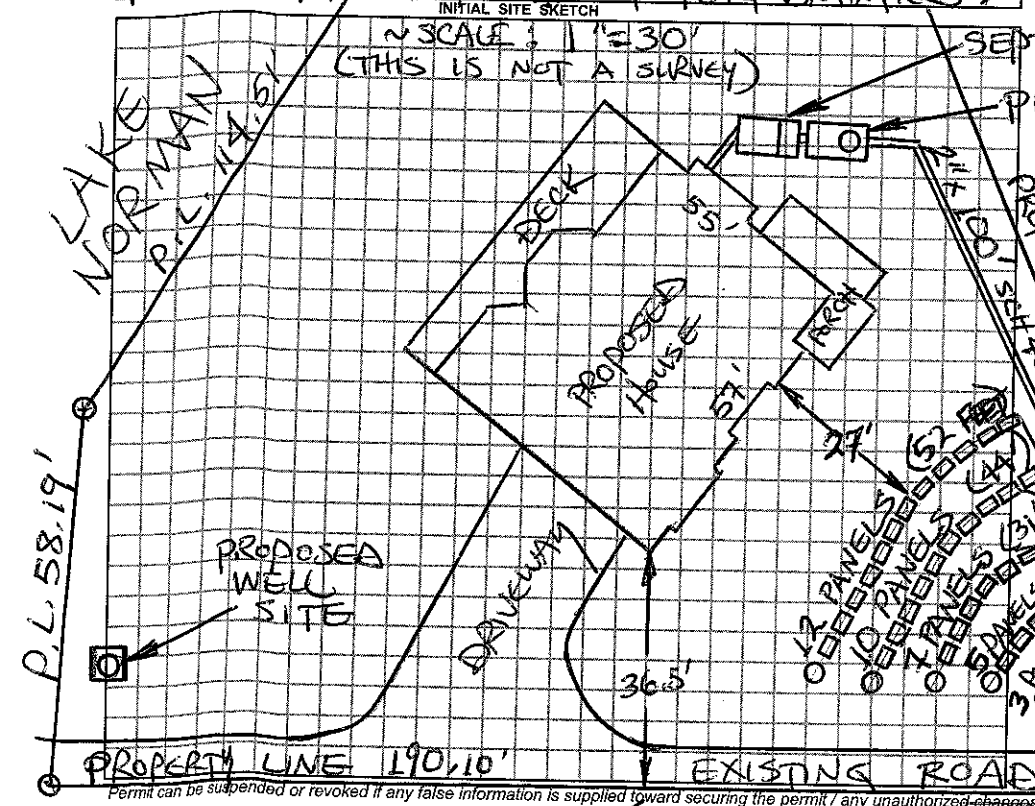

AS BUILT SKETCH

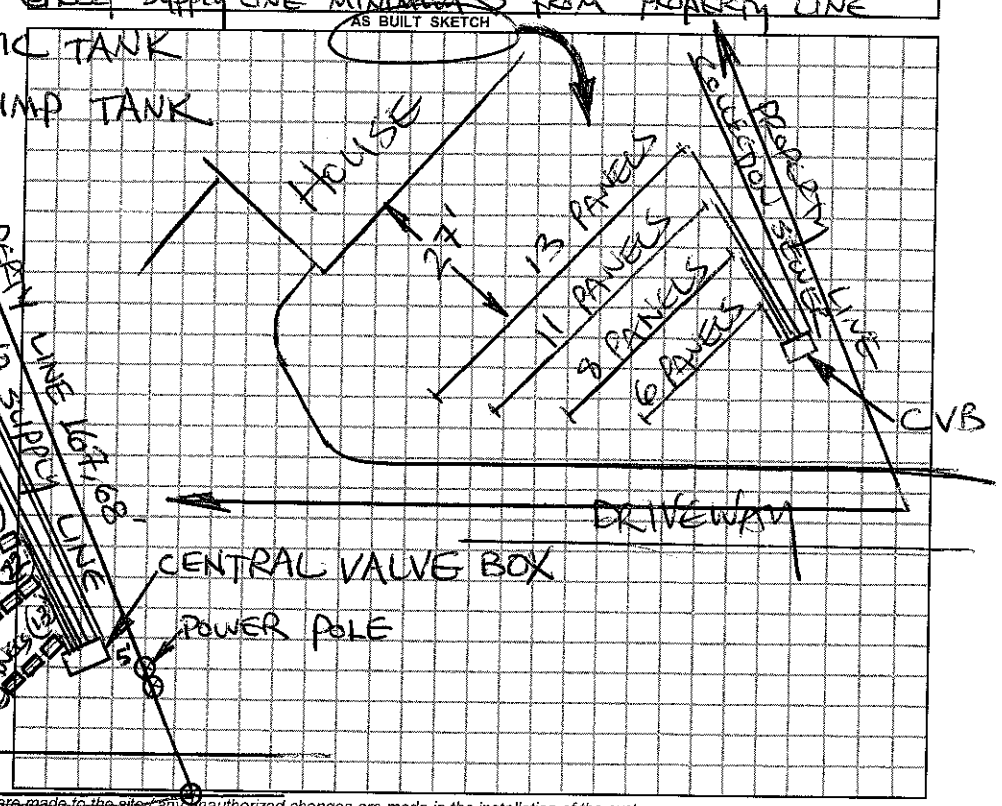

Permit can be suspended or revoked if any false information is supplied toward securing the permit / any unauthorized ~~changes are made to the site~~ / any unauthorized changes are made in the installation of the system.

☐ *IMPROVEMENT PERMIT w / plat valid without expiration* ☑ *IMPROVEMENT PERMIT w / site plan valid for 60 mos.* ☐ *AUTHORIZATION TO CONSTRUCT valid for period equal to IMPROVEMENT PERMIT-not to exceed 60 mo.*

Owner / Applicant Signature: _____ Date _____

Improvement Permit by: STEVE HEDRICK Date 4-16-2010

Authorization to Construct by: STEVE HEDRICK Date 4-16-2010

YOU SHOULD CONTACT A LOCATOR SERVICE PRIOR TO ANY EXCAVATION.

Installed by: ROWAN SEPTIC

Operation Permit by: STEVE HEDRICK Date: 12-16-10

Existing System Inspected by: _____ Date: _____

WHITE COPY Environmental Health YELLOW COPY (Final) Owner / Applicant PINK COPY (Initial) Owner / Applicant