ICHD - ENVIRONMENTAL HEALTH DIVISION

Statesville Office (704) 878-5305 Mooresville Office (704) 660-3625 PERMIT # 2023-16029

SEPTIC: IMPROVEMENT PERMIT / AUTHORIZATION TO CONSTRUCT / OPERATION PERMIT / EXISTING SYSTEM / Repair PIN # 4710 -- 65 -- 8762

APPLICANT/OWNER: Jeanie Lentz APPLICANT ADDRESS: 463 Lentz Rd, Statesville

SITE ADDRESS: 257 Sunny Path Ln, Statesville 28677 PHONE: 980-829-3278 ALT. PHONE 704-657-3526

SITE DIRECTIONS: Buffalo Shoals - Pineville - Sunny Path SAP CONTROLLED: ☐ YES ☐ NO


SUBDIVISION: RT Setzer Estate SECTION: - LOT # 8 LOT AREA: 0.51 acres DESIGN FLOW: EX L.T.A.R.: EX

Septic Tank	1000 (gal)	STB	INFILTRATOR	Date	—	☐ New System	☒ Repair	☐ Expansion	System Type: I (II) III IV V VI
Pump Tank	(gal)	PT		Date		System Description:			
Pump Make		Model		Serial #		Repair System Description:	Tank Replacement		
# Nitrification Fields	EX	# Lines	EX	Linear Ft	EX	Maintenance Agreement Required:	☐ YES	☒ NO	
Trench Width	EX	Trench Bottom Depth(Low side)	EX	Gravel Depth	EX	☒ GRAVITY	☐ PRESSURE		

☒ Residence	No. Bedrooms	EX	Water Supply
☐ Business	No. Persons	EX	☒ Private
☐ Other	No. Employees		☐ Public
☐ Slab	☐ Crawl Space		☐ Community
☒ Basement w/plumbing		☐ Basement w/o plumbing	

Comments / Conditions: Pump, crush, & fill old tank. Replace distribution if necessary.

INITIAL SITE SKETCH

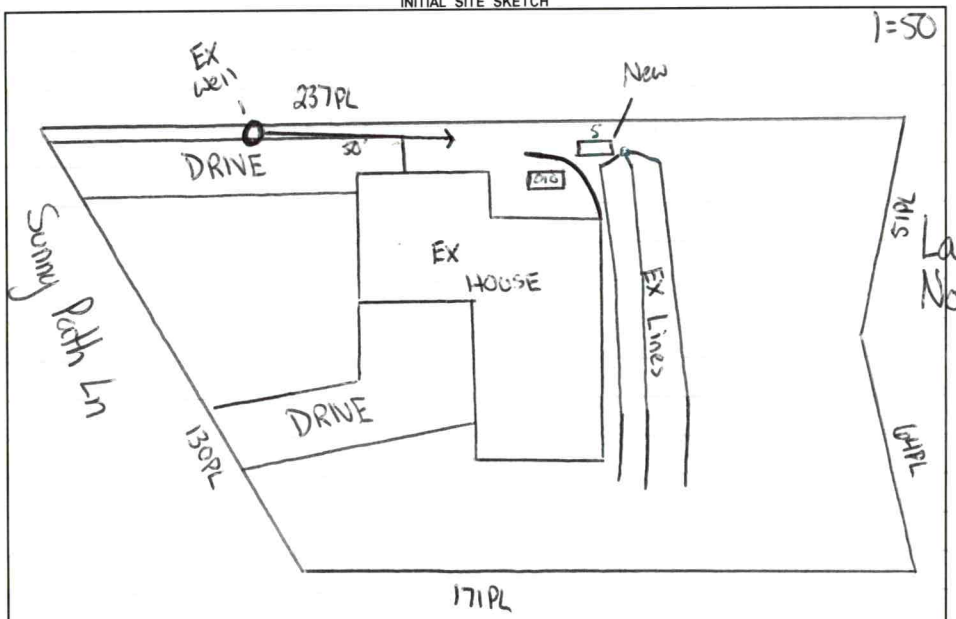

AS BUILT SKETCH

FOR SEPTIC FINAL INSPECTION CALL: 704-664-3703 between 8am-9am the day the inspection is needed. Be sure to speak with an inspector to confirm your time.

installed as drawn

Permit can be suspended or revoked if any false information is supplied toward securing the permit / any unauthorized changes are made to the site / any unauthorized changes are made in the installation of the system. **CONTACT A LOCATOR SERVICE PRIOR TO ANY EXCAVATION**

☐ **IMPROVEMENT PERMIT** ***with plat*** *valid without expiration.* ☒ **IMPROVEMENT PERMIT** ***with site plan*** *valid for 60 mos.* ☒ **AUTHORIZATION TO CONSTRUCT** *valid for period equal to IMPROVEMENT PERMIT--not to exceed 60 mo.*

Owner / Applicant Signature: Online Signature Date:

IMPROVEMENT PERMIT by: Cory Hill Date: 2/17/23

AUTHORIZATION TO CONSTRUCT by: Cory Hill Date: 2/17/23

Installed by: Michael Powell


OPERATION PERMIT by: Sarah Williams Date: 1/17/2024

Existing System Inspected by: Date:

FOR SEPTIC FINAL INSPECTION: CALL 704-664-3703 between 8am-9am the day the inspection is needed.

Item	Date	Initials
Drain Lines Checked		
Tanks Checked		
Pressure Manifold or Valve Box Checked		
Pressure Head Set		
Electrical Checked		
Floats Set		
Alarm Checked		
Maintenance Contract Needed? Y / N		
Comments:		

Repairs Only	
	State Code
Failing System Code	
Type of Distribution	G or P
Type of Failure/Malfunction	
Primary Cause of Failure/Malfunction	
Age of System? _____	
Initial or Repair? _____	

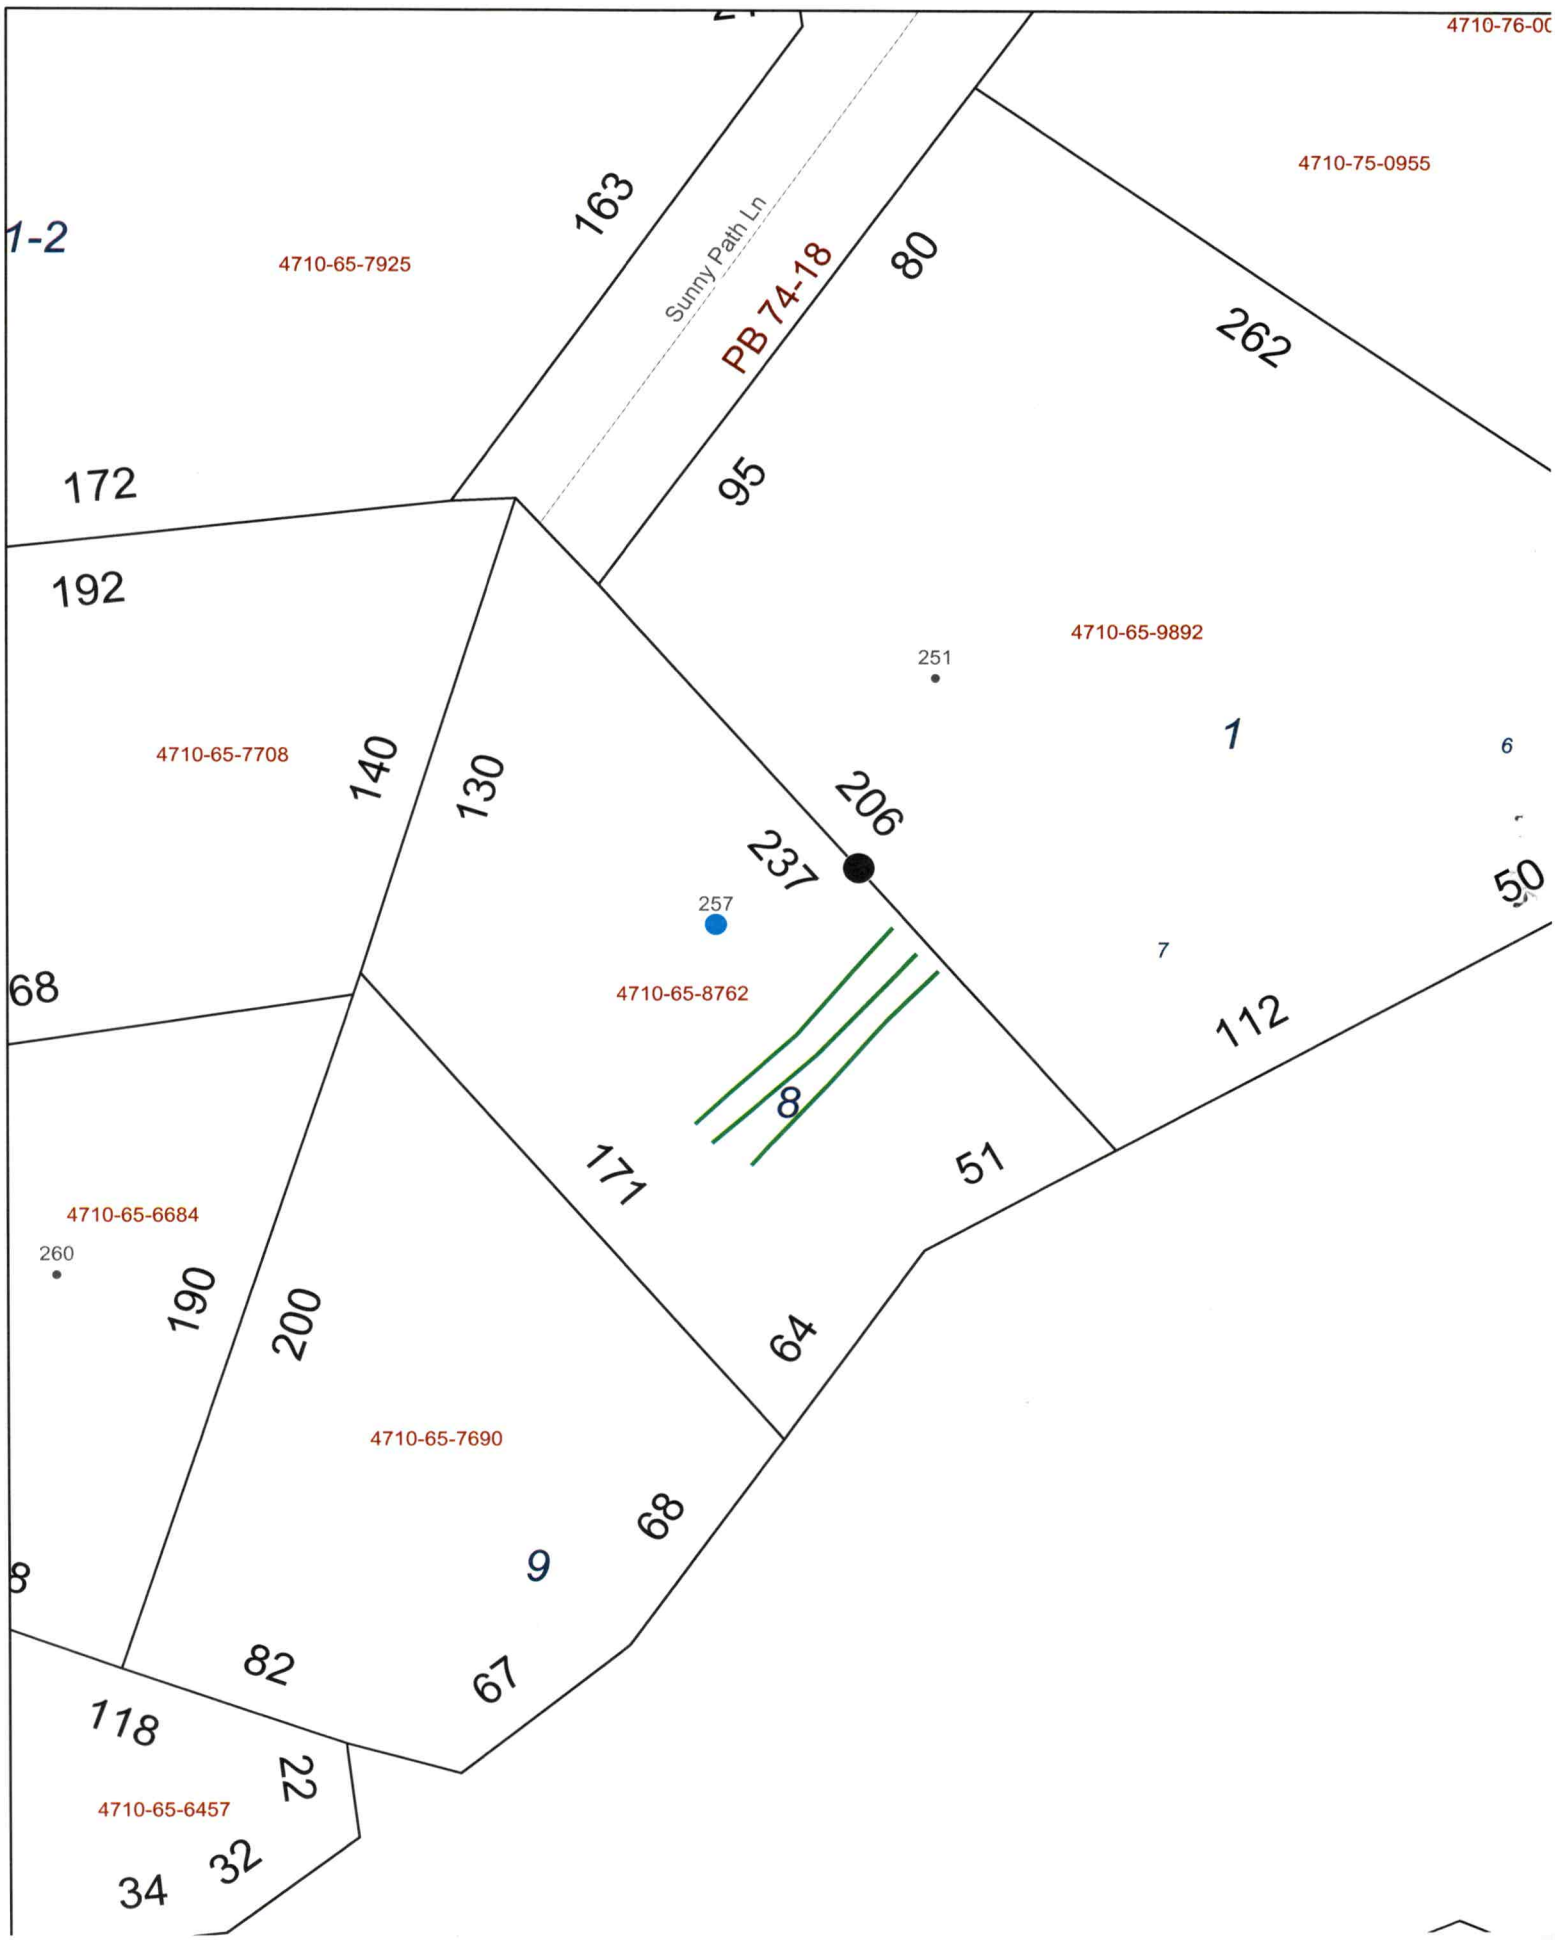
4710-76-0(
4710-75-0955
1-2
4710-65-7925
163
Sunny Path Ln
PB 74-18
80
262
172
95
192
4710-65-9892
251
4710-65-7708
140
130
206
237
1
6
257
50
68
4710-65-8762
7
112
8
171
51
4710-65-6684
260
190
200
64
4710-65-7690
9
68
82
67
118
22
4710-65-6457
32
34



IREDELL COUNTY NC

MAP FOR REFERENCE ONLY
NOT A LEGAL DOCUMENT

Iredell County, North Carolina makes no claims and no warranties, expressed or implied, concerning the validity or accuracy of the GIS data presented on this map.

Print map scale is approximate. Critical layout or measurement activities should not be done using this resource.