C1

IREDELL COUNTY HEALTH DEPARTMENT

STATESVILLE 704-878-5305 MOORESVILLE 704-664-5281

IMPROVEMENT PERMIT / AUTHORIZATION TO CONSTRUCT / OPERATION PERMIT / EXISTING SYSTEM INSPECTION

PERMIT# 142218 PIN# 4710658762 DATE 6-8-7

OWNER OR APPLICANT Richard & Julie Viglione PHONE: Business 704 528 1412 Home

ADDRESS 257 Sunny Path Lane

LOCATION Pinoville, Rd, 15 on Sunny Path - just west of E. Monbo; site at end on left

SUBDIVISION Setzer Est BLOCK / SECTION LOT 8 LOT AREA .52 SITE CLASS. PS DESIGN FLOW 360 L.T.A.R. .4

Septic Tank: 1000 Gallons: STB Akrad-STB1007 Date 6-25-07

Pump Tank: Gallons: PT Date

Pump Make: Model Serial No.

Nitrification Field: No Fields 1 Square Feet 900 Linear Feet 225

No Lines 3 Trench Width 36" Max Trench Bottom Depth 36" Gravel Depth

☒ New System ☐ Repair ☐ Expansion System Type: I (II) III IV V VI

System Description: 25% Reduction Gravity

Repair System Description: 50% Reduction LP

Maintenance Agreement Required: ☐ Yes ☒ No

☒ Gravity ☐ Pressure

☒ House/Mod. Home No. Bedrooms 3

☐ Mobile Home No. Persons

☐ Business No. Employees

☐ Other


☐ Slab ☐ Crawl Space ☒ Basement w/plumbing ☐ Basement wo/plumbing

Water Supply: ☒ Individual ☐ Public ☐ Community


Comments:/Conditions: Could not locate any permits for lot 7 despite lot being intermittantly flagged

Comments:/Conditions: Tank Has Riser; Filter; MARKER House not built at this time.

INITIAL SITE SKETCH

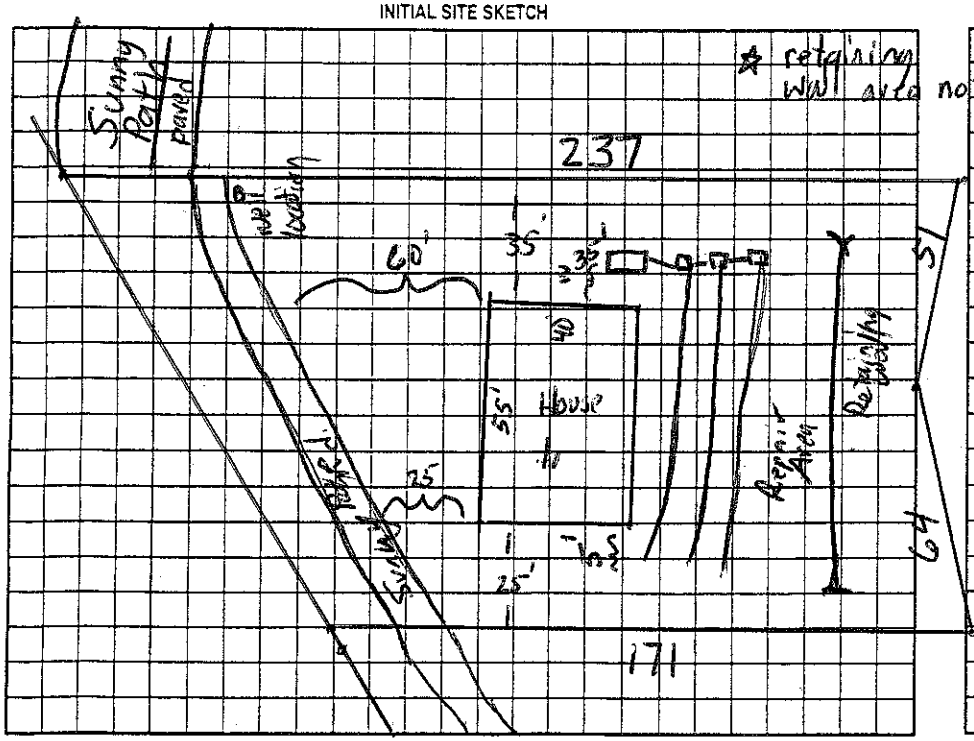

AS BUILT SKETCH

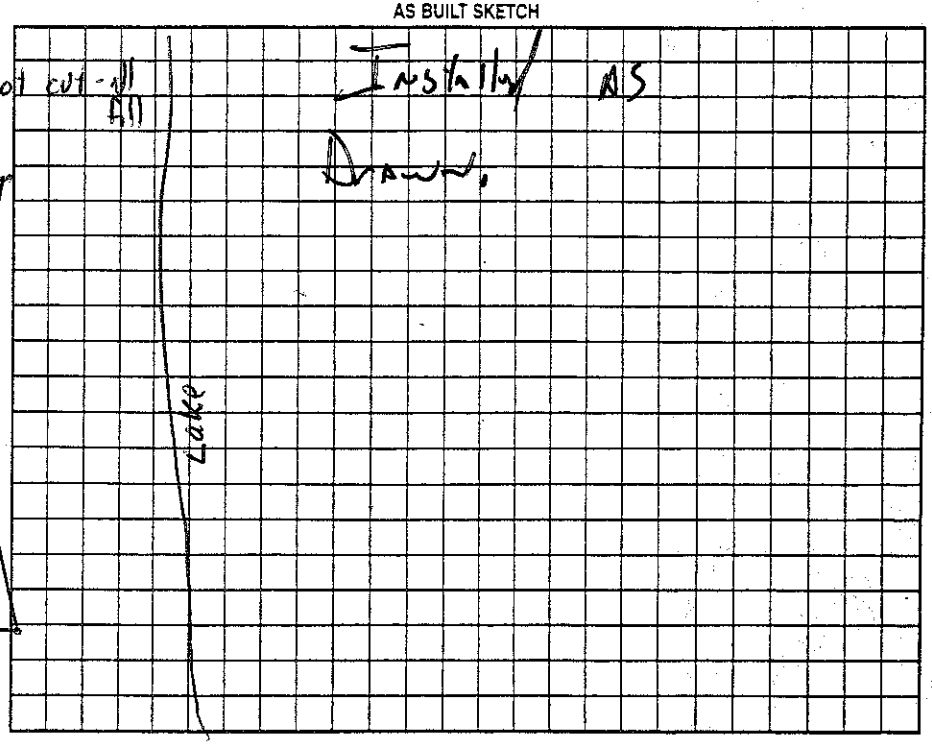

Permit can be suspended or revoked if any false information is supplied toward securing the permit/any unauthorized changes are made to the site/any unauthorized changes are made in the installation of the system. Improvement Permit with plat valid without expiration ☐ Improvement Permit with site plan valid for sixty months ☐ Authorization to Construct is valid for a period equal to that of Improvement Permit – not to exceed sixty months.

Signed: Julie Viglione date 6-8-07

Improvement Permit by: James Wagner date 6-8-7

Authorization to Construct by: James Wagner date 6-8-7

Installed by: Gpal Construction

Operation Permit by: Dan Nuggett, P.S. date 16 Aug 07

Existing System Inspection by: date

HEALTH DEPT. COPY: WHITE OWNER COPY (FINAL): YELLOW OWNER COPY (INITIAL): PINK