IREDELL COUNTY HEALTH DEPARTMENT

Statesville Phone TR 3-7271 Mooresville Phone NO 3-1271

PERMIT TO INSTALL SEPTIC TANK

Permit No. 252 Permit Date _____ 19__

Owner Gene Foy Address Stony Point

Installed By Raymond Adams Address Hiddenite


Location of Property Turn Left 2nd Rd past Kiles X Rd go To First paved Rd To Rt Go to end of Rd Turn Left house on left next to end

Tank		Capacity		Length of Lines		Fixtures	
Block	( )	1000	( )	225'	( )	No. of Baths	(3)
Precast	(✓)	1250	(✓)	250'	( )	Dishwasher	(✓)
		1500	( )	Other 270		Garbage Grdr.	(✓)
		Other _____				Other _____	

NOTIFY HEALTH DEPARTMENT AT LEAST EIGHT HOURS BEFORE TANK IS TO BE INSPECTED.

Final Inspection Oct 15 1971 Approved ( ) Disapproved ( )

Remarks

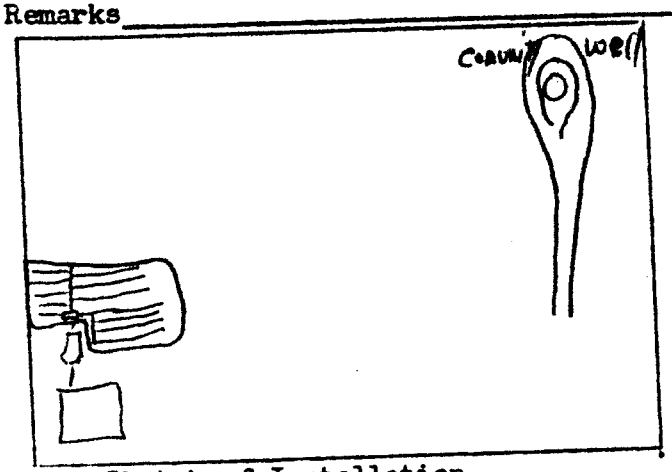

Sketch of Installation

Not checked

C. S. H.

Sanitarian