IREDELL COUNTY HEALTH DEPARTMENT

Statesville Phone TR 3-7271 Mooresville Phone No. 664-5281

PERMIT TO INSTALL SEPTIC TANK

Permit No. _____ Permit Date 10-10 1972

Owner Gary Dyson Address Statesville, NC

Installed By Robert Hoke Address Statesville, NC.

Location of Property Spring Shores Development


Lot No. # 32

Tank		Capacity		Length of Lines		Fixtures	
Block	( )	1000	( )	225'	( )	No. of Baths	(2)
Precast	(✓)	1250	(✓)	250'	( )	Dishwasher	(1)
		1500	( )	Other 255		Garbage Grdr.	(1)
		Other				Other	

NOTIFY HEALTH DEPARTMENT AT LEAST EIGHT HOURS BEFORE TANK IS TO BE INSPECTED.

Final Inspection _____ 19__ Approved (✓) Disapprcved ( )

Remarks Community Water Supply

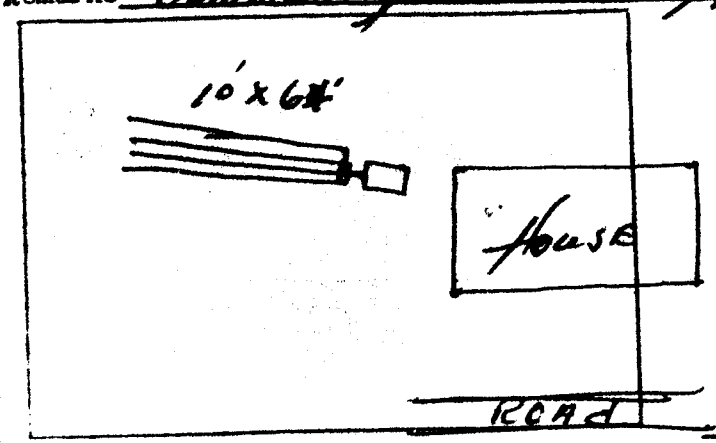

Sketch of Installation

Sanitarian