IREDELL COUNTY HEALTH DEPARTMENT

STATESVILLE 704-878-5305 CI MOORESVILLE 704-664-5281

IMPROVEMENT PERMIT / AUTHORIZATION TO CONSTRUCT / OPERATION PERMIT / EXISTING SYSTEM INSPECTION

PERMIT# 116647 PIN# 4710-66-5364 DATE 8-4-05

OWNER OR CONTRACTOR JANET BENTLY PHONE: Business 704 791-0952 Home 704 883-9490

ADDRESS 53 Miles Circle Apt Q MOORESVILLE, NC 28117

LOCATION 215 @ OOR @ EAST MUNSD @ Pinewild @ Spring Stone @ AT LOT #30

SUBDIVISION SPRING STONE BLOCK / SECTION LOT 30 LOT AREA 1.00AC SITE CLASS. PS DESIGN FLOW 240 L.T.A.R. 135

Septic Tank: 1000 Gallons; STB 325 Date 2-22-06
Pump Tank: Gallons; PT Date
Pump Make: Model Serial No.
Nitrification Field: No Fields 1 Square Feet 685 Linear Feet 175'
No Lines 4 Trench Width 36" Max Trench Bottom Depth 36" Gravel Depth N/A

☒ New System ☐ Repair System Type: I, II, ☒ III, IV, V, VI
System Description: 6 RAW 25% REDUCT
Repair System Description: MAX FEASIBLE / PUMP UNDER PRESSURE
Maintenance Agreement Required: ☐ Yes ☒ No


☒ House/Mod. Home No. Bedrooms 2
☐ Mobile Home No. Bathrooms 1
☐ Business No. Employees
☐ Other
☐ Slab ☐ Crawl Space ☒ Basement w/plumbing ☐ Basement wo/plumbing

Water Supply: ☒ Individual ☐ Public ☐ Community


Comments/Conditions: ① DECK EXTENDS 5' OFF HOUSE. IT IS CANTILEVER SO 5' SETBACK IS OFF HOUSE & NOT DECK. ② DIVERT SURFACE H2O AWAY FROM SYSTEM & FILL & PACK OLD ROAD BED. THIS WILL help Stabilize the hill

Comments/Conditions: due to 28% SLOPE. ③ F:U & PACK LOWER WAS NOT ④ MAINTAIN SETBACKS ⑤ THIS IS A SAPROLITE SYSTEM ⑥ THIS IS A REDRAW DUE TO COMM. WELL NOT BEING AVAILABLE

INITIAL SITE SKETCH 1" = 60'

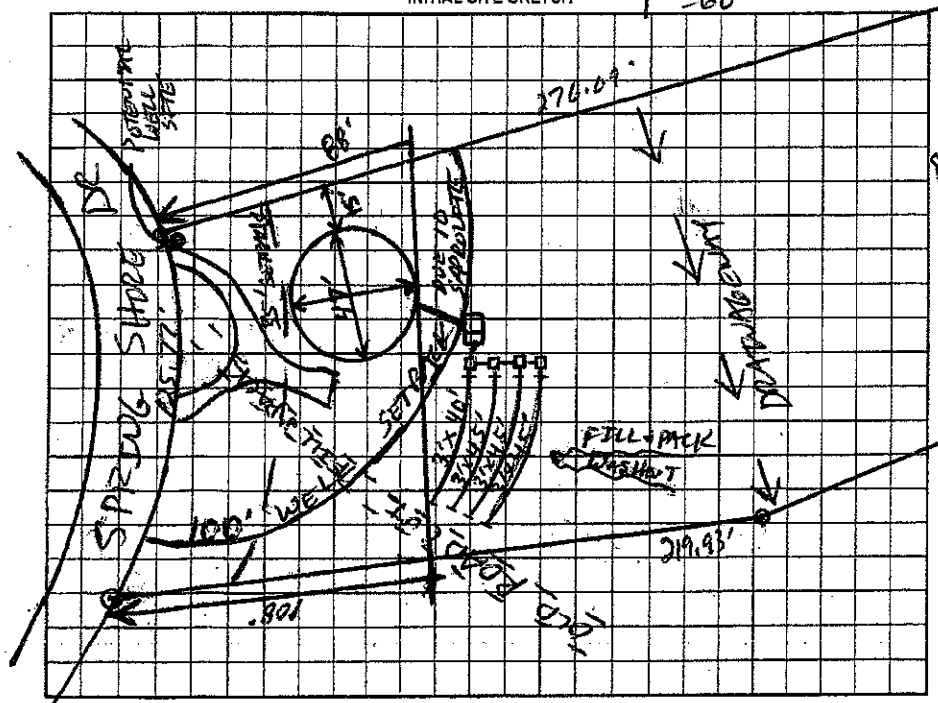

AS BUILT SKETCH

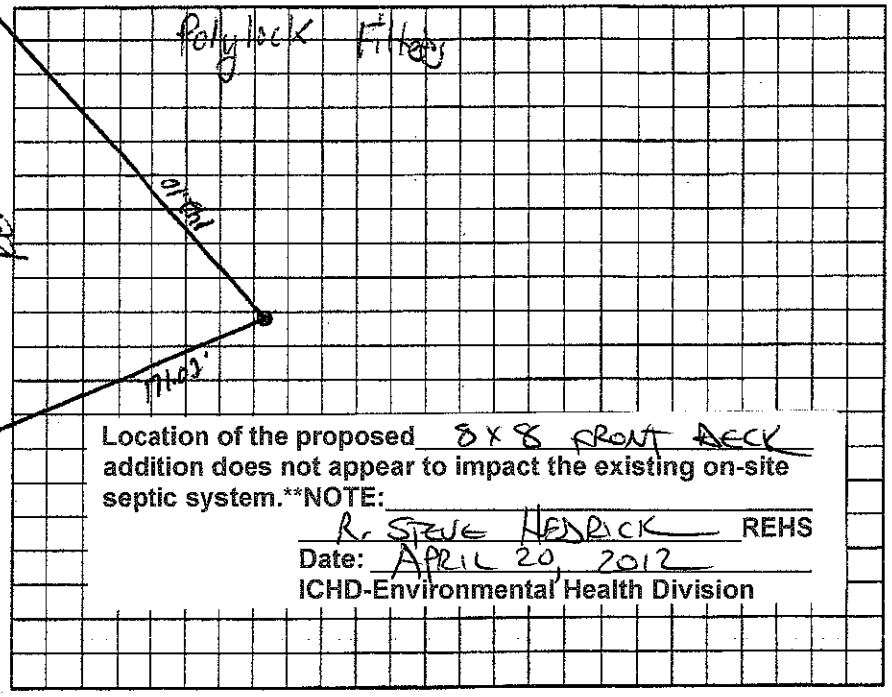

Location of the proposed 8 X 8 FRONT DECK addition does not appear to impact the existing on-site septic system.**NOTE:

R. STEVE HENDRICK REHS
Date: APRIL 20, 2012
ICHD-Environmental Health Division

Permit can be suspended or revoked if any false information is supplied toward securing the permit/any unauthorized changes are made to the site/any unauthorized changes are made in the installation of the system. Improvement Permit with plat valid without expiration. Improvement Permit with site plan valid for sixty months. Authorization to Construct is valid for a period equal to that of Improvement Permit – not to exceed sixty months.

Signed: Janet E Bentley date 8/11/05 Installed by: Kowa Septic

Improvement Permit by: date 8-9-05 Operation Permit by: date 3-29-06

Authorization to Construct by: date 8-9-05 Existing System Inspection by: date

HEALTH DEPT. COPY: WHITE OWNER COPY (FINAL): YELLOW OWNER COPY (INITIAL): PINK