IREDELL COUNTY HEALTH DEPARTMENT

STATESVILLE 704-878-5305 MOORESVILLE 704-664-5281

IMPROVEMENT PERMIT / AUTHORIZATION TO CONSTRUCT / OPERATION PERMIT / EXISTING SYSTEM INSPECTION

PERMIT# 20402 PIN# 4710-67-2075 336-414-1975 TY HERLELL DATE 11-10-04

OWNER OR CONTRACTOR Stephanie Miller PHONE: Business 336-414-2257 HERLELL Home 336-519-2297

ADDRESS 4415 QUAIL HOLLOW RD CLEMMONS, NC 27012

LOCATION BUFFALOSHOALS WEST (L) PINEVILLE RD (R) SPRING SHORE LOT # 33 ON LEFT

SUBDIVISION SPRING SHORE BLOCK / SECTION ____ LOT 33 LOT AREA ____ SITE CLASS. PS DESIGN FLOW 480 L.T.A.R. .4

Septic Tank: 1000 Gallons; STB 1012 Date 2-17-04
Pump Tank: ____ Gallons; PT ____ Date ____
Pump Make: ____ Model ____ Serial No. ____
Nitrification Field: No Fields 1 Square Feet EQ=1000# Linear Feet 200'
No Lines 5 Trench Width 24" Max Trench Bottom Depth 36-48" Gravel Depth N/A

☒ New System ☐ Repair System Type: I, II, (III) IV, V, VI
System Description: 6 PAD SOLOFLO PRODUCT
Repair System Description: MAX FEASIBLE / NO PUMP NEEDED
Maintenance Agreement Required: ☐ Yes ☒ No

☒ House/Mod. Home ☐ Mobile Home ☐ Business ☐ Other
No. Bedrooms 4 No. Bathrooms 2 No. Employees ____


☐ Slab ☐ Crawl Space ☒ Basement w/plumbing ☐ Basement wo/plumbing

Water Supply: ☒ Individual ☐ Public ☐ Community WELL

Comments:/Conditions: (1) LOT DEEDED ~~OCTOBER~~ 31, 1970. NO REPAIR NEEDED + SEPTIC CAN BE 5' OFF P/L (2) FILL WASHOUTS + SMOOTH OUT HUMPS + BUMPS TO ESTABLISH CONTOURS + SYSTEM PLACEMENT AS DRAWN,

Comments:/Conditions: (3) CALL PRIOR TO INSTALLATION FOR PRE CONSTRUCTIVE VISIT (4) ALL ADJACENT LOTS, THAT WOULD HAVE A SETBACK TO THIS LOTS WELL + SEPTIC, HAVE BEEN V/D. NO VALID PERMITS FOUND OR IF HOMES ARE BUILT, SETBACKS HAVE BEEN MAINTAINED.

1"=50' INITIAL SITE SKETCH

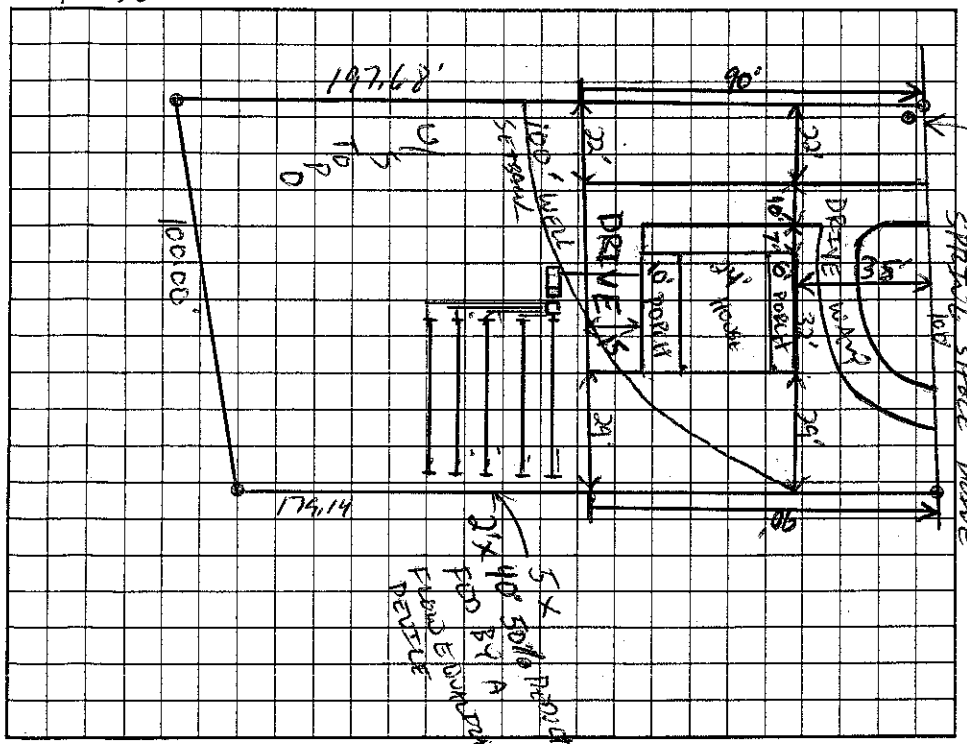

AS BUILT SKETCH

(5) THIS IS A SATELLITE SYSTEM. 100' TO WELL MUST BE MAINTAINED

(6) SURFACE H2O MUST BE DIVERTED AROUND THE SYSTEM 1456 5 + MUST ALSO MEET RULE 1456 5 (A) + (C)

- 'TUFF-TITE' FILTER W/ RISER AT LEAST 6" ABOVE GRADE
- 'SPACE INVADER' SEAL
- FLOW SPLITTER LEVEL
- X SYSTEM INSTALLED AS SHOWN
- X NOTE: WELL NOT INSTALLED AS OF 4-29-05

Permit can be suspended or revoked if any false information is supplied toward securing the permit/any unauthorized changes are made to the site/any unauthorized changes are made in the installation of the system. Improvement Permit with plat valid without expiration. Improvement Permit with site plan valid for sixty months. Authorization to Construct is valid for a period equal to that of Improvement Permit – not to exceed sixty months.

Signed: Tyrone L Miller date 11-10-04 Installed by: PIEDMONT BACKHOE

Improvement Permit by: [signature] date 11-10-04 Operation Permit by: Christopher M Sherrill RS,LSS date 4-29-05

Authorization to Construct by: [signature] date 11-10-04 Existing System Inspection by: ____ date ____

HEALTH DEPT. COPY: WHITE OWNER COPY (FINAL): YELLOW OWNER COPY (INITIAL): PINK