IREDELL COUNTY HEALTH DEPARTMENT

Statesville Phone TR 3-7271 Mooresville Phone NO 3-1271

PERMIT TO INSTALL SEPTIC TANK

Permit No. 77 Permit Date Jan 27 1972

Owner Dean Fay Address Statesville N.C

Installed By Retail Hoke Address " "


Location of Property Lot # 78 Spring Shore on Lake Norman

Tank		Capacity		Length of Lines		Fixtures	
Block	( )	1000	( )	225'	( )	No. of Baths	(3)
Precast	(✓)	1250	(✓)	250'	( )	Dishwasher	(✓)
		1500	( )	Other 275		Garbage Grdr.	(✓)
		Other				Other	

NOTIFY HEALTH DEPARTMENT AT LEAST EIGHT HOURS BEFORE TANK IS TO BE INSPECTED.

Final Inspection Jan 27 1972 Approved (✓) Disapproved ( )

Remarks

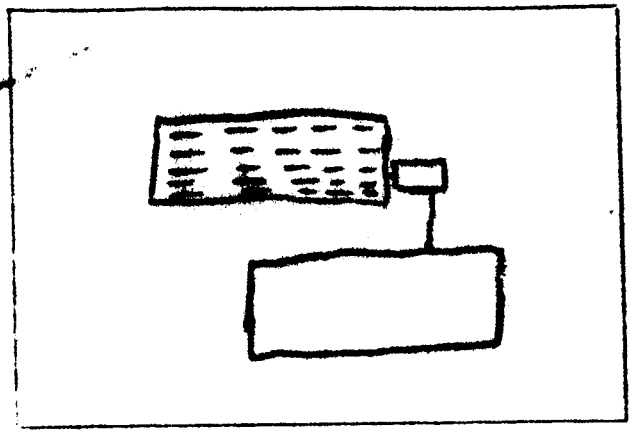

Sketch of Installation

R. W. Johnson RS

Sanitarian