IREDELL COUNTY HEALTH DEPARTMENT - *ENVIRONMENTAL HEALTH* ☐ STATESVILLE OFFICE 704-878-5305 ☐ MOORESVILLE OFFICE 704-664-5281

IMPROVEMENT PERMIT / AUTHORIZATION TO CONSTRUCT / OPERATION PERMIT / EXISTING SYSTEM INSPECTION

PERMIT # Repair PIN # 4710-67-4672 DATE 27 July 2011

OWNER Jaji Boyce APPLICANT: PHONE: Home/Cell # (704) 528-9416 Business #

SITE ADDRESS 133 Mimosa Rd. Statesville OWNER / APPLICANT ADDRESS

SITE DIRECTIONS Old Mtn. Rd. Turn onto EAST Monbo TR Pineville TL Spring Shore TR Plum Tree TL Mimosa 3rd on left.

SUBDIVISION Spring Shore BLOCK / SECTION LOT # 74875 LOT AREA 0.4 Ac - DESIGN FLOW 360 g/d L.T.A.R. Exist.

* Septic Tank 1000 Gallons: STB 760 Date 4-25-11 | ☐ New System ☑ Repair ☐ Expansion System Type I (II) III IV V VI | ☑ Residence No. Bedrooms 3 | Water Supply

Pump Tank ____ Gallons: P T ____ Date ____ | System Description: ____ | ☐ Business No. Persons ____ | ☐ Private

Pump Make ____ Model ____ Serial # ____ | Repair System Description: Septic tank Replacement | ☐ Other No. Employees ____ | ☐ Public


No. Nitrification Fields: ____ No. Lines ____ Linear Feet ____ | Maintenance Agreement Required ☐ YES ☑ NO | ☐ Slab ☐ Crawl Space | ☑ Community

Trench Width ____ Max. Trench Bottom Depth ____ Gravel Depth ____ | ☑ GRAVITY ☐ PRESSURE | ☑ Basement w/plumbing ☐ Basement w/o plumbing

Comments / Conditions * Replace old of Septic tank (caved-in) with New (100) gal. Property Abandon old tank

SEPTIC TANK WITH RISERS INSTALLED USING RED "POLYLOK" FILTER

INITIAL SITE SKETCH

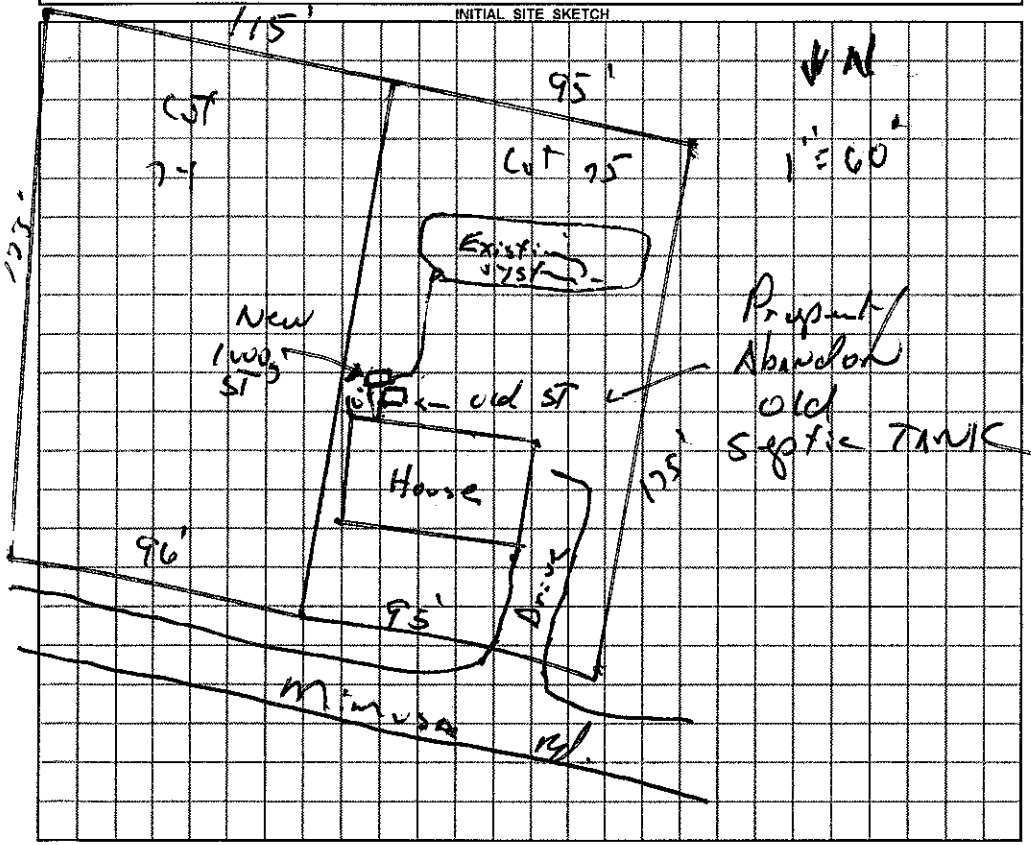

AS BUILT SKETCH

SEPTIC TANK REPLACED ACCORDING TO INITIAL SITE SKETCH

Permit can be suspended or revoked if any false information is supplied toward securing the permit / any unauthorized changes are made to the site / any unauthorized changes are made in the installation of the system.

☐ *IMPROVEMENT PERMIT with plat valid without expiration.* ☑ *IMPROVEMENT PERMIT with ~~plat valid without expiration.~~ site plan valid 60 mo.* ☑ *AUTHORIZATION TO CONSTRUCT* valid for period equal to IMPROVEMENT PERMIT—not to exceed 60 mo.

Owner / Applicant Signature: ____ Date 7-28-11 Installed by: JARED LENTZ

IMPROVEMENT PERMIT by: ____ REHS Date 27-July-11 OPERATION PERMIT by: STEVE HENDRICK REHS Date 8-2-11

AUTHORIZATION TO CONSTRUCT by: ____ REHS Date 27-July-11 Existing System Inspected by: ____ REHS Date ____

YOU SHOULD CONTACT A LOCATOR SERVICE PRIOR TO ANY EXCAVATION

White Copy – Environmental Health YELLOW COPY (Final) Owner / Applicant PINK COPY (Initial) Owner / Applicant