IREDELL COUNTY HEALTH DEPARTMENT

Statesville Phone TR 3-7271 Mooresville Phone NO 3-1271

PERMIT TO INSTALL SEPTIC TANK

Permit No. 117 Permit Date 9 / 19 22

Owner Joe Graham Address Statesville No #4

Installed By Robert Holt Address Statesville NC

Location of Property Sharon Church & Plank Road

to left of Rev T.B. Thompson Lot Hendersonville


Lot # 21

Tank		Capacity		Length of Lines		Fixtures	
Block	( )	1000	(✓)	225'	( )	No. of Baths	(1)
Precast	(✓)	1250	( )	250'	( )	Dishwasher	( )
		1500	( )	Other 186'		Garbage Grdr.	( )
		Other				Other	

NOTIFY HEALTH DEPARTMENT AT LEAST EIGHT HOURS BEFORE TANK IS TO BE INSPECTED.

Final Inspection 9-1 1922 Approved (✓) Disapproved ( )

Remarks Community Well

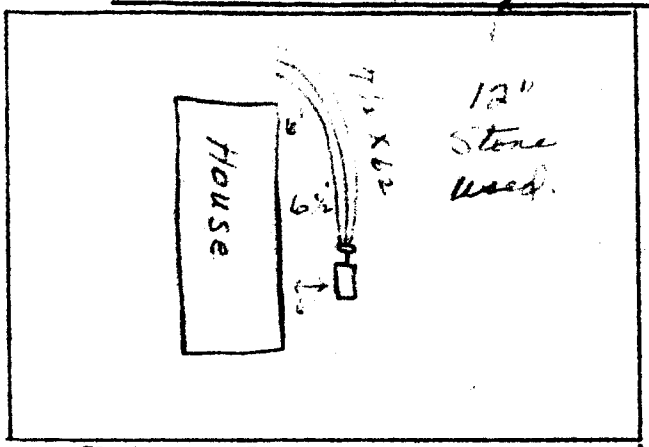

Sketch of Installation

Lines are short due to lay of lot. Tank & lines are closer than 10' to house. Best lay out possible. Soil good.

E. A. Stevenson

Sanitarian