IREDELL COUNTY HEALTH DEPARTMENT

Statesville Phone TR 3-7271 Mooresville Phone No. 664-5281

PERMIT TO INSTALL SEPTIC TANK

Permit No. 336 Permit Date 5-1 1973

Owner Ricky Dyson Address Statesville N.C.

Installed By Robert Hoke Address Statesville N.C.

Location of Property

Spring Shores Lot #64


House on main Road on R.

Tank		Capacity		Length of Lines		Fixtures	
Block	( )	1000	( )	225'	( )	No. of Baths	(3)
Precast	(✓)	1250	(✓)	250'	( )	Dishwasher	(✓)
		1500	( )	Other 270		Garbage Grdr.	(✓)
		Other				Other	

NOTIFY HEALTH DEPARTMENT AT LEAST EIGHT HOURS BEFORE TANK IS TO BE INSPECTED.

Final Inspection 5-1 1973 Approved (✓) Disapproved ( )

Remarks Community Water

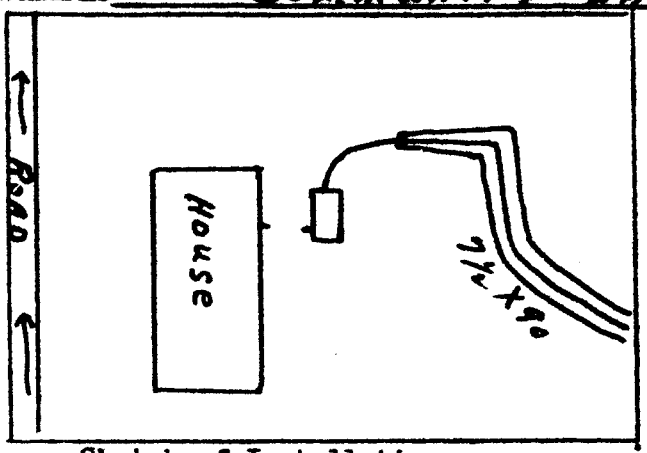

Sketch of Installation

E. G. Stevenson

Sanitarian