IREDELL COUNTY HEALTH DEPARTMENT

Statesville Phone TR 3-7271 Mooresville Phone NO 3-1271

PERMIT TO INSTALL SEPTIC TANK

Permit No. 5 Permit Date 10-17 1972

Owner Gary Dyson Bldr. Address

Installed By Robert Hoke Address Statesville N.C.


Location of Property Spring Shores
Lot # 96

Tank		Capacity		Length of Lines		Fixtures	
Block	( )	1000	( )	225'	( )	No. of Baths	(3)
Precast	(✓)	1250	(✓)	250'	( )	Dishwasher	(1)
		1500	( )	Other 260		Garbage Grdr.	( )
		Other				Other	

NOTIFY HEALTH DEPARTMENT AT LEAST EIGHT HOURS BEFORE TANK IS TO BE INSPECTED.

Final Inspection 10-17 1972 Approved (✓) Disapproved ( )

Remarks Community Water

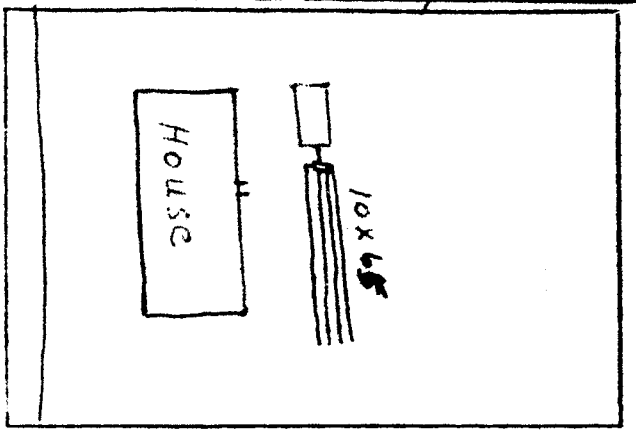

Sketch of Installation

Layout approved by Mr R. W. Johnson. Builder to send in letter accepting responsibility for 5 years. Lines are over 6' deep due to lay of lot.
Soil in bottom of ditch is good.

E. G. Stevenson
Sanitarian