IREDELL COUNTY HEALTH DEPARTMENT

Statesville Office (704) 878-5305 Mooresville Office (704) 660-3625 PERMIT # 205048

IMPROVEMENT PERMIT / AUTHORIZATION TO CONSTRUCT / OPERATION PERMIT / EXISTING SYSTEM

PIN # 4710-68-0084

APPLICANT: Don Chapman APPLICANT ADDRESS: 1411 Reynolda Rd Winston Salem

SITE ADDRESS: 154 Mimosa Rd - Stat 28677 PHONE: 202-498-0264 ALT. PHONE: N/A


SITE DIRECTIONS: Buffalo Shoals Rd TL Pineville TR Spring Shore TR Palm Tree TL Mimosa

SUBDIVISION: Spring Shore SECTION: N/A LOT # 87 LOT AREA: 0.15 acres DESIGN FLOW: 360gpd L.T.A.R.: Existing


Septic Tank	1000	(gal)	STB	760-1000	Date	6-29	☐ New System	☑ Repair	☐ Expansion	System Type: I (II) III IV V VI	☑ Residence	No. Bedrooms	3	Water Supply	
Pump Tank		(gal)	PT		Date		System Description:				☐ Business	No. Persons	6	☐ Private	
Pump Make		Model			Serial #		Repair System Description:	TANK			☐ Other	No. Employees		☐ Public	
# Nitrification Fields	EX	# Lines	EX		Linear Ft:	EX.	Maintenance Agreement Required:	☐ YES	☑ NO		☐ Slab	☐ Crawl Space		☑ Community	
Trench Width	EX	Max. Trench Bottom Depth	EX		Gravel Depth	EX		☑ GRAVITY	☐ PRESSURE		☑ Basement w/plumbing		☐ Basement w/o plumbing		

Comments / Conditions: Pump + Crush existing septic tank. Install New septic tank at location shown below, and connect to existing drainfield. Install risers if septic tank will be deeper than 6" below grade. Install a Traffic Rated septic tank if deeper than 36" below grade.

INITIAL SITE SKETCH

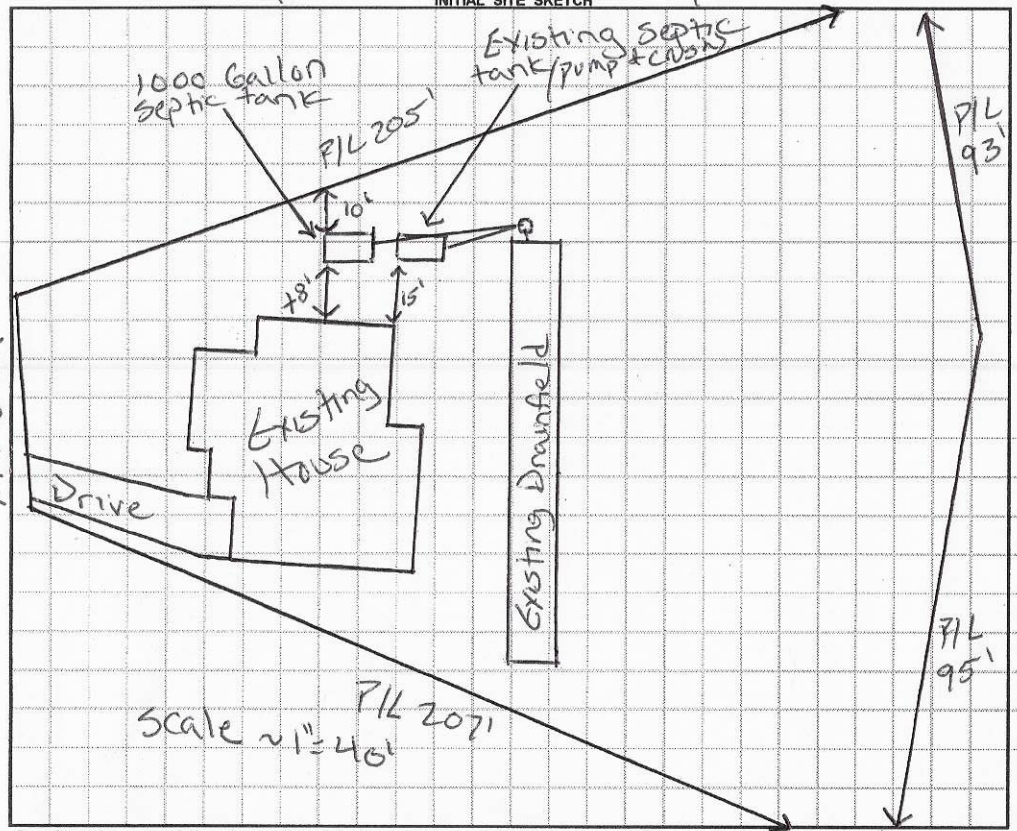

AS BUILT SKETCH

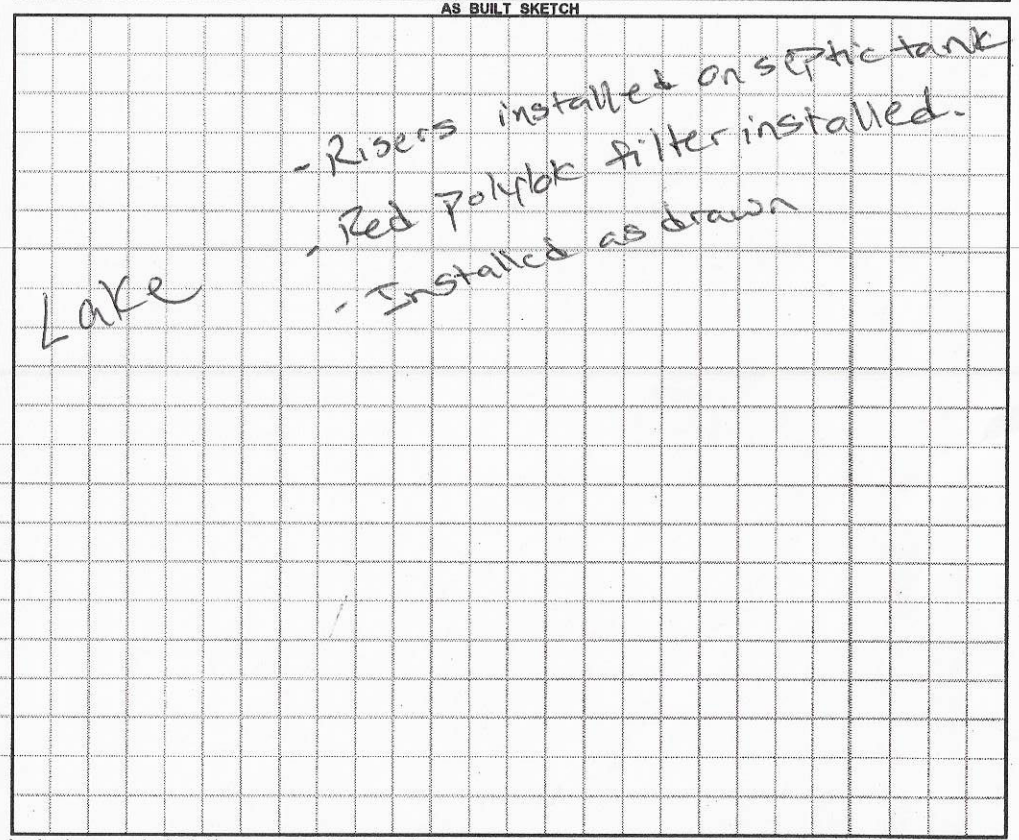

Permit can be suspended or revoked if any false information is supplied toward securing the permit / any unauthorized changes are made to the site / any unauthorized changes are made in the installation of the system. **CONTACT A LOCATOR SERVICE PRIOR TO ANY EXCAVATION**

☐ **IMPROVEMENT PERMIT** *with plat valid without expiration.* ☑ **IMPROVEMENT PERMIT** *with site plan valid for 60 mos.* ☑ **AUTHORIZATION TO CONSTRUCT** *valid for period equal to IMPROVEMENT PERMIT--not to exceed 60 mo.*

Owner / Applicant Signature: [signature] Date: 8-11-14 Installed by: Lentz Septic

IMPROVEMENT PERMIT by: Justin Henderson Date: 8-8-14 OPERATION PERMIT by: Justin Henderson Date: 8-25-14

AUTHORIZATION TO CONSTRUCT by: Justin Henderson Date: 8-8-14 Existing System Inspected by: Date:

Health Dept. Copy - WHITE Applicant (Final Approval) - YELLOW Applicant (Conditional Approval) - PINK