1:30

☒ STATESVILLE OFFICE 704-878-5305 ☐ MOORESVILLE OFFICE 704-664-5281

IREDELL COUNTY HEALTH DEPARTMENT - *ENVIRONMENTAL HEALTH*

IMPROVEMENT PERMIT / AUTHORIZATION TO CONSTRUCT / OPERATION PERMIT / EXISTING SYSTEM INSPECTION

DATE 10-10-11

PERMIT # 163127 PIN # 4710-68-1821 PHONE: Home/Cell # 336-577-5094 Business #

OWNER Arthur Yates APPLICANT: OWNER / APPLICANT ADDRESS 1540 Enterprise Road, Lexington, NC

SITE ADDRESS 123 River Ridge - Statesville, NC

SITE DIRECTIONS South on Bullhead Shoals, (L) on Laurel Cove, (L) on Island Terrace, (L) on River Ridge, lot on left

SUBDIVISION RIVER RIDGE BLOCK / SECTION LOT # 3 LOT AREA DESIGN FLOW L.T.A.R.

Septic Tank 1000 Gallons: STB 1017 Date 10-12-10

Pump Tank 1000 Gallons: P T 17 Date 3-15-10

Pump Make Geotech Model WOG-712-1 Serial #

No. Nitrification Fields: 1 No. Lines (4) (3) Linear Feet 300

Trench Width 36" Max. Trench Bottom Depth 36" Gravel Depth n/a

☒ New System ☐ Repair ☐ Expansion System Type I II (III) IV V VI

System Description: Pump 25% Reduction

Repair System Description: Pump in 50% Reduction

Maintenance Agreement Required ☐ YES ☒ NO

☐ GRAVITY ☒ PRESSURE


☒ Residence ☐ Business ☐ Other ☐ Slab ☒ Basement w/plumbing

No. Bedrooms 3 No. Persons No. Employees ☐ Crawl Space ☐ Basement w/o plumbing

Water Supply: ☒ Private ☐ Public ☐ Community

Comments / Conditions

INITIAL SITE SKETCH

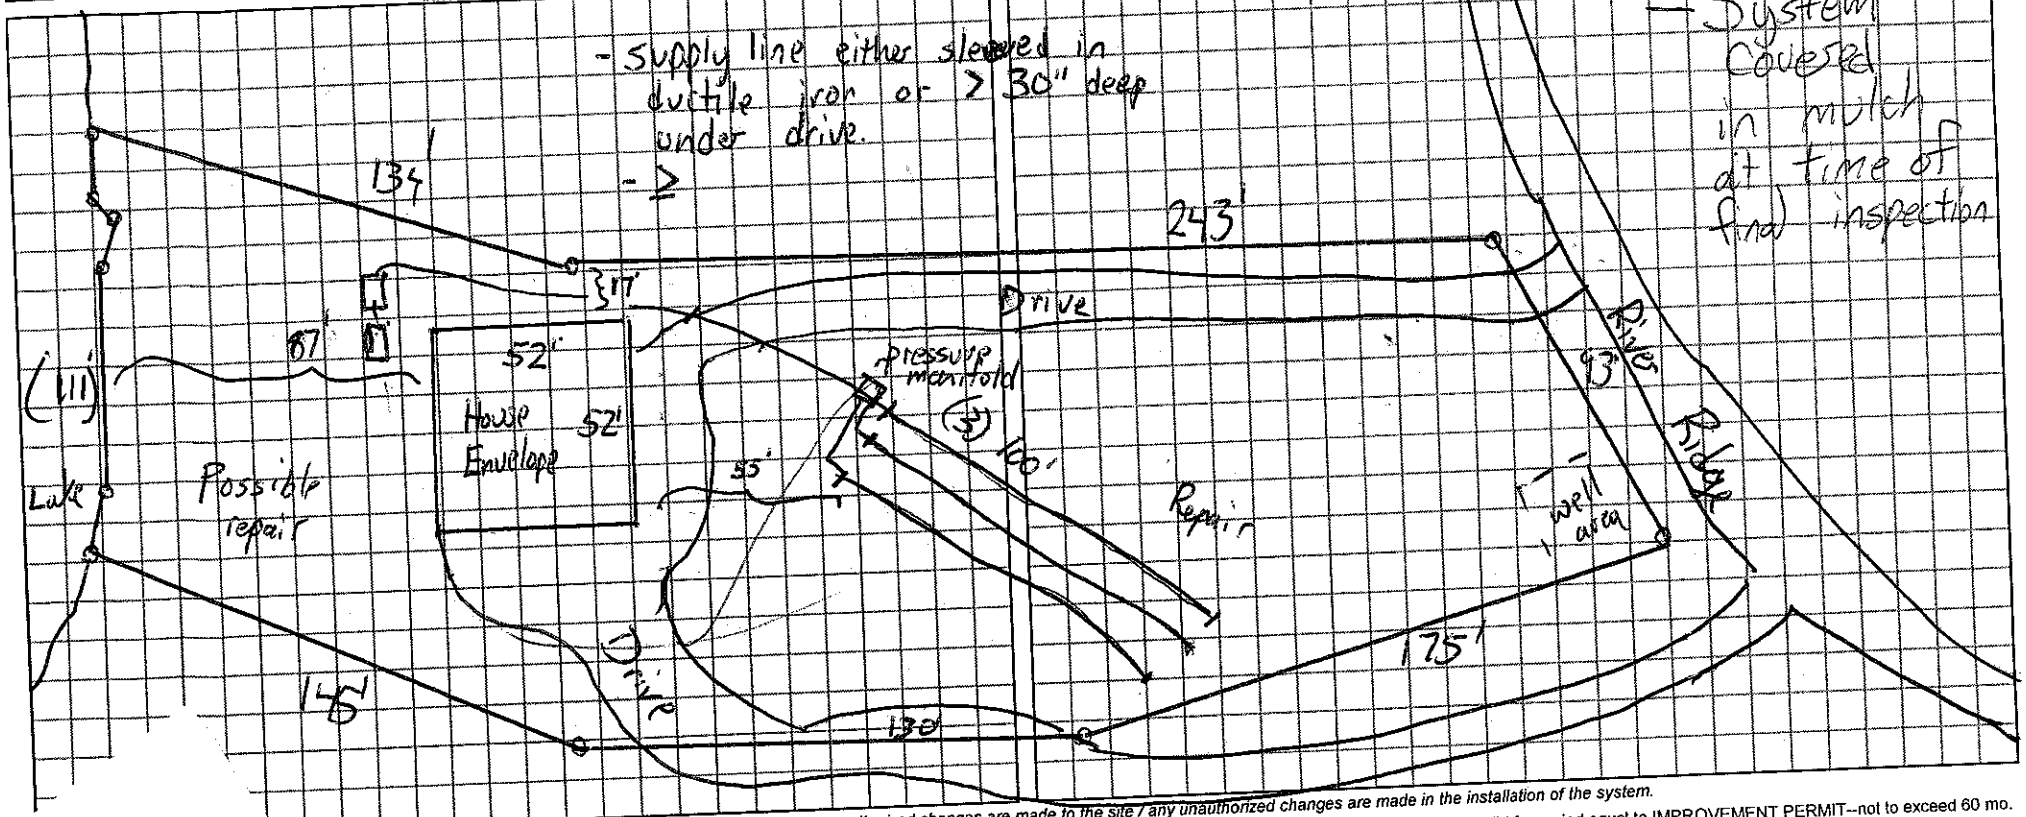

AS BUILT SKETCH

...oked if any false information is supplied toward securing the permit / any unauthorized changes are made to the site / any unauthorized changes are made in the installation of the system.

...th plat valid without expiration. ☒ IMPROVEMENT PERMIT with plat valid without expiration. site plan valid 60 mo. ☐ AUTHORIZATION TO CONSTRUCT valid for period equal to IMPROVEMENT PERMIT--not to exceed 60 mo.

Date 10-11-11 Installed by: Shane Groundbreakers

REHS Date 10-10-11 OPERATION PERMIT by: REHS Date 5-30-17

REHS Date 10-11-11 Existing System Inspected by: REHS Date

...CATOR SERVICE PRIOR TO ANY EXCAVATION

White Copy – Environmental Health YELLOW COPY (Final) Owner / Applicant PINK COPY (Initial) Owner / Applicant